

**FLOOD AND RIVERBANK EROSION  
RISK MANAGEMENT INVESTMENT PROGRAM (FRERMIP)  
PROJECT-1**

**ADB LOAN NO. 3138-BAN (SF) AND GRANT NO. 0396-BAN (EF)**

**CHAUHALI, ZAFFARGANJ, HARRIRAMPUR JULY 2016 MONITORING  
REPORT - DRAFT**

Prepared for:

**Bangladesh Water Development Board (BWDB)**  
Dhaka, Bangladesh

Prepared by:

**Institutional Strengthening and Project Management Consultant (ISPMC)**

**Joint Venture**  
**NORTHWEST HYDRAULIC CONSULTANTS LTD/EUROCONSULT MOTT MACDONALD**

July 2016



**Prepared by:**

Graeme Vass, EIT  
International Construction Advisor

Motiur Rahman  
River Engineer

**Reviewed by:**

Knut Oberhagemann, P. Eng.  
ISPMC Team Leader, Principal

**DISCLAIMER**

This report has been prepared by JV Northwest Hydraulic Consultants – Euroconsult Mott MacDonald for the benefit of the BANGLADESH WATER DEVELOPMENT BOARD (BWDB) for specific application to the FLOOD AND RIVERBANK EROSION RISK MANAGEMENT INVESTMENT PROGRAM (FRERMIP) PROJECT-1; ADB LOAN NO. 3138-BAN (SF) AND GRANT NO. 0396-BAN (EF). The information and data contained herein represent JV Northwest Hydraulic Consultants – Euroconsult Mott MacDonald best professional judgment in light of the knowledge and information available to JV Northwest Hydraulic Consultants – Euroconsult Mott MacDonald at the time of preparation, and was prepared in accordance with generally accepted engineering practices.

Except as required by law, this report and the information and data contained herein are to be treated as confidential and may be used and relied upon only by BANGLADESH WATER DEVELOPMENT BOARD (BWDB), its officers and employees. JV Northwest Hydraulic Consultants – Euroconsult Mott MacDonald denies any liability whatsoever to other parties who may obtain access to this report for any injury, loss or damage suffered by such parties arising from their use of, or reliance upon, this report or any of its contents.



## ACRONYMS

ADCP	: Acoustic Doppler Current Profiler
BWDB	: Bangladesh Water Development Board
FRERMIP	: Flood and Riverbank Erosion Risk Management Investment Program
JMREMP	: Jamuna Meghna River Erosion Mitigation Project
LWL	: Low Water Level

## TABLE OF CONTENTS

ACRONYMS .....	I
TABLE OF CONTENTS .....	II
LIST OF TABLES .....	II
1 INTRODUCTION.....	4
1.1 Monitoring Survey Components.....	4
2 JULY MONITORING SURVEY WORKS.....	5
2.1 Surveys Details .....	5
2.1.1 Bathymetric Survey Details.....	5
2.1.2 Topographic Survey Details .....	6
2.2 Jamuna and Padma Flows and Float Tracks.....	6
2.3 ADCP Measurements .....	6
3 RESULTS AND CONCLUSIONS .....	6
3.1 Water Level .....	6
3.2 ADCP Discharge.....	6
3.3 Near Bank Velocity.....	7
3.4 Launching of Geo-Textile Bag Revetment.....	7
3.4.1 Harrirampur .....	7
3.4.2 Zaffarganj .....	7
3.4.3 Chauhali .....	7
3.5 Recommendations .....	8
3.5.1 Adaptation Works.....	8
3.5.2 Multi-Beam Requirements.....	8

## LIST OF TABLES

Table 1. Key locations for full river bathymetric survey.....	5
Table 2. Bathymetric survey details for all FRERMIP sites .....	5
Table 3. Geo-textile bags required for adaptive works.....	8



## 1 INTRODUCTION

Under the Flood and Riverbank Erosion Risk Management Investment Program (FRERMIP) managed by the Bangladesh Water Development Board (BWDB) three (3) priority sites along the Jamuna River have been selected to receive comprehensive erosion protection works under Tranche 1 of the project. From upstream to downstream the sites are Chauhali (7 km of bank and scour protection), Zaffarganj (2 km of bank and scour protection), and Harirampur (10 km of bank and scour protection). These bank protection works include a geobag apron to protect the bank from scour, temporary geobag bank protection to mitigate potential erosion caused by the 2016 monsoon, and concrete block bank protection to provide long term erosion protection (construction to begin in 2017). Details of these protective works designs have been provided in previous design memos prepared by Northwest Hydraulic Consultants (NHC) (Harirampur - NHCa, 2016; Zaffarganj - NHCb, 2016; Chauhali – NHCc, 2016).

The joint venture of NHC and Euroconsult Mott MacDonald (EMM) has been tasked with providing advice and support to BWDB in construction supervision and quality control related activities associated with geobag placement along the falling aprons and temporary bank protection.

### 1.1 Monitoring Survey Components

In order to assess the efficacy of the constructed works over the course of the monsoon Monitoring surveys will be required at the three FRERMIP sites once per month for July, August, September and October with one monitoring survey being conducted at the JMREMP sites in September. The survey work consisted of the following:

1. Bathymetric survey, consisting of 250 m wide cross sections spaced every 200 m along the constructed bank length. If a change in toe elevation of more than 3 m was measured along a section of the apron from the preceding survey, additional sections spaced 50 m apart were measured along the 200 m spaces both upstream and downstream of the lowered cross section.
2. ADCP transects and float tracking were conducted at 5 locations (Figure A.1) in order to determine the discharge and proportion of flow associated with each channel. An additional 3 transects were measure at each site with locations shown in the Interim Construction Completion Drawing Packages for all sites. This data will be critical for further developing the relationship between the designed protection works, measured scour, water velocities located along the geo-bags and the associated flow.

In addition a full river cross section bathymetric survey will be conducted in late August at the key location discussed in Table 1 to provide a clear overview of the current river morphology through this reach and site conditions during the dry season 2016/17. The information will then be used for determining adaptation works not only at the three FRERMIP sites, but also the two JMREMP sites. This data will also provide a clearer picture of future river trends and which bank areas are at highest risk of large scale erosion. A more detailed understanding of the rivers morphology will also assist in providing refined approach to future bank protection works ie. Tranche 2 works.

**Table 1.** Key locations for full river bathymetric survey.

Location	Rationale
Bifurcation downstream of Jamuna Bridge	Determines magnitude of future erosion due to flow splitting.
River reach along JMREMP sites	Determine upstream erosion potential and working conditions during adaptation works which is required for determining dredging works.
Chauhali reach	Determine site conditions including downstream bifurcation.
Zaffarganj reach	Determine site conditions especially upstream erosion potential.
Harrirampur reach	Required at approach flow and downstream extent to determine whether length of work suitable. Information critical for Tranche 2 and 3 work

## 2 JULY MONITORING SURVEY WORKS

For the month of July a detailed as-built survey has been conducted. This survey will be used as a benchmark to compare all past and future monitoring surveys to. ADCP flow and velocity measurements have been conducted at all sites along with float tracking measurements for Chauhali and Zaffarganj. These will continue to be conducted twice during the months of August, September and October.

### 2.1 Surveys Details

#### 2.1.1 Bathymetric Survey Details

Bathymetric surveys were conducted using a single beam echosounder and RTK GPS unit. Several bathymetric surveys have been used to assess and monitor the condition of the dumped and placed geo-textile bags. The following table provides details of the surveys for the FRERMIP work sites.

**Table 2.** Bathymetric survey details for all FRERMIP sites

Location	Chauhali	Zaffarganj	Harrirampur
Pre-Construction Survey	8 km - Section length 200 m spaced every 100 m	2 km - Section length 200 m spaced every 100 m	10 km - Section length 200 m spaced every 100 m
As-Built Survey May	8 km – Section length 200 m spaced every 100 m	N/A	10 km – Section length 200 m spaced every 100 m
As-Built Survey July	8 km – Section length 500 m spaced every 100 m	2 km – Section length 500 m spaced every 100 m	10 km – Section length 500 m spaced every 100 m

### **2.1.2 Topographic Survey Details**

Topographic surveys were completed using a Total Station and were conducted concurrently with the pre-construction bathymetric surveys at all three sites. The sections extended from the LWL, or as far as the surveyor could wade past the LWL, to the furthest distance the surveyor could walk to while being insight with the Total Station. No topographic data exists for the monitoring surveys and will not be collected as the monitoring assessment only applies to the condition of the bags and the extent of launching of the dumped apron.

### **2.2 Jamuna and Padma Flows and Float Tracks**

A single float track was conducted using 3 floats (additional units will be procured for future float tracks) starting 10 km downstream of the Jamuna Bridge and covering 40 km of river before being extracted 20 km downstream of the Chauhali site office. This was done to determine the attack angle of the flow interacting with the Chauhali bank downstream of the bifurcation. The float tracks are shown in Figure A.2.

### **2.3 ADCP Measurements**

To record discharge, ADCP measurements were conducted in first week of August 2016 when the water level was moving down from the peak. Three ADCP transects positioned at upstream, downstream and middle of bank protection work were taken in each of three project sites as Chauhali, Zaffarganj and Harrirampur. These transects covers bank to bank of front channel of bank protection works. In addition one transect was taken to cover full river in each of the three sites. To record the flow coming from Ganges one addition ADCP measurement were conducted at Rajbari.

## **3 RESULTS AND CONCLUSIONS**

### **3.1 Water Level**

For the month of July water levels recorded at the sites are available for all sites. The water level varied from a low of El. 9.86 m to a high of El. 12.00 m at Chauhali, a low of El. 8.24 m to a high of El. 10.33 m at Zaffarganj, and a high of El. 6.72 m to a high of El. 9.00 m. Figure A.4 present the hydrographs of the three sites.

### **3.2 ADCP Discharge**

In Jamuna River total discharge was recorded around 45,000 m<sup>3</sup>/s during the survey at both Chauhali and Zaffarganj site. At Padma river total discharge was recorder as 70,600 m<sup>3</sup>/s in main channel at Harrirampur where in Ganges total observed discharge was about 29,000 m<sup>3</sup>/s. A detail summary of discharge measurement is provided in Figure A1.

### 3.3 Near Bank Velocity

During ADCP measurements, velocity transects were also recorded which includes velocity magnitude and direction at every depth for three sites. At chauhali the near bank velocity recorded up to 3.5 m/s where velocity adjacent to river bed at the underwater slope area varies from 1.5 m/s to 2.4 m/s. At Zaffarganj velocity at river bed is about 1.5 m/s. At Harrirampur site recorded near bank velocity adjacent to river bed varies from 2.5 m/s to 3.0 m/s. Velocity magnitude and profile for three sites is provided in figure A2.

### 3.4 Launching of Geo-Textile Bag Revetment

#### 3.4.1 Harrirampur

From comparison of the pre-construction, monitoring survey, and as-built survey the average scour occurring along the protected length ranges from 10 to 15 m from Km 5+000 to 7+000 and 1 to 5 m from Km 7+000 to 11+000 (Figure A.5). The bags appear to be launching along the predicted 1V:2H slope however some locations that have had 5 bags dumped along the apron are not launching at the predicted extent (ie. if the scour is 5 m deep then roughly 2 m of protected bed should launch). In some locations the 5 bag thick protection is launching in the same manner a 2 bag thick protective layer would launch (see Section 8+000 of Harrirampur As-Built Survey).

The bed is accreting from 0+000 to 4+600 by upwards of 7 m in isolated regions, on average by 1-2 m.

#### 3.4.2 Zaffarganj

From comparison of the pre-construction and as-built survey no scouring or apron launching was observed along the length of bank with constructed protective works (Figure A.6). No significant scouring was noticed along the bed upstream and downstream of the dumped geo-textile aprons.

#### 3.4.3 Chauhali

From comparison of the pre-construction, June as-built survey and July as-built survey the average scour occurring along the protected length ranges from 8 to 15 m from Km 5+200 to 1+200 with only 1 to 2 m of scouring from Km 1+200 to -0+560 and negligible scour occurring upstream of Km 5+200 (Figure A.7).The bags appearing to be launching along the predicted 1V:2H slope with launching length to protection length ratio following the design ratio (ie. if 2 m of 5 layer geobag apron launches it will protect 10 m of scoured bank – see section 3+400). The section with the most severe scour is located downstream of the vertex of the bank curve where velocities are likely highest and where previous large scale bank failures were observed from June 16 to 21<sup>st</sup> this area should be closely monitored to ensure bags continue to launch as designed and that mitigative bag dumping post bank failures were adequate.

## 3.5 Recommendations

### 3.5.1 Adaptation Works

Based off the extent of the bag launching described in Section 3.4 and the probable continued launching of the bags in August and September it is recommended that additional bags be procured now for adaptive works to be administered immediately following the monsoon. These adaptive works will include increasing the thickness of the launched apron from 1 bag to 3 bags and extending the apron an additional 20 m with a thickness of three bags. Special attention should be applied to the upstream section of Chauhali from km 1+200 to 5+000. The amount of bags that should be procured for each site is detailed in Table 3. The number of CC blocks to be deposited along the toe has been reduced as the previous amount was overly conservative. This reduction will provide sufficient funds to cover this additional amount of geobags.

**Table 3. Geo-textile bags required for adaptive works**

Location	Additional Bags	Contingency	Total Bags
Chauhali	511,000	51,000	562,000
Zaffarganj	72,000	7,000	79,000
Harrirampur	467,000	117,000	584,000
<b>Total Bags</b>	<b>1,050,000</b>	<b>175,000</b>	<b>1,225,000</b>

### 3.5.2 Multi-Beam Requirements


Due to the extreme scouring observed at Chauhali and June bank failures it is recommended that the proposed multi-beam survey be conducted at this site – though a complete multi-beam survey at all sites would be most beneficial to minimizing adaptive work costs and Tranche 2 design work.

Additional floats should be used during flow tracks along the Chauhali protected works over the course of the monsoon to determine the change in attack angle of the river from km 5+000 to km 1+200.


## Figures


- A.1 ADCP Transect Locations
- A.2 Chauhali Float Tracks
- A.3 Velocity Magnitude and Profile
- A.4 Jamuna and Padma River Water Level Trends
- A.5 Harrirampur Interim Construction Completion Drawings
- A.6 Zaffarganj Interim Construction Completion Drawings
- A.7 Chauhali Interim Construction Completion Drawings


**Figure A.1 ADCP Transect Locations**

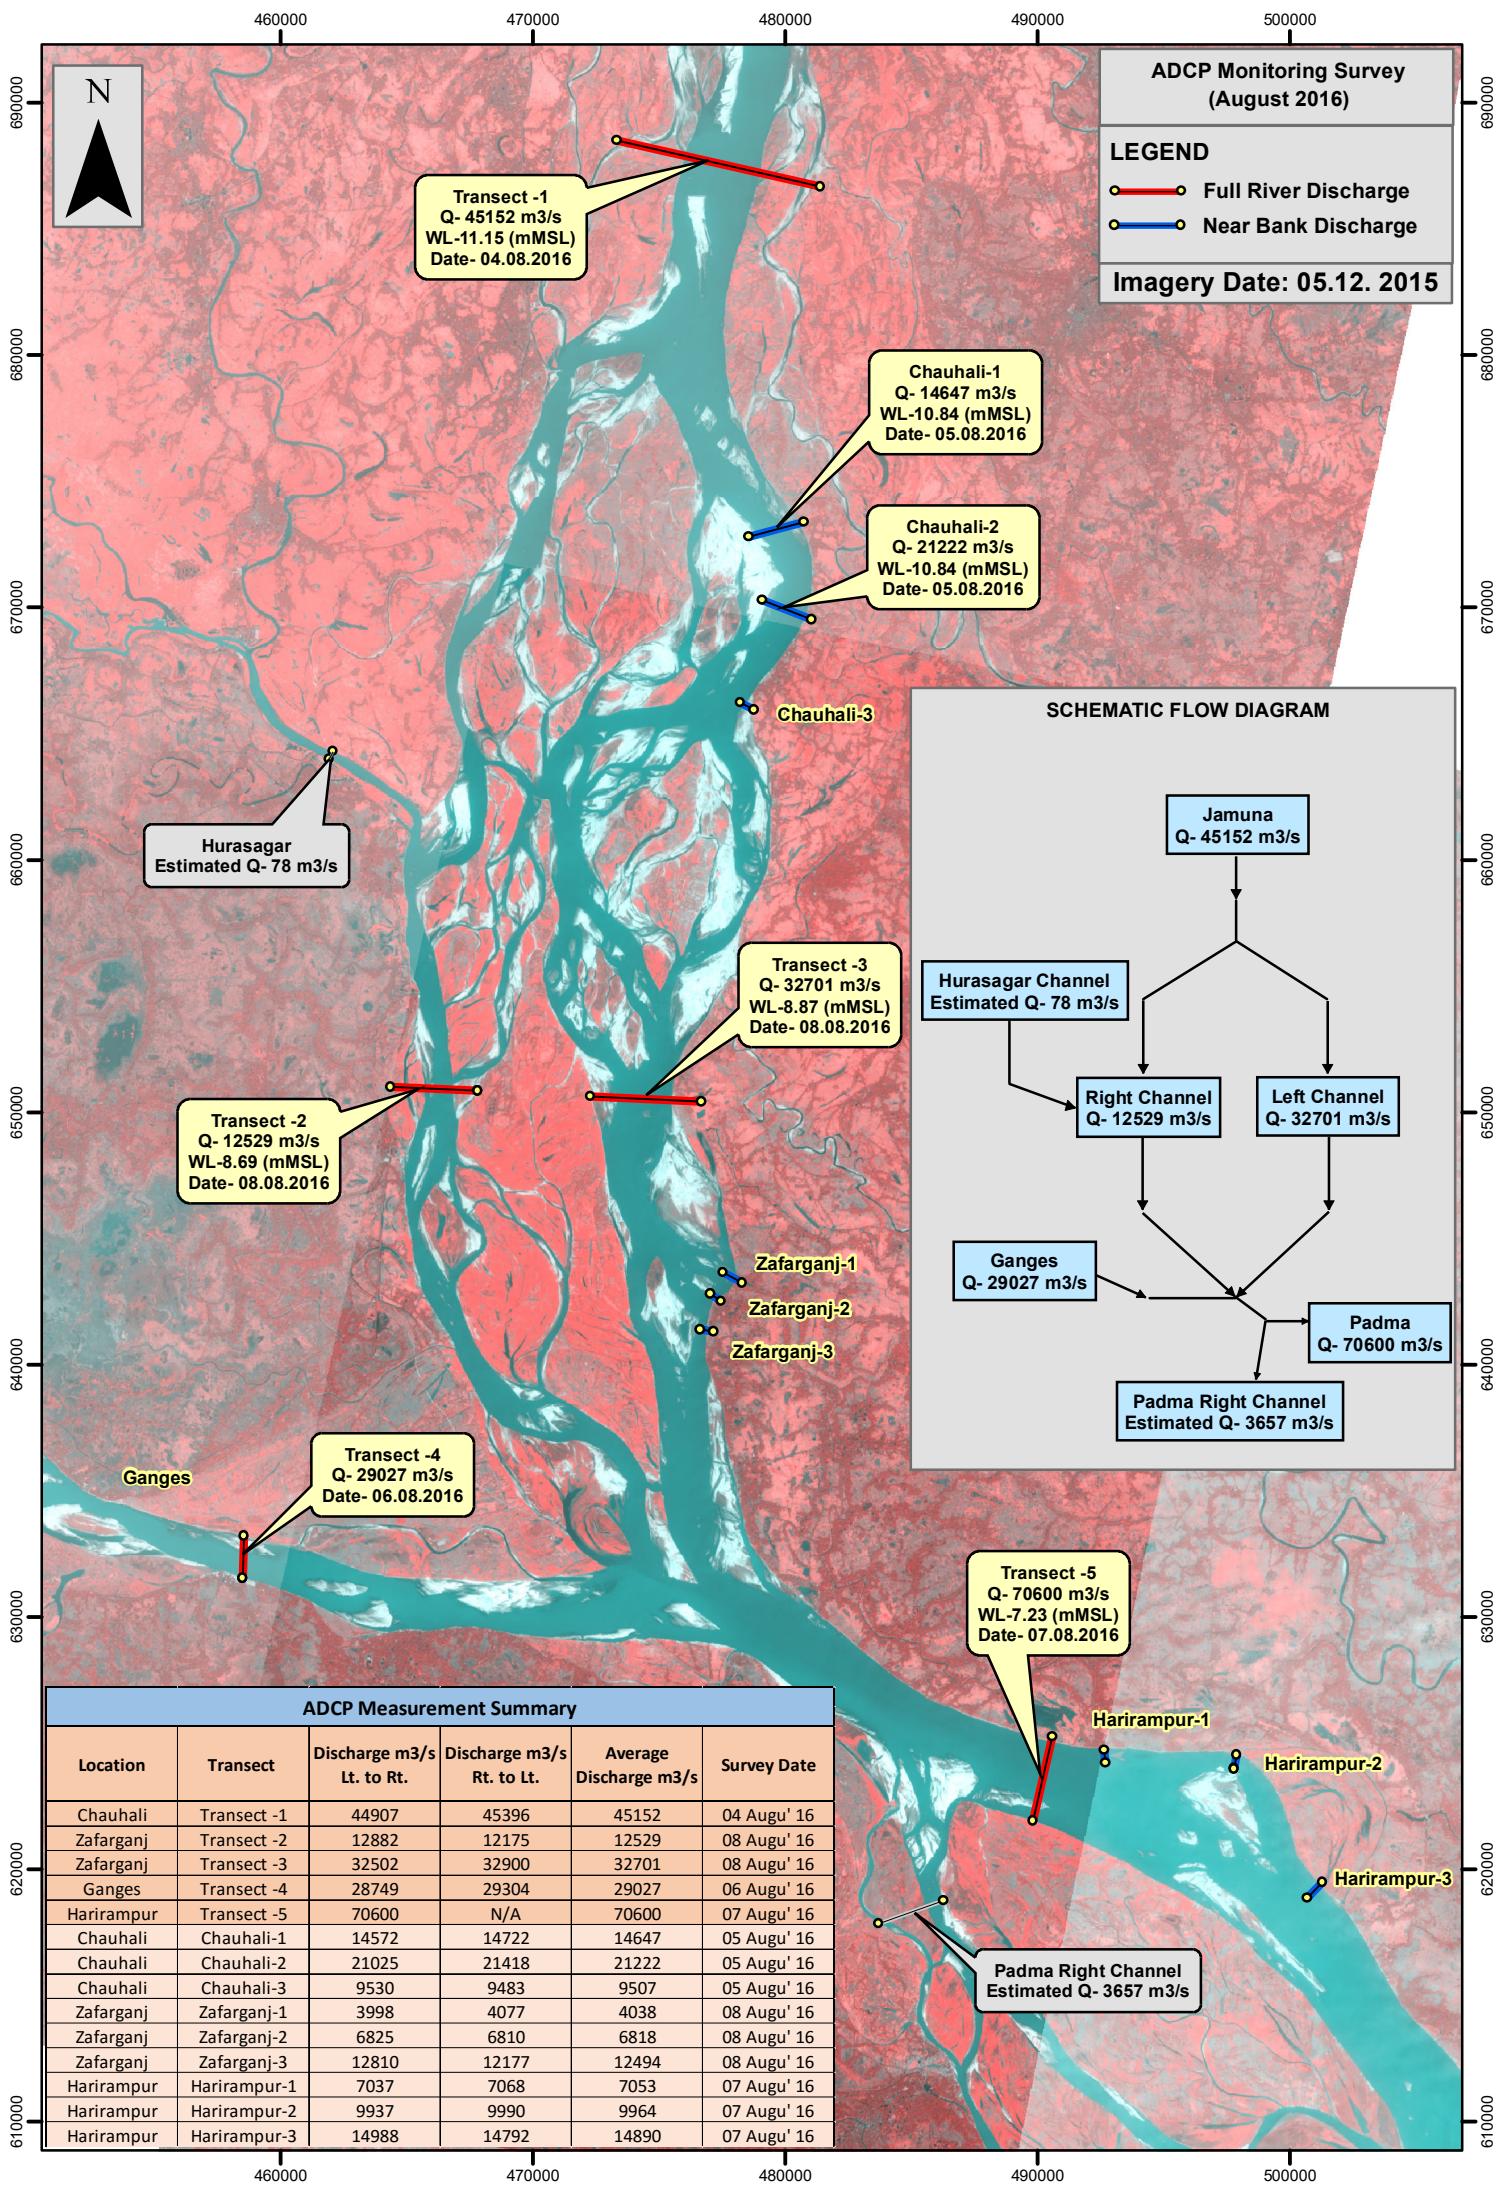

**Figure A.2 Chauhali Float Tracks**

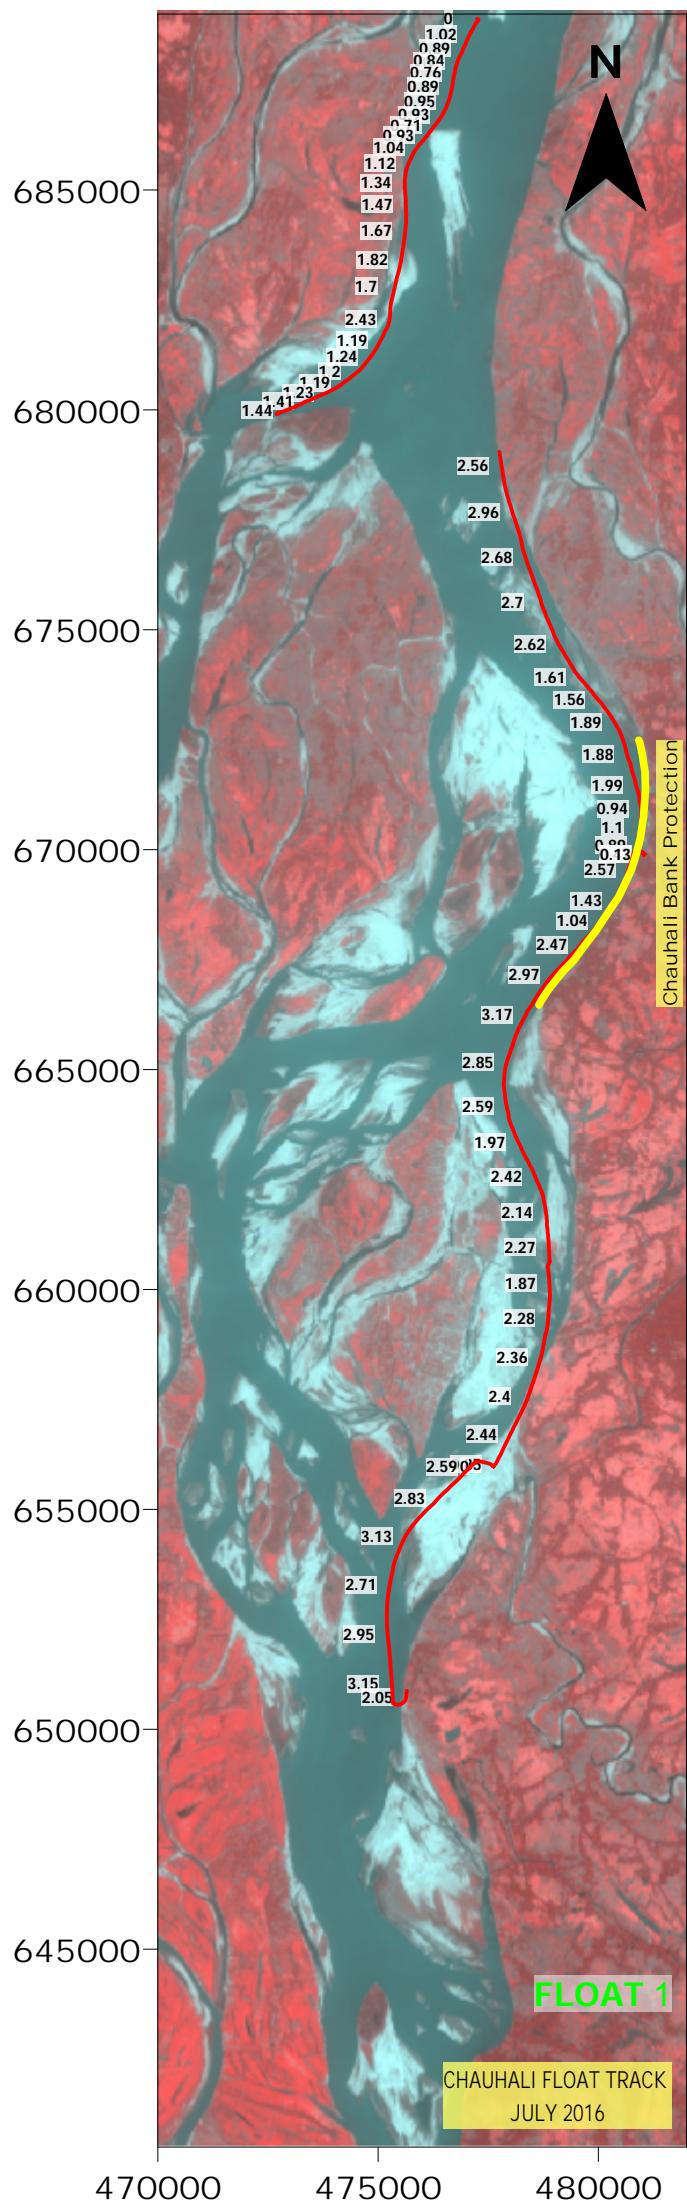

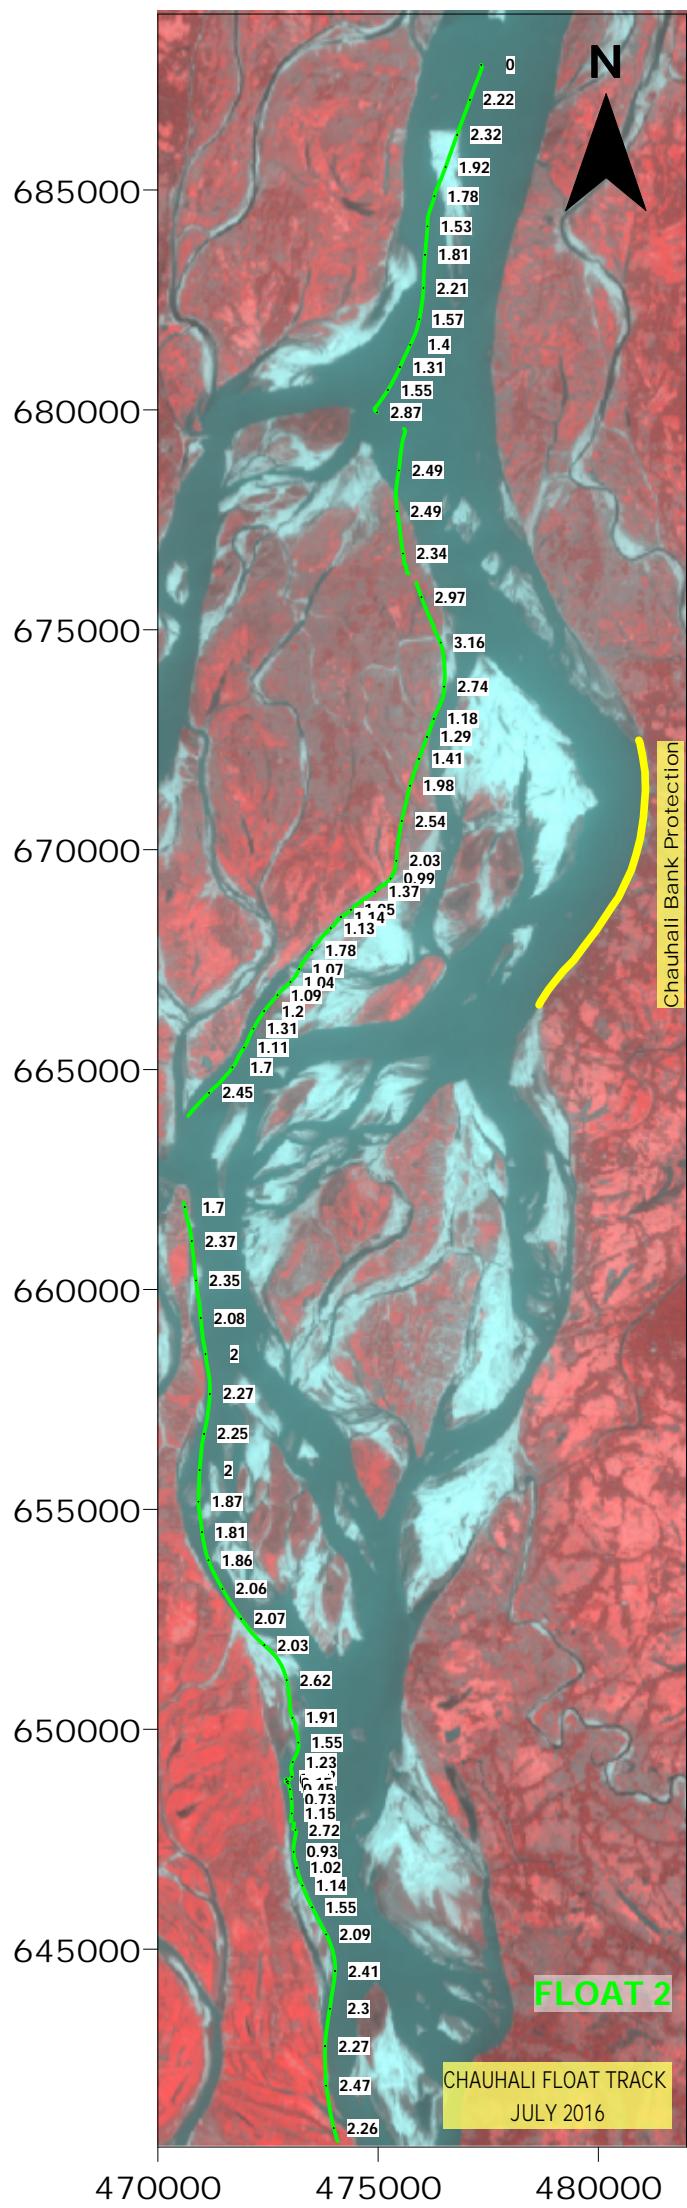

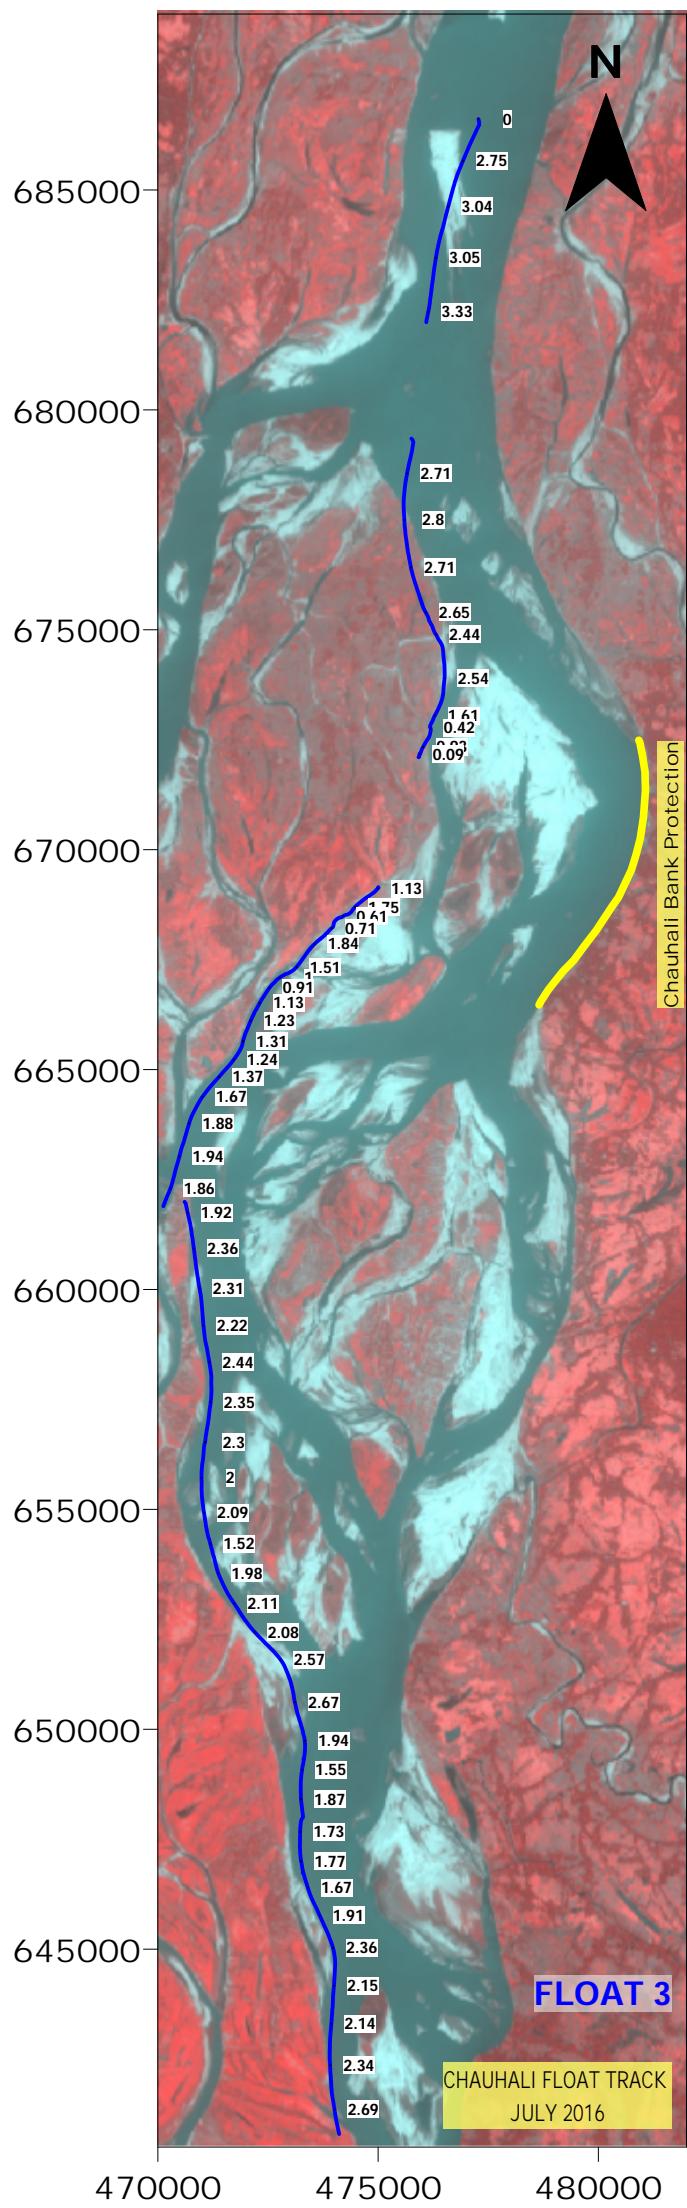

**Figure A.3 Velocity Magnitude and Profile**

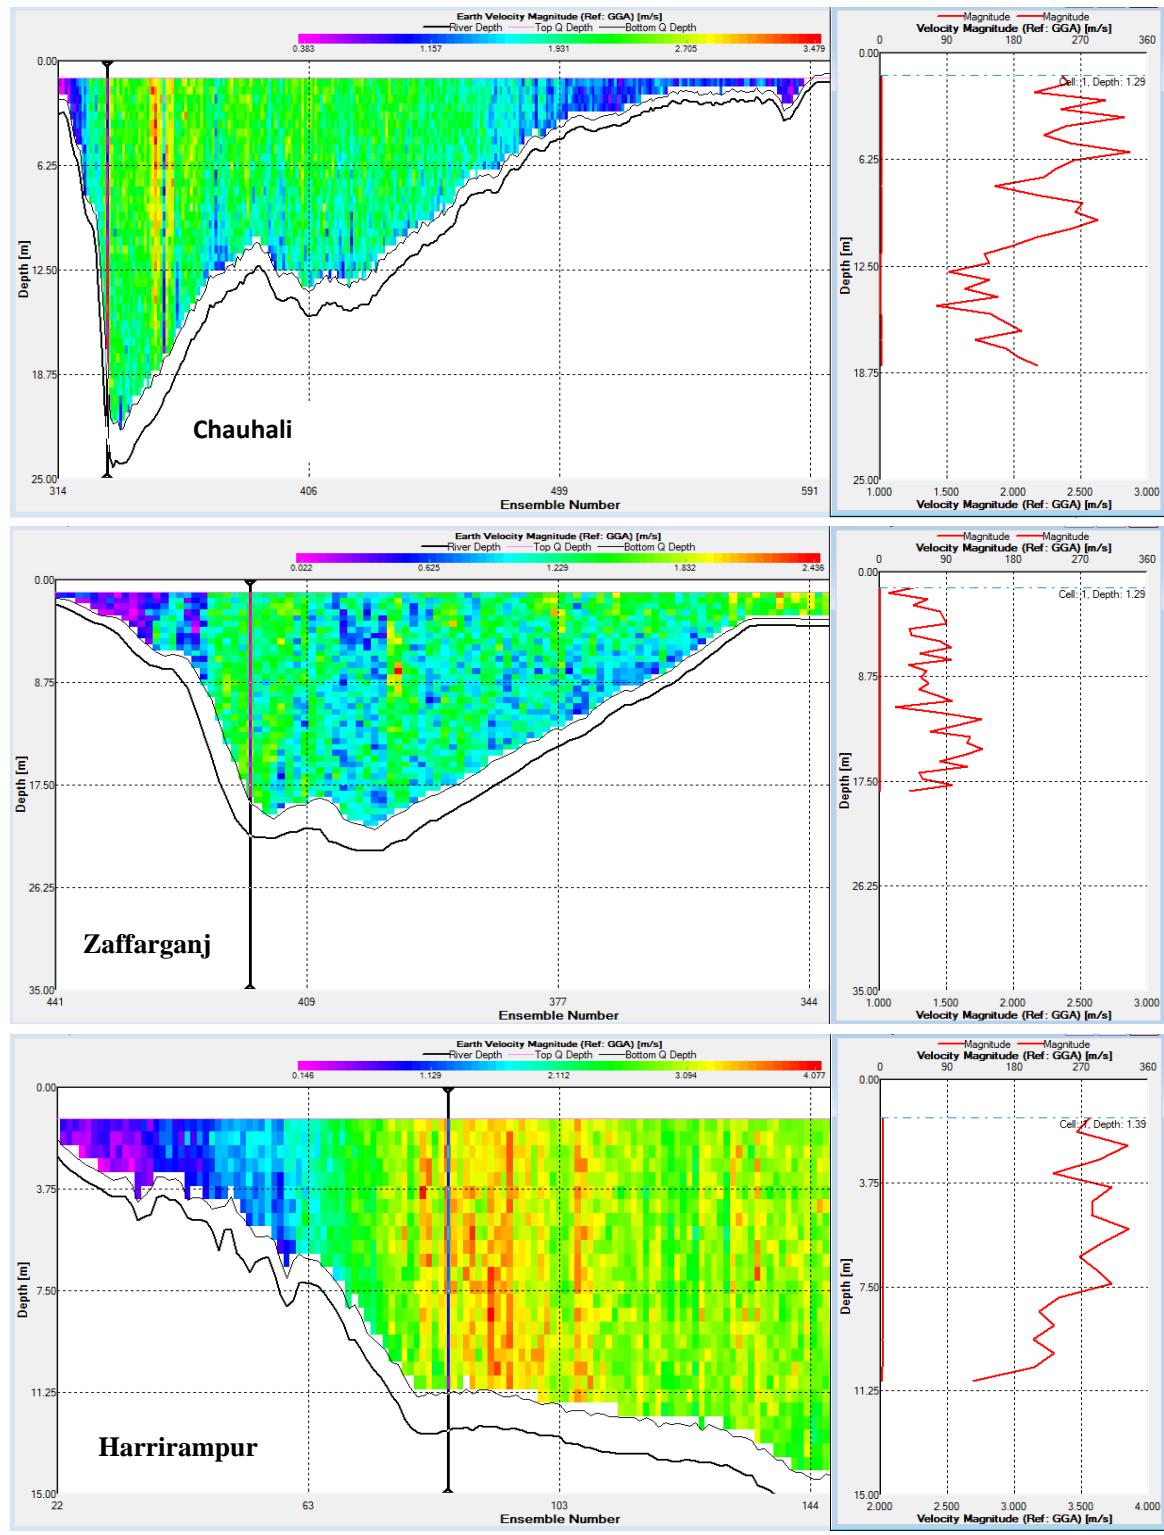



Figure A2

**Figure A.4 Jamuna and Padma Water Level Trends**

## WL HYDROGRAPH


Legend:

- Chauhali Site Construction WL
- Zaffarganj July AsBuilt Survey
- Zaffarganj July ADCP Survey
- Zaffarganj Site Construction WL
- July Float Track
- Aricha Gauge 2016
- Chauhali July AsBuilt Survey
- Chauhli July ADCP Survey
- Sirajganj Gauge 2016

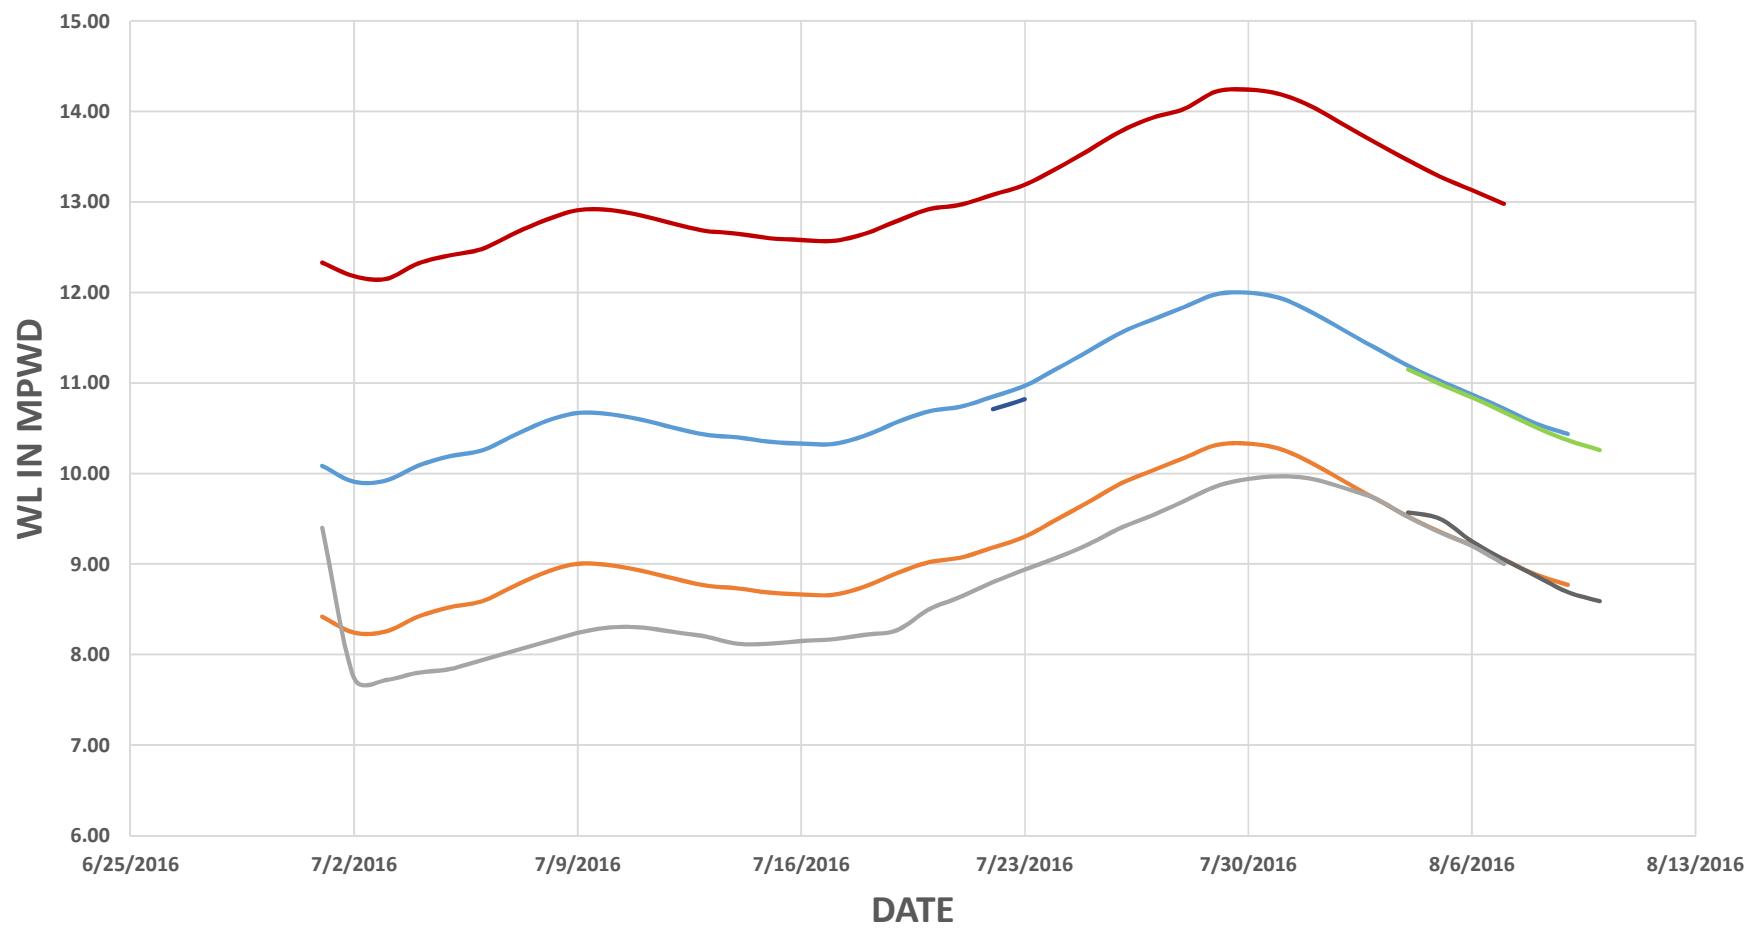

## WL HYDROGRAPH

Harrirampur Site Construction WL    Harrirampur July AsBuilt Survey    Harrirampur ADCP Survey    Aricha Gauge 2016    Gaolando Gauge 2016


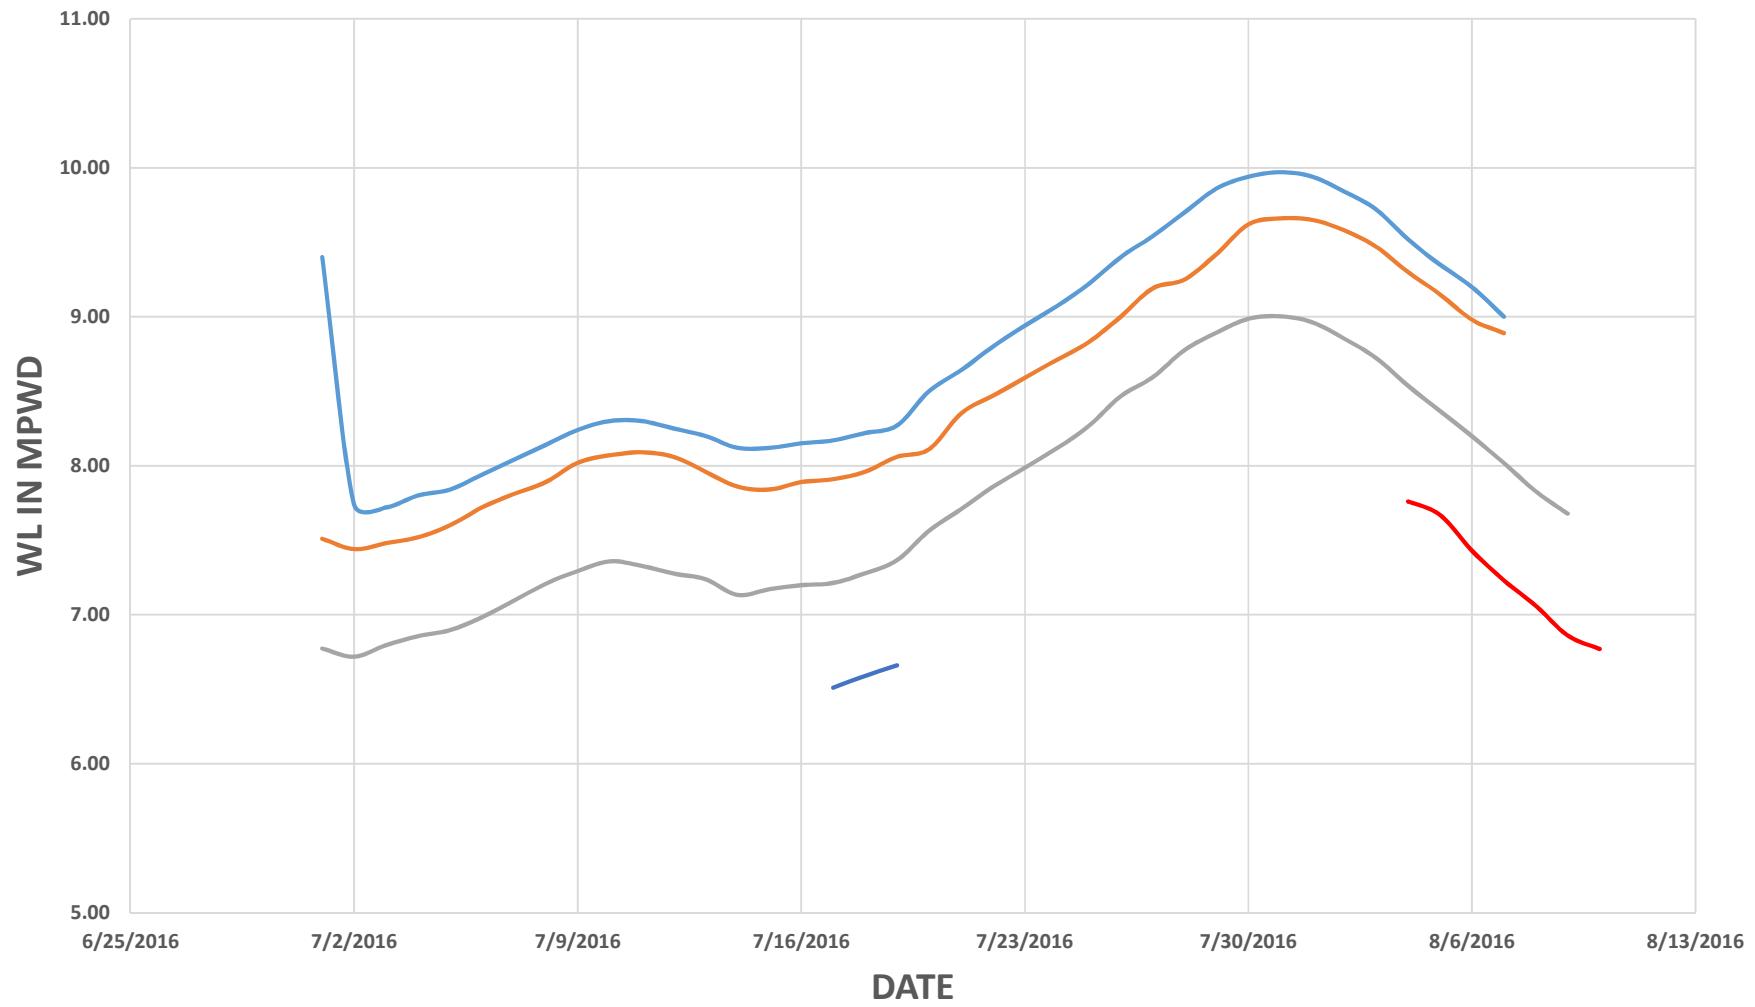


**Figure A.5 Harrirampur Interim Construction Completion Drawings**

# FRERMIP – HARRIRAMPUR SITE

## INTERIM CONSTRUCTION RECORD DRAWINGS

### JULY, 2016

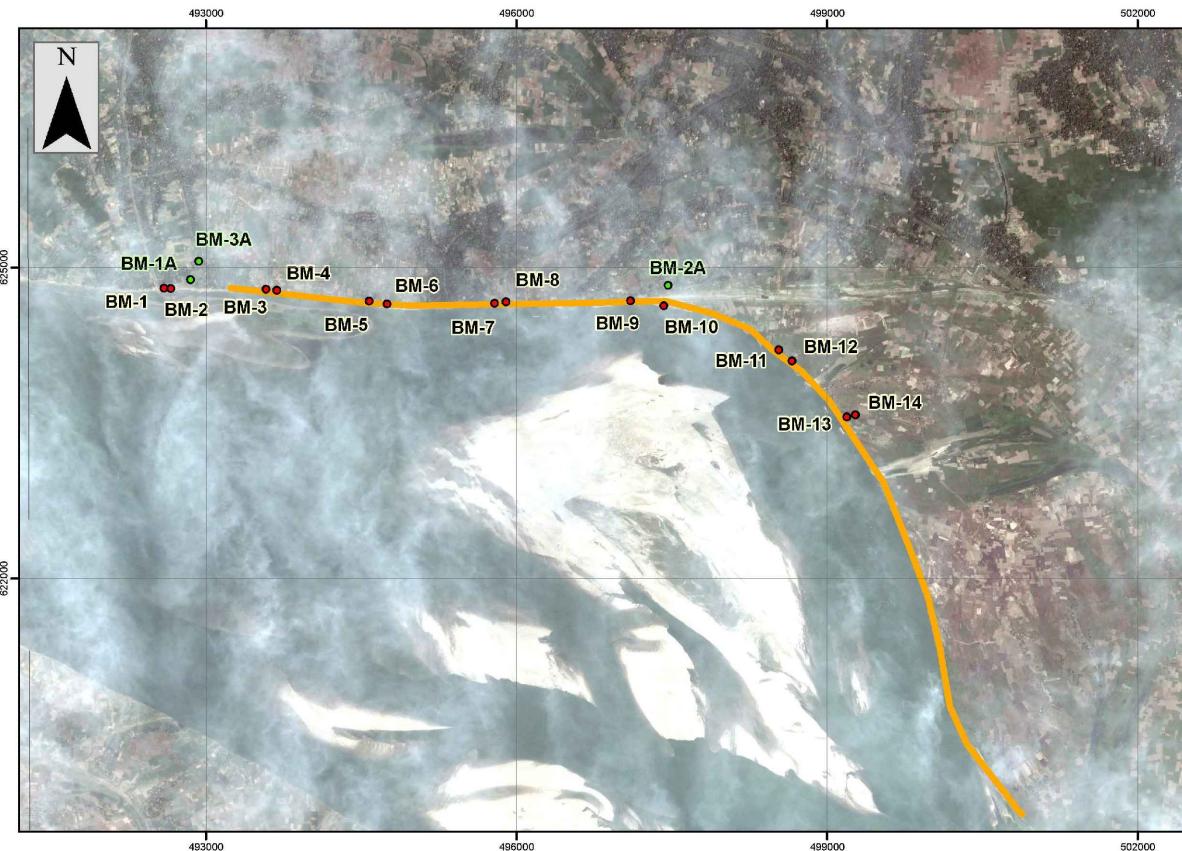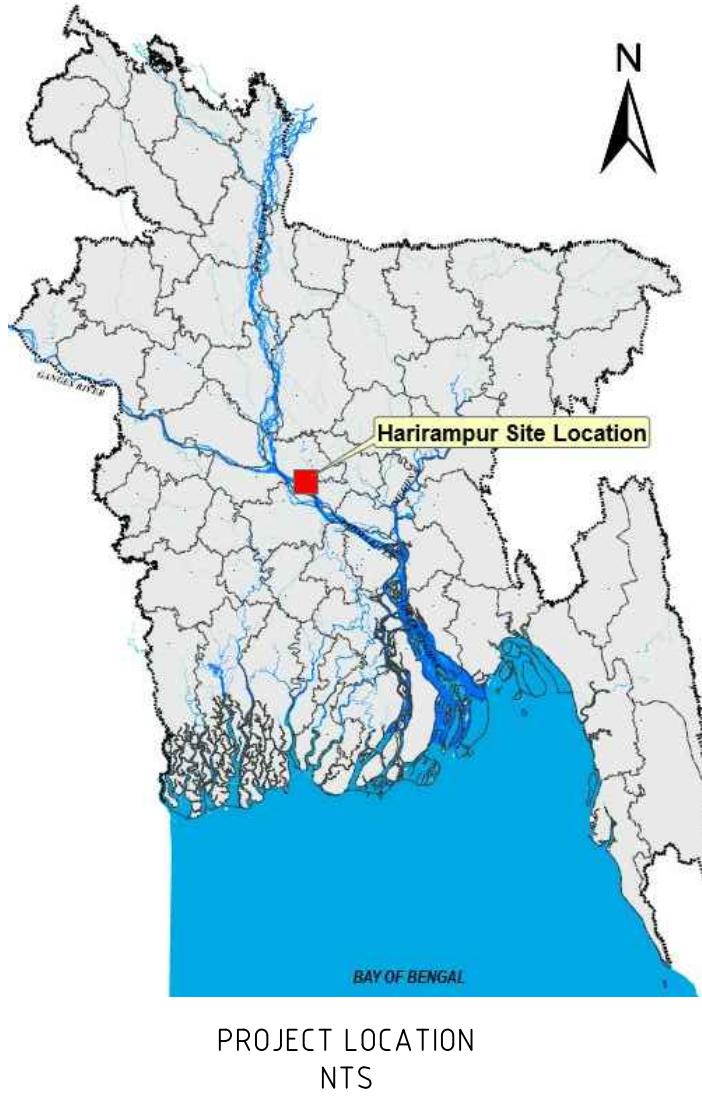


SITE PLAN  
NTS

BM COORDINATES		
BM NO	EASTING	NORTHING
1	492596	624799
2	492661	624795
3	493583	624786
4	493686	624779
5	494579	624672
6	494754	624644
7	495789	624654
8	495901	624665
9	497104	624676
10	497425	624629
11	498536	624203
12	498665	624094
13	499195	623557
14	499276	623576

DRAWING INDEX		
SHEET NUMBER	DESCRIPTION	REVISION
1	HARIRAMPUR SITE LOCATION AND PLAN AND BM CO ORDINATES	0
2	KEY MAP	0
3	PLAN KM 0+000 – 1+600	0
4	PLAN KM 1+600 – 3+400	0
5	PLAN KM 3+400 – 5+200	0
6	PLAN KM 5+200 – 7+200	0
7	PLAN KM 7+200 – 9+000	0
8	PLAN KM 9+000 – 10+600	0
9	PLAN KM 10+600 – 11+800	0
10	SECTION KM 0+000 – 1+400	0
11	SECTION KM 1+600 – 3+000	0
12	SECTION KM 3+200 – 4+400	0
13	SECTION KM 4+600 – 5+400	0
14	SECTION KM 5+600 – 6+600	0
15	SECTION KM 6+800 – 8+200	0
16	SECTION KM 8+400 – 9+400	0
17	SECTION KM 9+600 – 11+000	0

NOTES:  
PROJECTION SYSTEM USED FOR PRODUCING THESE DRAWINGS IS BANGLADESH TRANSVERSE MERCATOR (BTM)

This drawing is confidential and shall only be used for the purposes of this project.			THE SIGNING OF THIS TITLE BLOCK CONFIRMS THE DESIGN AND DRAFTING OF THIS PROJECT HAVE BEEN PREPARED AND CHECKED			SCALES:	CLIENT:  BANGLADESH WATER DEVELOPMENT BOARD	CONSULTANT:  northwest hydraulic consultants 	FLOOD AND RIVERBANK EROSION RISK MANAGEMENT INVESTMENT PROGRAM					
DESIGNED	MYA	CHECKED	GV	DRAWN	MYA	CHECKED			GV	DRAWING NAME:				
APPROVED	KO	DATE		APPROVED	KO	DATE				HARIRAMPUR SITE LOCATION AND PLAN AND BM CO ORDINATES				
No. BY	26.07.2016	FIRST DRAFT	KO APPD	SHEET NO:		001			STATUS:	AS BUILT_JULY 2016		DRAWING NO:	FRERMIP-ISPMC-HAR-01	REVISION:
DATE			DESCRIPTION											

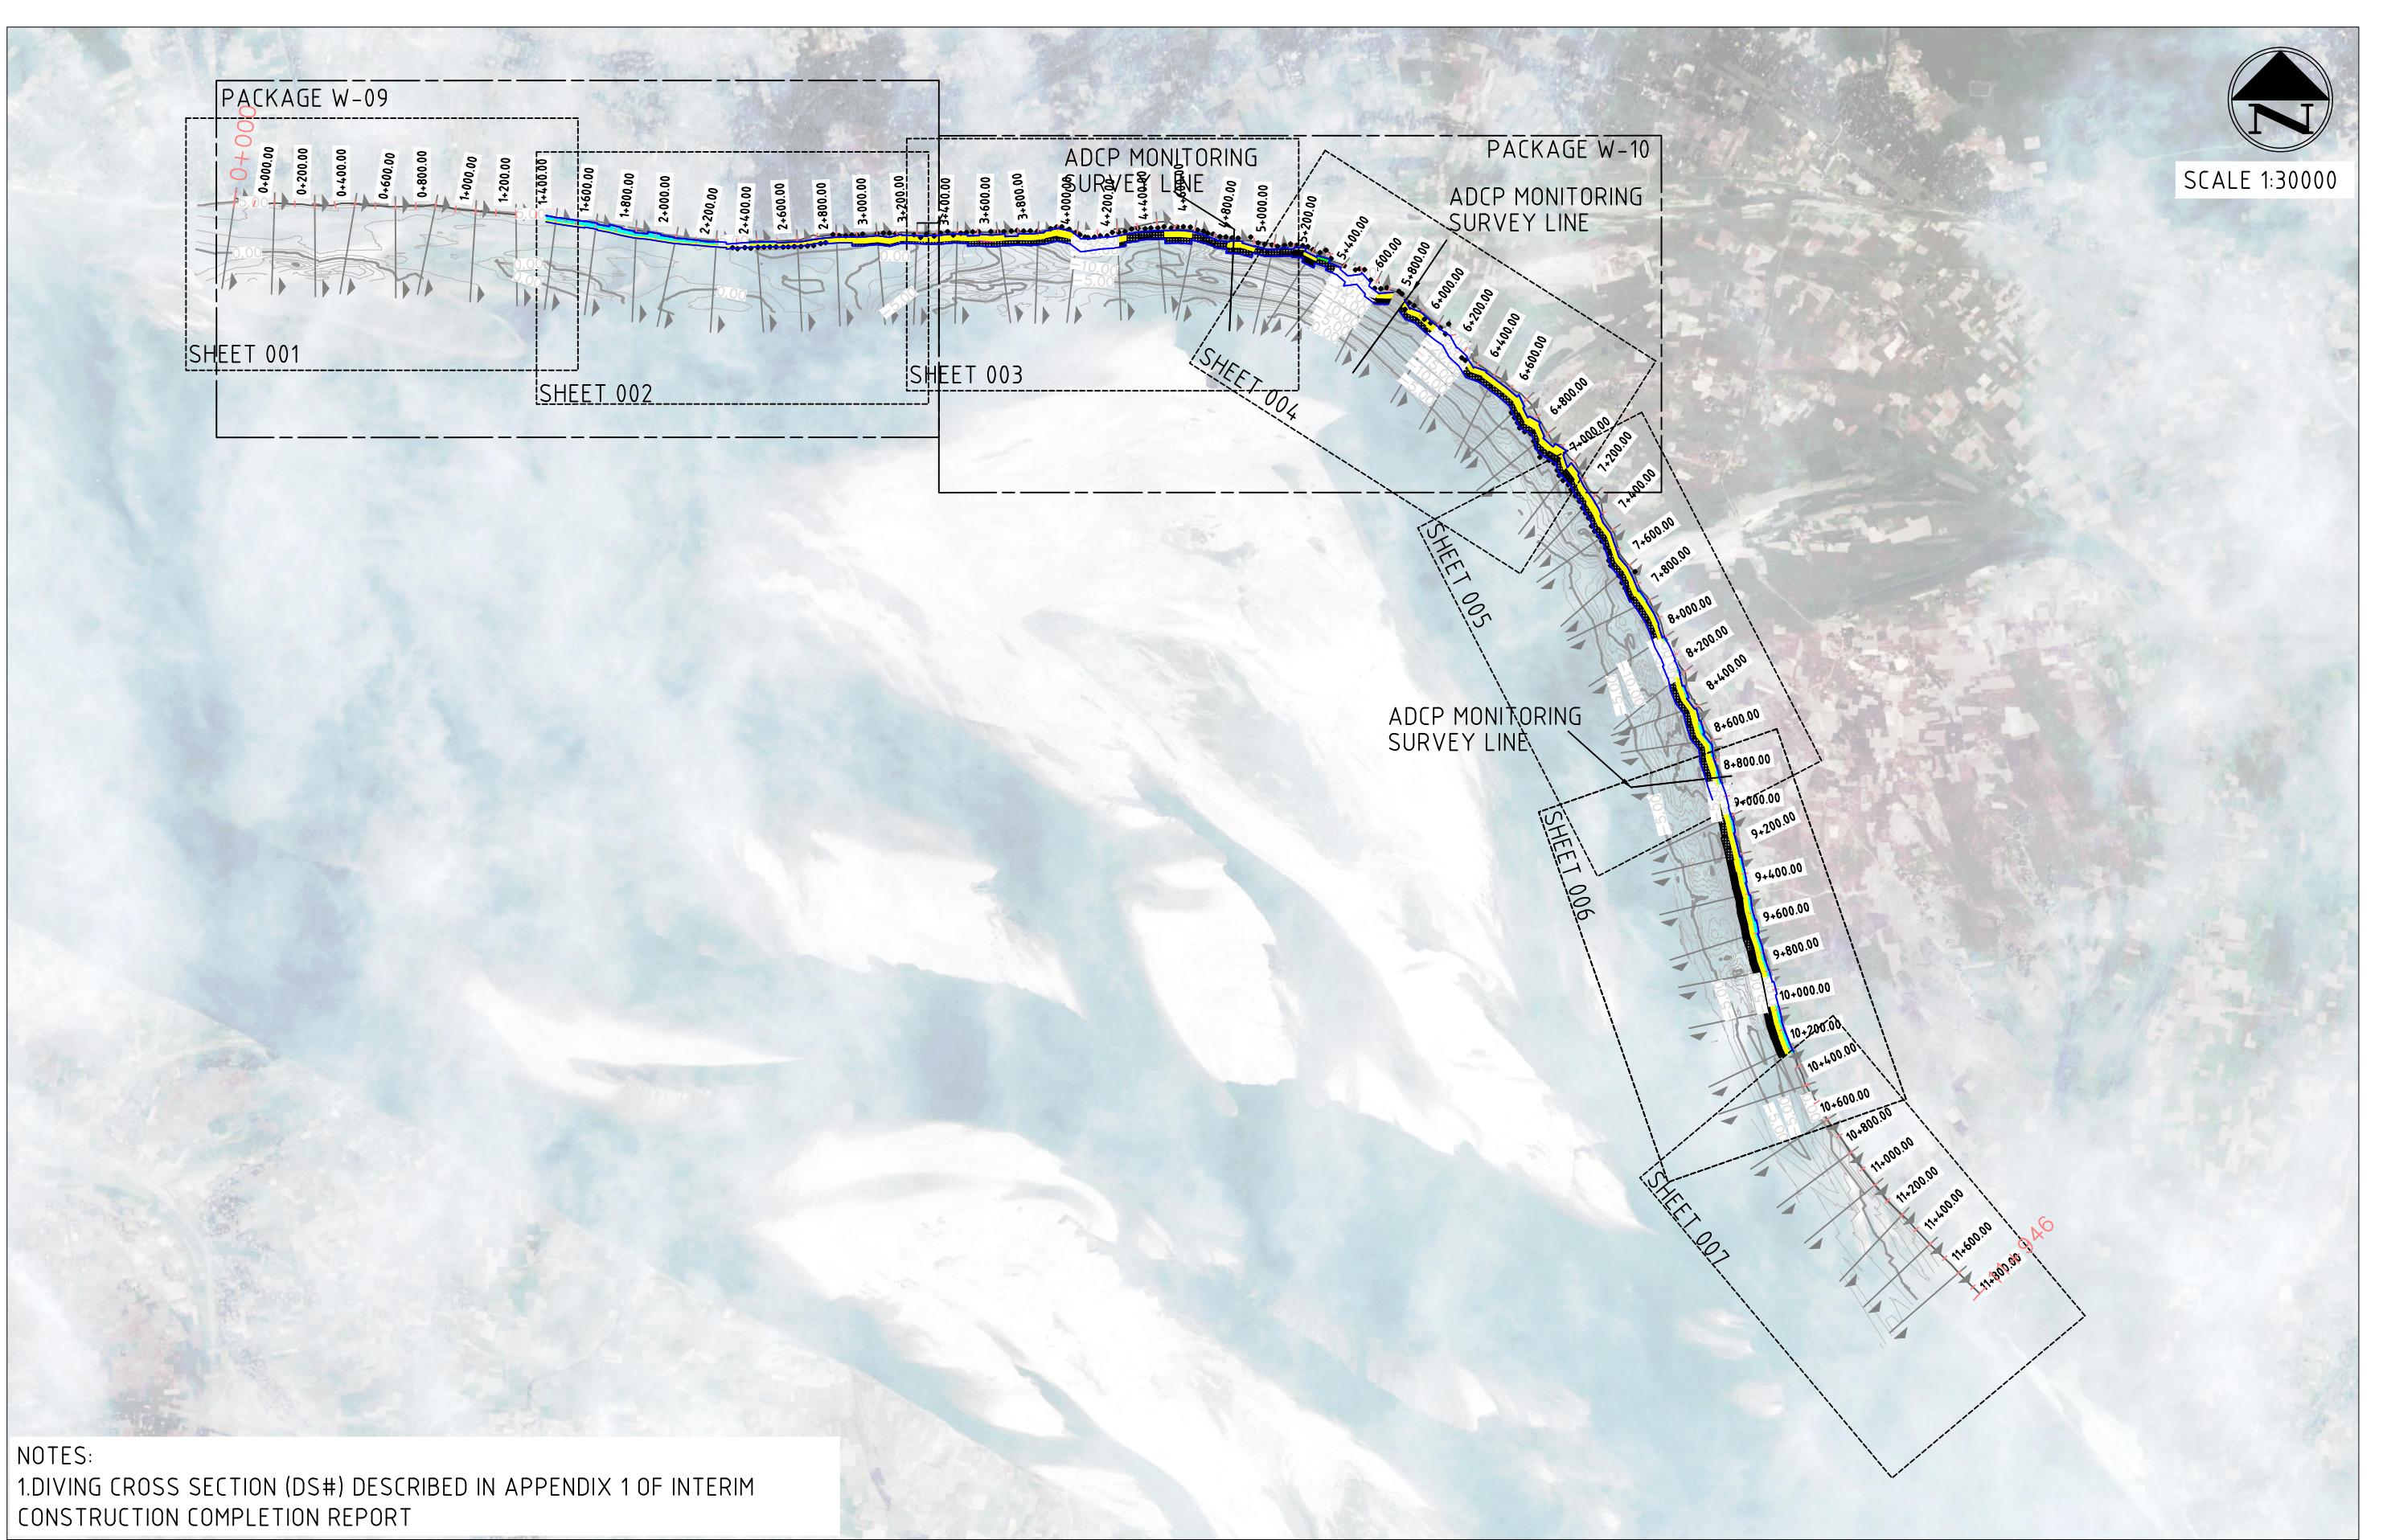


## NOTES:

- ## 1.DIVING CROSS SECTION (DS#) DESCRIBED IN APPENDIX 1 OF INTERIM CONSTRUCTION COMPLETION REPORT

This drawing is confidential and shall only be used for the purposes of this project.				THE SIGNING OF THIS TITLE BLOCK CONFIRMS THE DESIGN AND DRAFTING OF THIS PROJECT HAVE BEEN PREPARED AND CHECKED				SCALES:  AS SHOWN IN THE DRAWING	CLIENT:    BANGLADESH WATER DEVELOPMENT BOARD	CONSULTANT:  <b>nhc</b> northwest hydraulic consultants 	FLOOD AND RIVERBANK EROSION RISK MANAGEMENT INVESTMENT PROGRAM			
		DESIGNED	MYA	CHECKED	GV	DRAWING NAME:								
		DRAWN	MYA	CHECKED	GV	KEY PLAN LAYOUT								
		APPROVED	KO	DATE		STATUS:	AS BUILT_JULY 2016				DRAWING NO:	FRERMIP-ISPMC-HAR-02	REVISION:	
0	MYA	26.07.2016	FIRST DRAFT	KO	SHEET NO:		002				0			
No.	BY	DATE	DESCRIPTION	APPD										



SCALE 1:5000

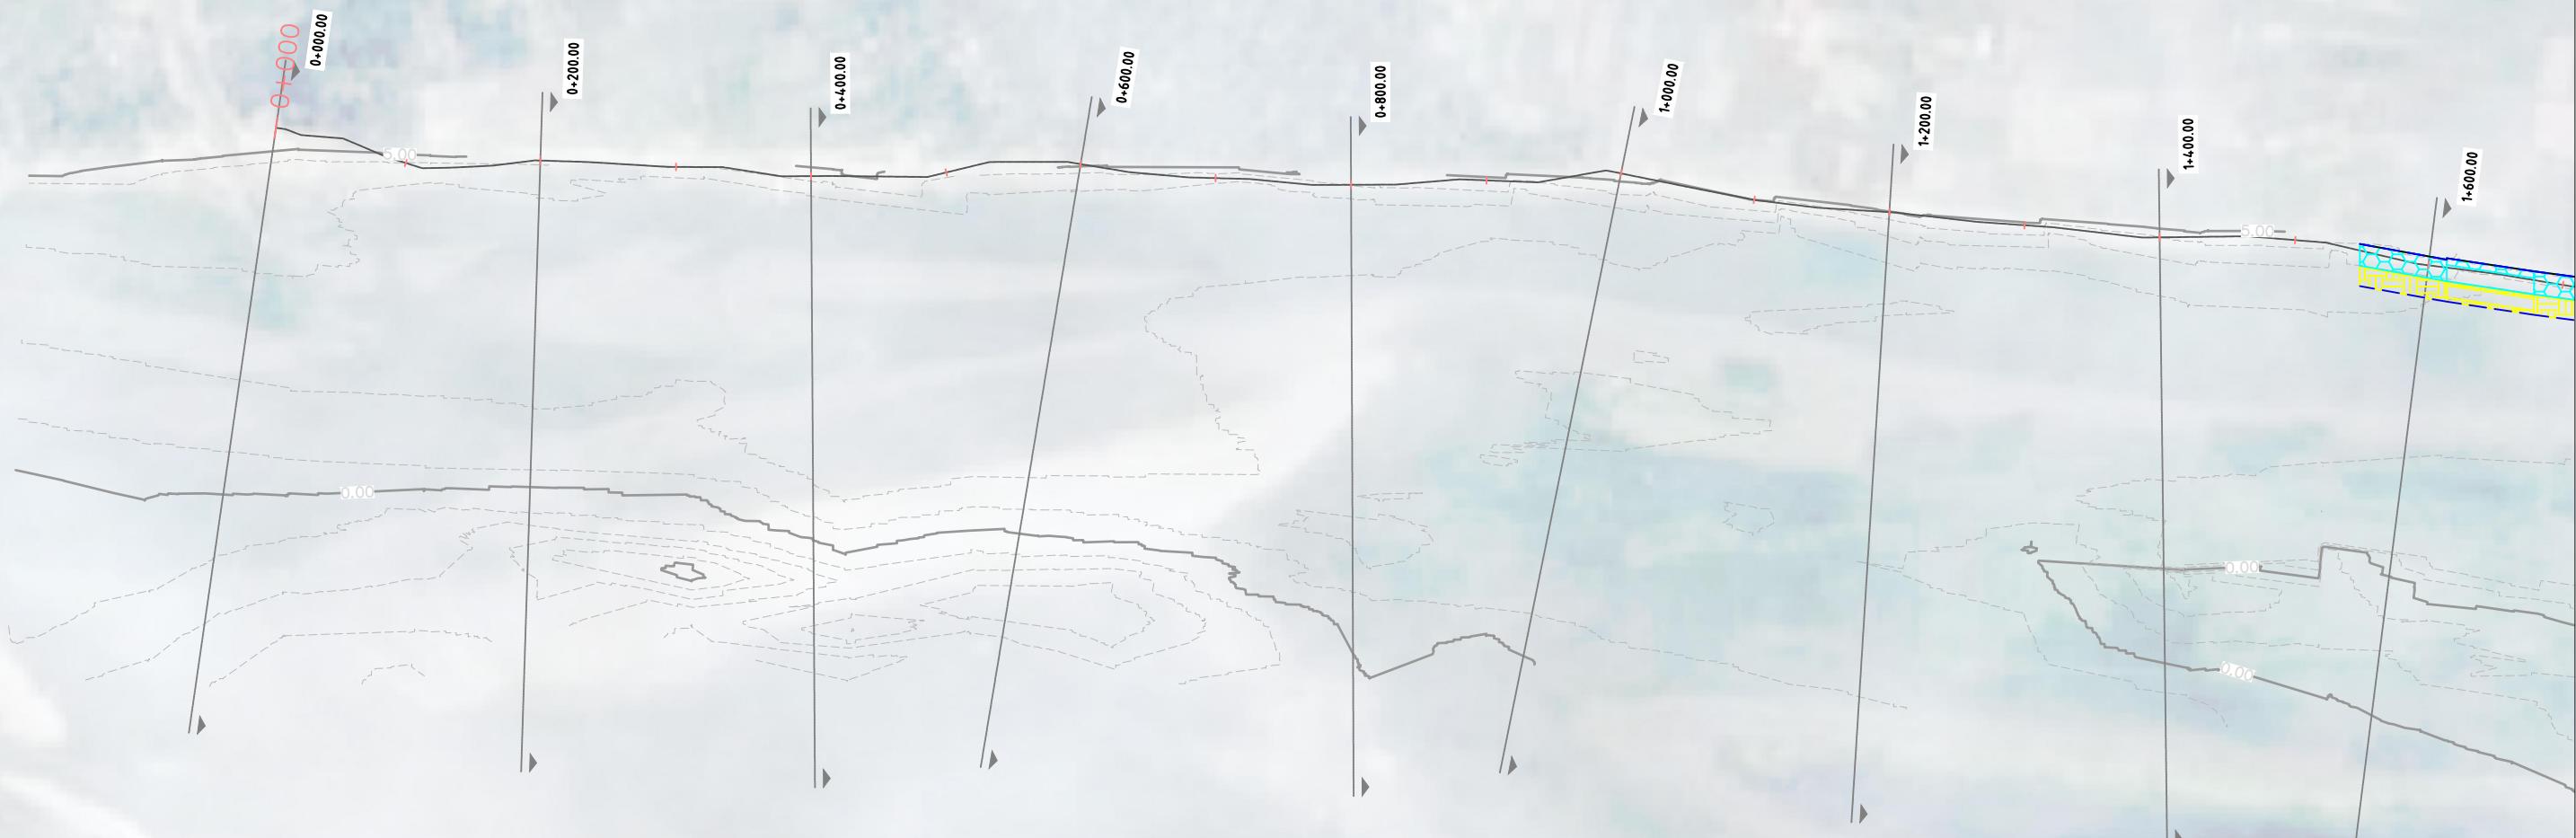

## LEGENDS:

5 DUMPED BAGS PER ROW

4 DUMPED BAGS PER ROW

3 DUMPED BAGS PER ROW

2 DUMPED BAGS PER ROW

DIVING CROSS SECTION LOCATION

EXTENT OF GEOTEXTILE BAG DUMPING

## NOTES:

1. INTERIM CONSTRUCTION COMPLETION REPORT FOR DIVING CROSS SECTION INFORMATION
2. TOPOGRAPHIC SURVEY OF UPPER BANK ie HWL TO CREST, NOT INCLUDED IN CONSTRUCTION COMPLETION DRAWINGS.  
WILL BE SURVEYED FOLLOWING CC BLOCK PLACEMENT

This drawing is confidential and shall only be used for the purposes of this project.

THE SIGNING OF THIS TITLE BLOCK CONFIRMS THE DESIGN AND DRAFTING OF THIS PROJECT HAVE BEEN PREPARED AND CHECKED

SCALES:

AS SHOWN IN THE DRAWING

CLIENT:



BANGLADESH WATER DEVELOPMENT BOARD

CONSULTANT

**nhc**  
 northwest hydraulic consultants  
*Mott MacDonald*

FLOOD AND RIVERBANK EROSION RISK MANAGEMENT INVESTMENT PROGRAM

DRAWING NAME:

PLAN VIEW FROM CH 0+000 TO CH 1+600

STATUS: AS BUILT\_JULY 2016

DRAWING NO:


FRERMIP-ISPMC-HAR-03

REVISION: 0

0	MYA	26.07.2016	FIRST DRAFT	KO
No.	BY	DATE	DESCRIPTION	APPD



SCALE 1:5000

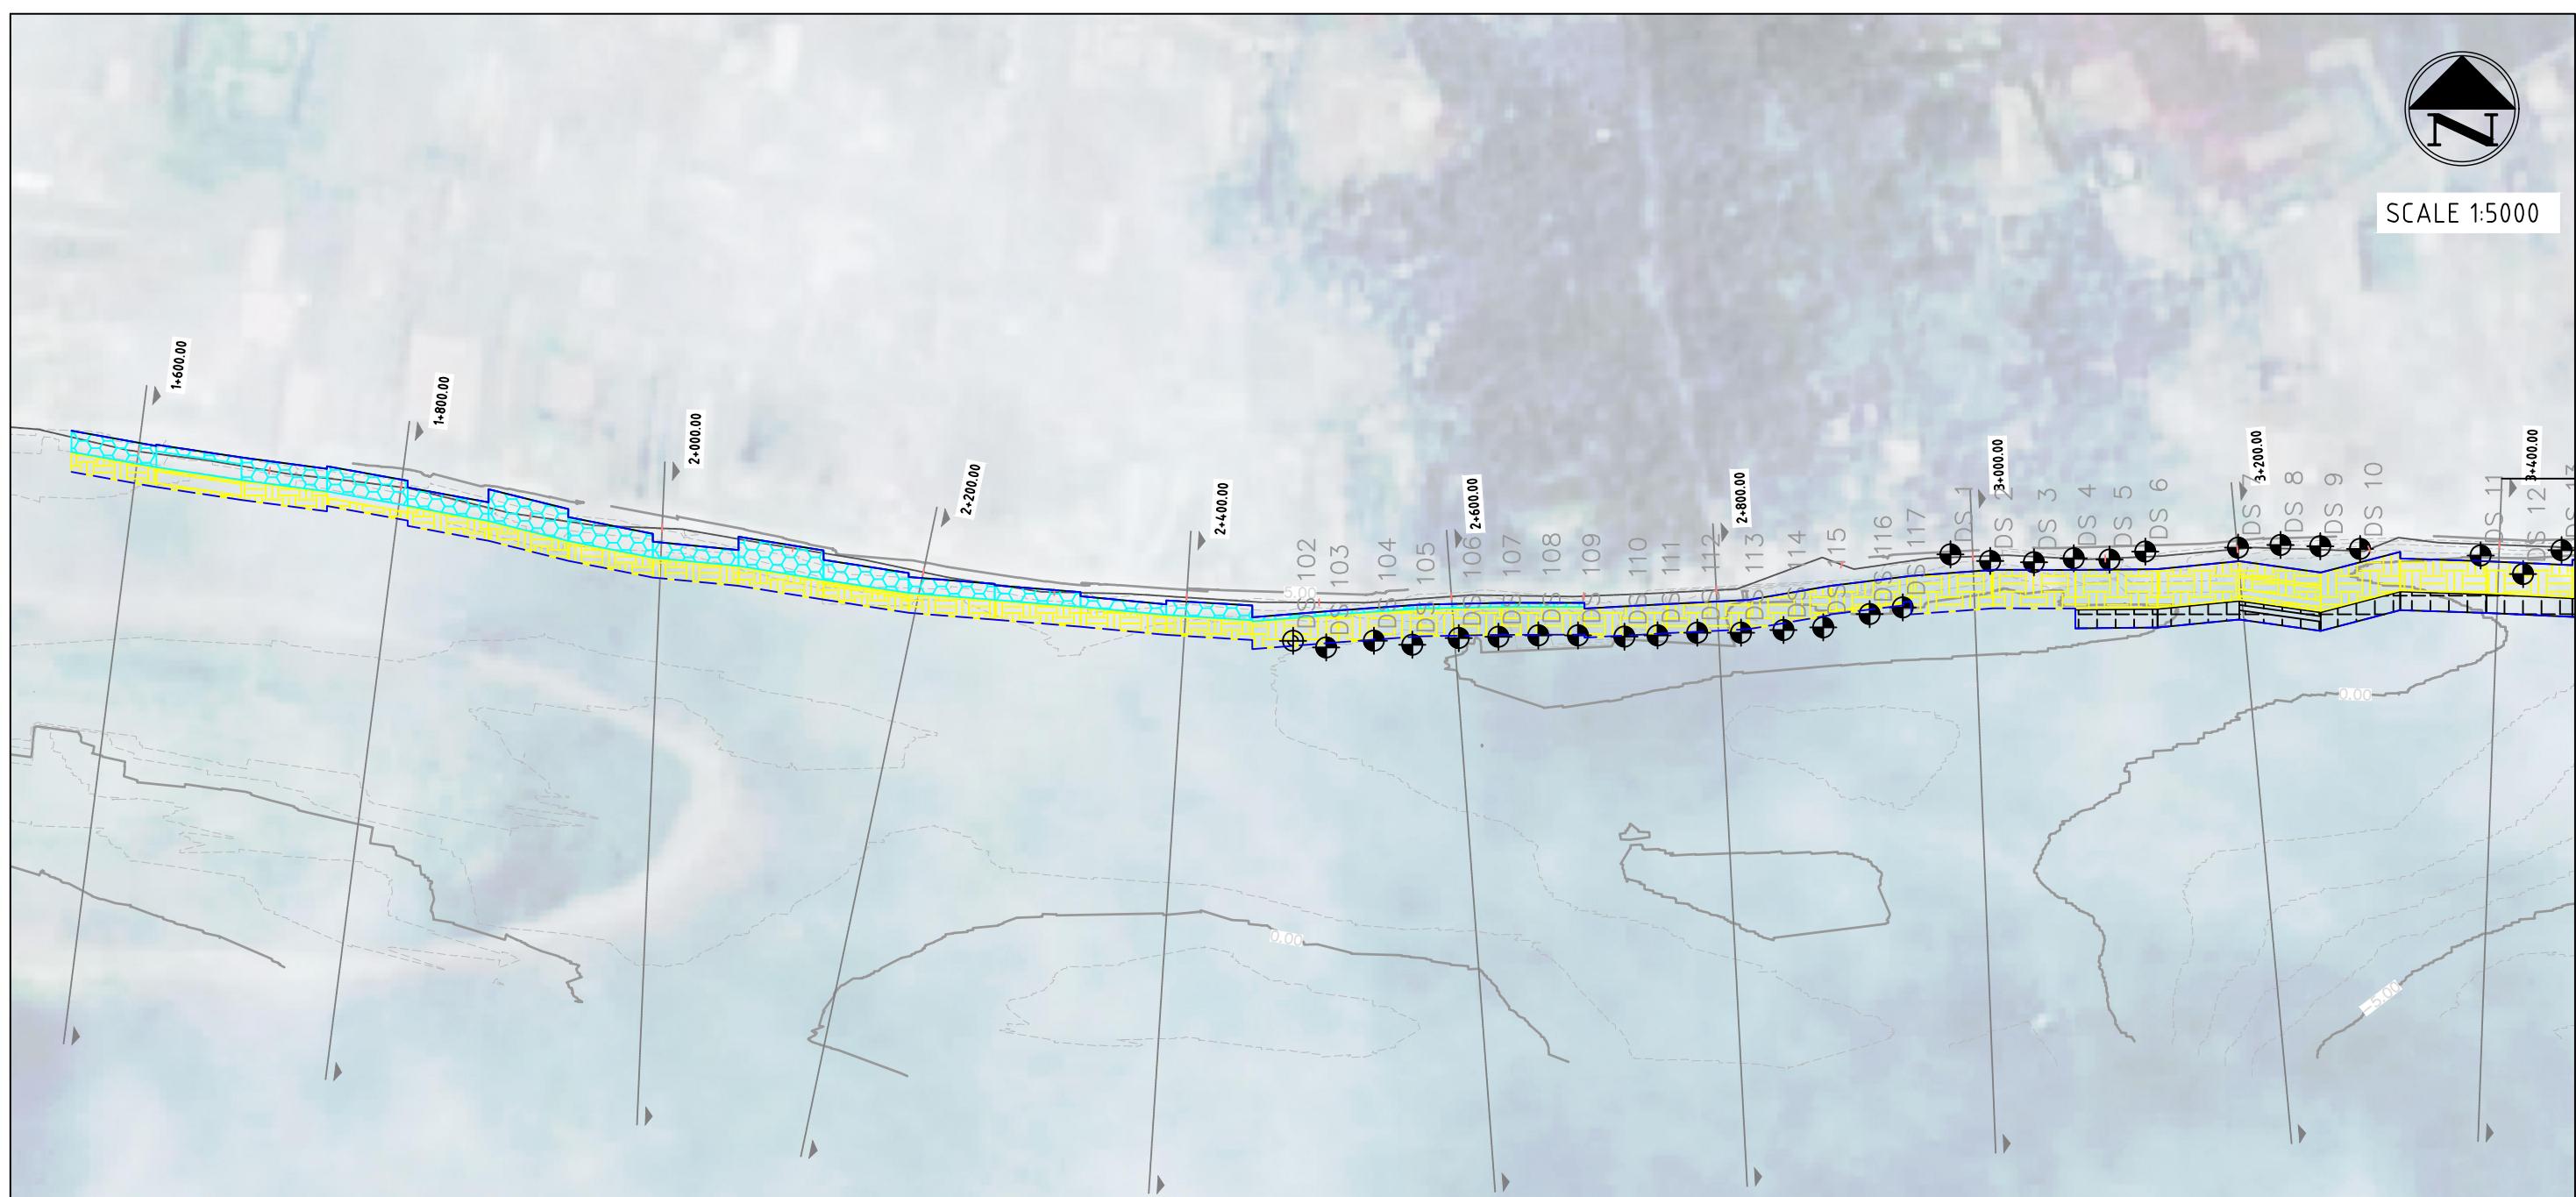

## NOTES:

1. INTERIM CONSTRUCTION COMPLETION REPORT FOR DIVING CROSS SECTION INFORMATION
2. TOPOGRAPHIC SURVEY OF UPPER BANK ie HWL TO CREST, NOT INCLUDED IN CONSTRUCTION COMPLETION DRAWINGS.  
WILL BE SURVEYED FOLLOWING CC BLOCK PLACEMENT

## LEGENDS:

5 DUMPED BAGS PER ROW

4 DUMPED BAGS PER ROW

3 DUMPED BAGS PER ROW

2 DUMPED BAGS PER ROW

DIVING CROSS SECTION LOCATION

EXTENT OF GEOTEXTILE BAG DUMPING

This drawing is confidential and shall only be used for the purposes of this project.

THE SIGNING OF THIS TITLE BLOCK CONFIRMS THE DESIGN AND DRAFTING  
OF THIS PROJECT HAVE BEEN PREPARED AND CHECKED

SCALES:

AS SHOWN IN THE DRAWING

CLIENT:



BANGLADESH WATER DEVELOPMENT BOARD

CONSULTANT

**nhc**  
 northwest hydraulic consultants  
*Matt MacDonald*

FLOOD AND RIVERBANK EROSION RISK MANAGEMENT INVESTMENT PROGRAM

DRAWING NAME:

PLAN VIEW FROM CH 1+600 TO CH 3+400

STATUS: AS BUILT\_JULY 2016

DRAWING NO:


FRERMIP-ISPMC-HAR-04

REVISION: 0

0	MYA	26.07.2016	FIRST DRAFT	KO
No.	BY	DATE	DESCRIPTION	APPD



SCALE 1:5000

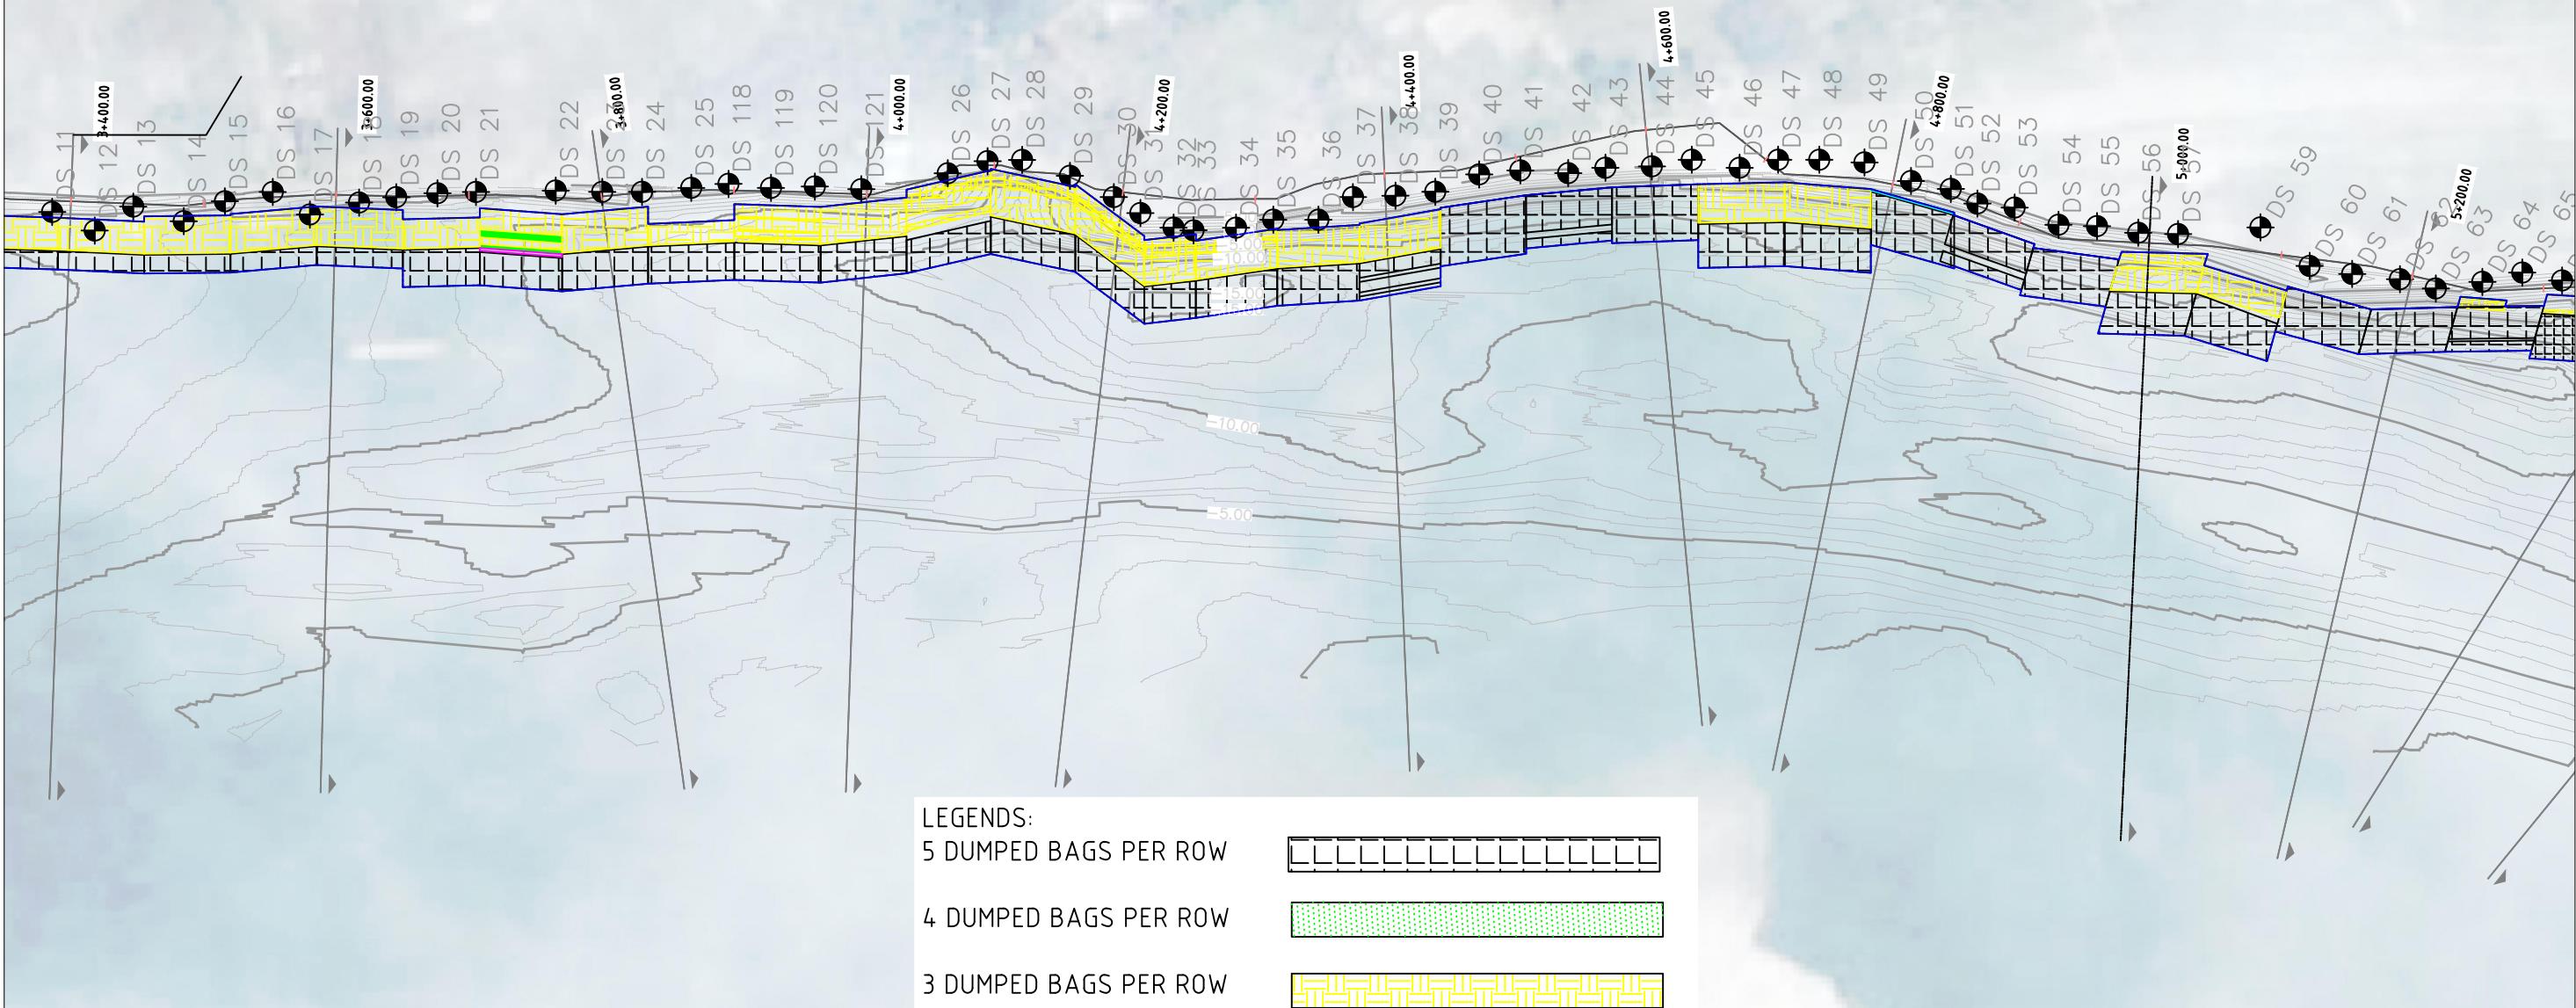**NOTES:**

1. INTERIM CONSTRUCTION COMPLETION REPORT FOR DIVING CROSS SECTION INFORMATION

2. TOPOGRAPHIC SURVEY OF UPPER BANK ie HWL TO CREST, NOT INCLUDED IN CONSTRUCTION COMPLETION DRAWINGS.

WILL BE SURVEYED FOLLOWING CC BLOCK PLACEMENT

DIVING CROSS SECTION LOCATION



EXTENT OF GEOTEXTILE BAG DUMPING

This drawing is confidential and shall only be used for the purposes of this project.

THE SIGNING OF THIS TITLE BLOCK CONFIRMS THE DESIGN AND DRAFTING OF THIS PROJECT HAVE BEEN PREPARED AND CHECKED

SCALES:

AS SHOWN IN THE DRAWING

CLIENT:



BANGLADESH WATER DEVELOPMENT BOARD

CONSULTANT

**nhc**  
 northwest hydraulic consultants  
*Mott MacDonald*

FLOOD AND RIVERBANK EROSION RISK MANAGEMENT INVESTMENT PROGRAM

DRAWING NAME:

PLAN VIEW FROM CH 3+400 TO CH 5+200

STATUS: AS BUILT\_JULY 2016

DRAWING NO:

FRERMIP-ISPMC-HAR-05

REVISION: 0

0	MYA	26.07.2016	FIRST DRAFT	KO
No.	BY	DATE	DESCRIPTION	APPD



SCALE 1:5000



This drawing is confidential and shall only be used for the purposes of this project.

THE SIGNING OF THIS TITLE BLOCK CONFIRMS THE DESIGN AND DRAFTING  
OF THIS PROJECT HAVE BEEN PREPARED AND CHECKED

SCALES:


AS SHOWN IN THE DRAWING

CLIENT:



BANGLADESH WATER DEVELOPMENT BOARD

CONSULTANT

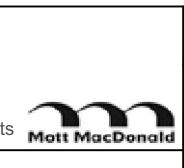

FLOOD AND RIVERBANK EROSION RISK MANAGEMENT INVESTMENT PROGRAM

DRAWING NAME:

PLAN VIEW FROM CH 5+200 TO CH 7+200

DRAWING NO:


FRERMIP-ISPMC-HAR-06

REVISION: 0

0	MYA	26.07.2016	FIRST DRAFT	KO
No.	BY	DATE	DESCRIPTION	APPD



SCALE 1:5000

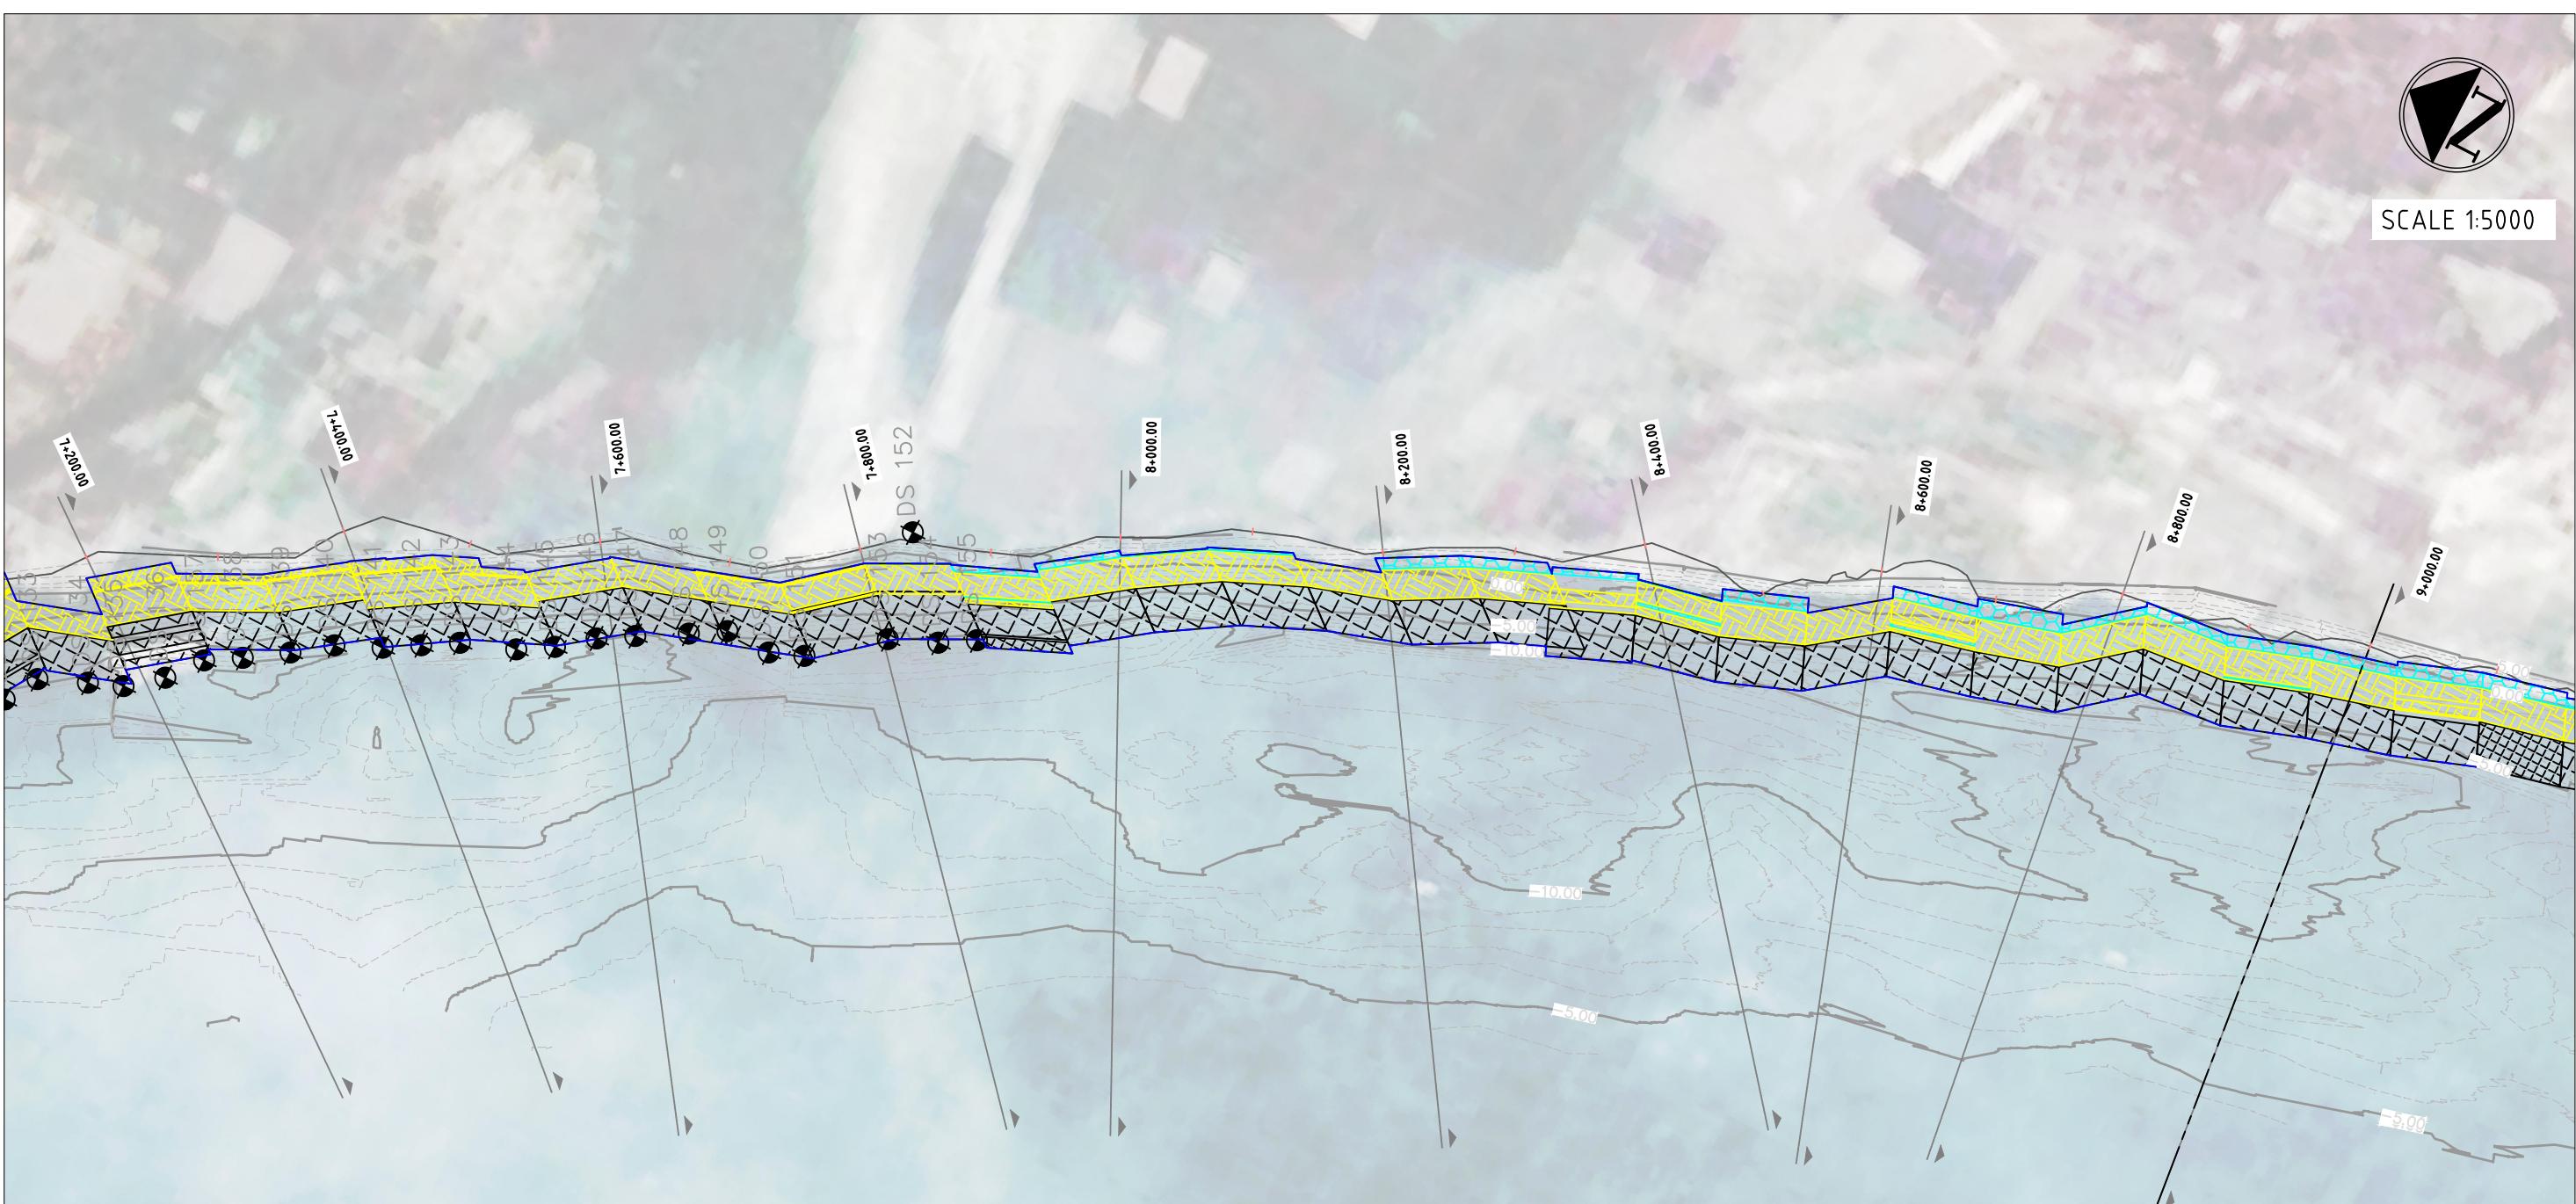

## LEGENDS:

5 DUMPED BAGS PER ROW



4 DUMPED BAGS PER ROW



3 DUMPED BAGS PER ROW



2 DUMPED BAGS PER ROW



DIVING CROSS SECTION LOCATION



EXTENT OF GEOTEXTILE BAG DUMPING

NOTES:  
 1. INTERIM CONSTRUCTION COMPLETION REPORT FOR DIVING CROSS SECTION INFORMATION  
 2. TOPOGRAPHIC SURVEY OF UPPER BANK ie HWL TO CREST, NOT INCLUDED IN CONSTRUCTION COMPLETION DRAWINGS.  
 WILL BE SURVEYED FOLLOWING CC BLOCK PLACEMENT

This drawing is confidential and shall only be used for the purposes of this project.

THE SIGNING OF THIS TITLE BLOCK CONFIRMS THE DESIGN AND DRAFTING OF THIS PROJECT HAVE BEEN PREPARED AND CHECKED

SCALES:

FLOOD AND RIVERBANK EROSION RISK MANAGEMENT INVESTMENT PROGRAM

DRAWING NAME:

PLAN VIEW FROM CH 7+200 TO CH 9+000



BANGLADESH WATER DEVELOPMENT BOARD

northwest hydraulic consultants  
Mott MacDonald

STATUS: AS BUILT\_JULY 2016

DRAWING NO:

FRERMIP-ISPMC-HAR-07

REVISION: 0

0	MYA	20.07.2016	FIRST DRAFT	KO
No.	BY	DATE	DESCRIPTION	APPD


DESIGNED	MYA	CHECKED	GV
DRAWN	MYA	CHECKED	GV
APPROVED	KO	DATE	

SHEET NO:

AS SHOWN IN THE DRAWING



SCALE 1:5000

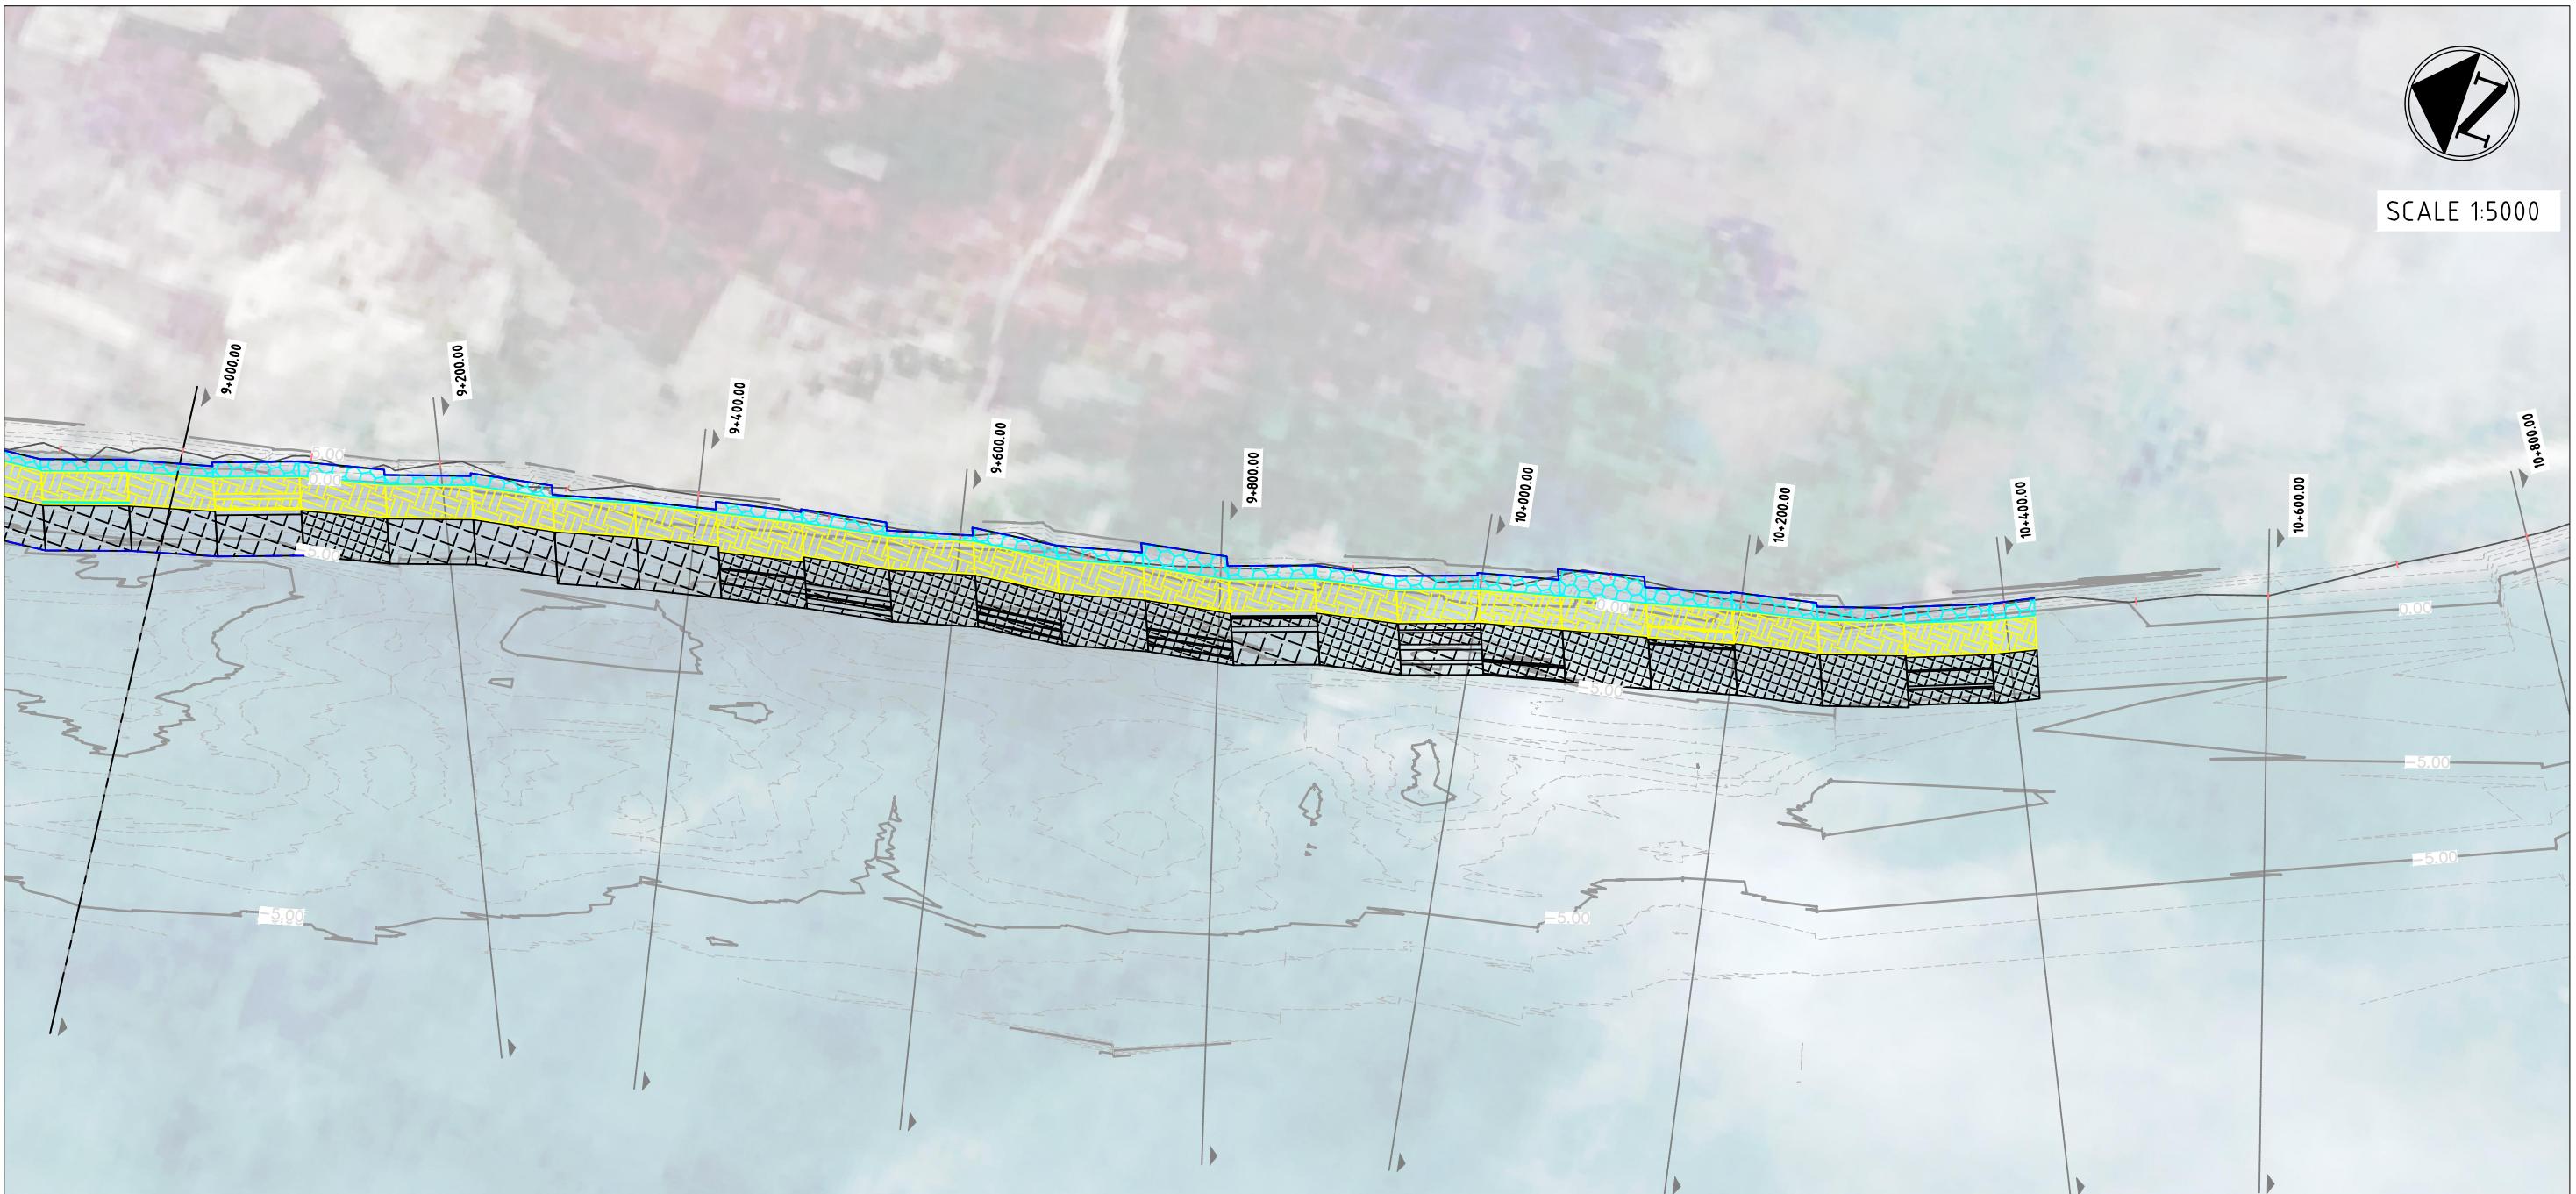

## LEGENDS:

5 DUMPED BAGS PER ROW

4 DUMPED BAGS PER ROW

3 DUMPED BAGS PER ROW

2 DUMPED BAGS PER ROW

DIVING CROSS SECTION LOCATION

EXTENT OF GEOTEXTILE BAG DUMPING

## NOTES:

1. INTERIM CONSTRUCTION COMPLETION REPORT FOR DIVING CROSS SECTION INFORMATION
2. TOPOGRAPHIC SURVEY OF UPPER BANK ie HWL TO CREST, NOT INCLUDED IN CONSTRUCTION COMPLETION DRAWINGS.  
WILL BE SURVEYED FOLLOWING CC BLOCK PLACEMENT

This drawing is confidential and shall only be used for the purposes of this project.

THE SIGNING OF THIS TITLE BLOCK CONFIRMS THE DESIGN AND DRAFTING  
OF THIS PROJECT HAVE BEEN PREPARED AND CHECKED

SCALES:

AS SHOWN IN THE DRAWING

CLIENT:



BANGLADESH WATER DEVELOPMENT BOARD

CONSULTANT

**nhc**  
 northwest hydraulic consultants  
*Mott MacDonald*

FLOOD AND RIVERBANK EROSION RISK MANAGEMENT INVESTMENT PROGRAM

DRAWING NAME:

PLAN VIEW FROM CH 9+000 TO CH 10+600

STATUS: AS BUILT\_JULY 2016

DRAWING NO:


FRERMIP-ISPMC-HAR-08

REVISION: 0

0	MYA	26.07.2016	FIRST DRAFT	KO
No.	BY	DATE	DESCRIPTION	APPD



SCALE 1:5000

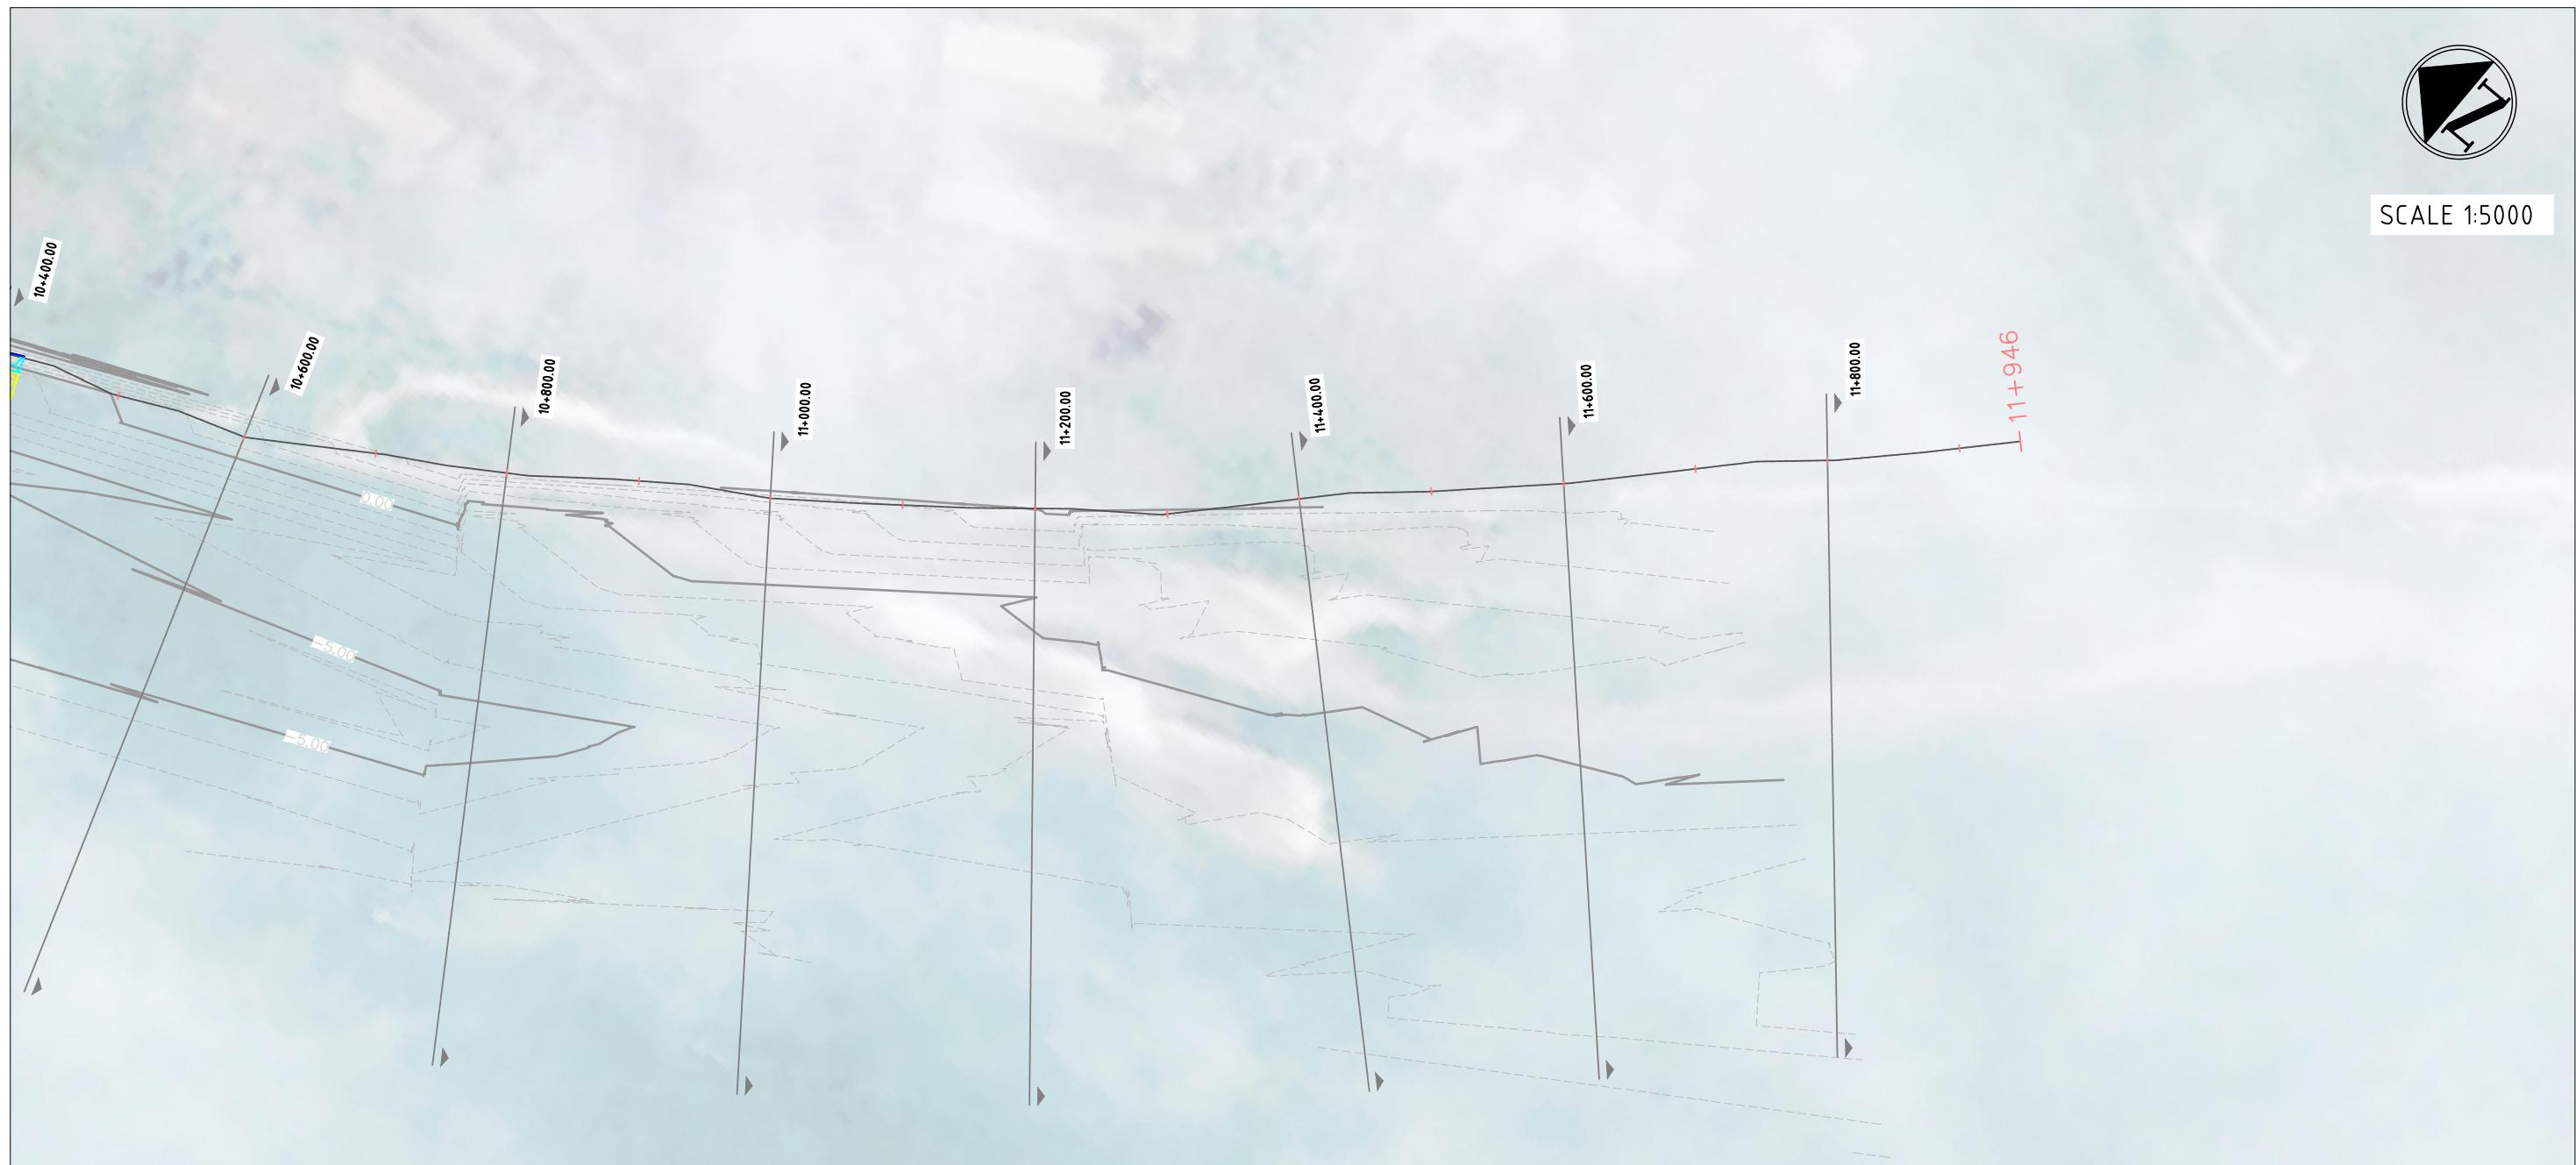

NOTES:

1. INTERIM CONSTRUCTION COMPLETION REPORT FOR DIVING CROSS SECTION INFORMATION
2. TOPOGRAPHIC SURVEY OF UPPER BANK ie HWL TO CREST, NOT INCLUDED IN CONSTRUCTION COMPLETION DRAWINGS. WILL BE SURVEYED FOLLOWING CC BLOCK PLACEMENT

## LEGENDS:

5 DUMPED BAGS PER ROW



4 DUMPED BAGS PER ROW



3 DUMPED BAGS PER ROW



2 DUMPED BAGS PER ROW



DIVING CROSS SECTION LOCATION



EXTENT OF GEOTEXTILE BAG DUMPING



This drawing is confidential and shall only be used for the purposes of this project.

THE SIGNING OF THIS TITLE BLOCK CONFIRMS THE DESIGN AND DRAFTING  
OF THIS PROJECT HAVE BEEN PREPARED AND CHECKED

SCALES:

AS SHOWN IN THE DRAWING

CLIENT:



BANGLADESH WATER DEVELOPMENT BOARD

CONSULTANT

**nhc**  
 northwest hydraulic consultants  
*Mott MacDonald*

FLOOD AND RIVERBANK EROSION RISK MANAGEMENT INVESTMENT PROGRAM

DRAWING NAME:

PLAN VIEW FROM CH 10+600 TO CH 11+800

STATUS: AS BUILT\_JULY 2016

DRAWING NO:

FRERMIP-ISPMC-HAR-09

REVISION: 0

0	MYA	26.07.2016	FIRST DRAFT	KO
No.	BY	DATE	DESCRIPTION	APPD




## LEGENDS:

## PRE-CONSTRUCTION SURVEY

## JUNE MONITORING SURVEY

## AS-BUILT SURVEY

This drawing is confidential and shall only be used for the purposes of this project.				THE SIGNING OF THIS TITLE BLOCK CONFIRMS THE DESIGN AND DRAFTING OF THIS PROJECT HAVE BEEN PREPARED AND CHECKED				SHEET NO: 10	BANGLADESH WATER DEVELOPMENT BOARD	CLIENT: 	CONSULTANT <b>nhc</b> northwest hydraulic consultants	FLOOD AND RIVERBANK EROSION RISK MANAGEMENT INVESTMENT PROGRAM					
		DESIGNED	MYA	CHECKED	GV	DRAWN	MYA					CHECKED	GV	DRAWING NAME: SECTION VIEW FROM CH 0+000 TO CH 1+400			
		APPROVED	KO	DATE										STATUS: AS BUILT_JULY 2016			
0	MYA	26.07.2016	FIRST DRAFT	KO										DRAWING NO: FRERMIP-ISPMC-HAR-10			
No.	BY	DATE	DESCRIPTION	APPD						REVISION: 0							

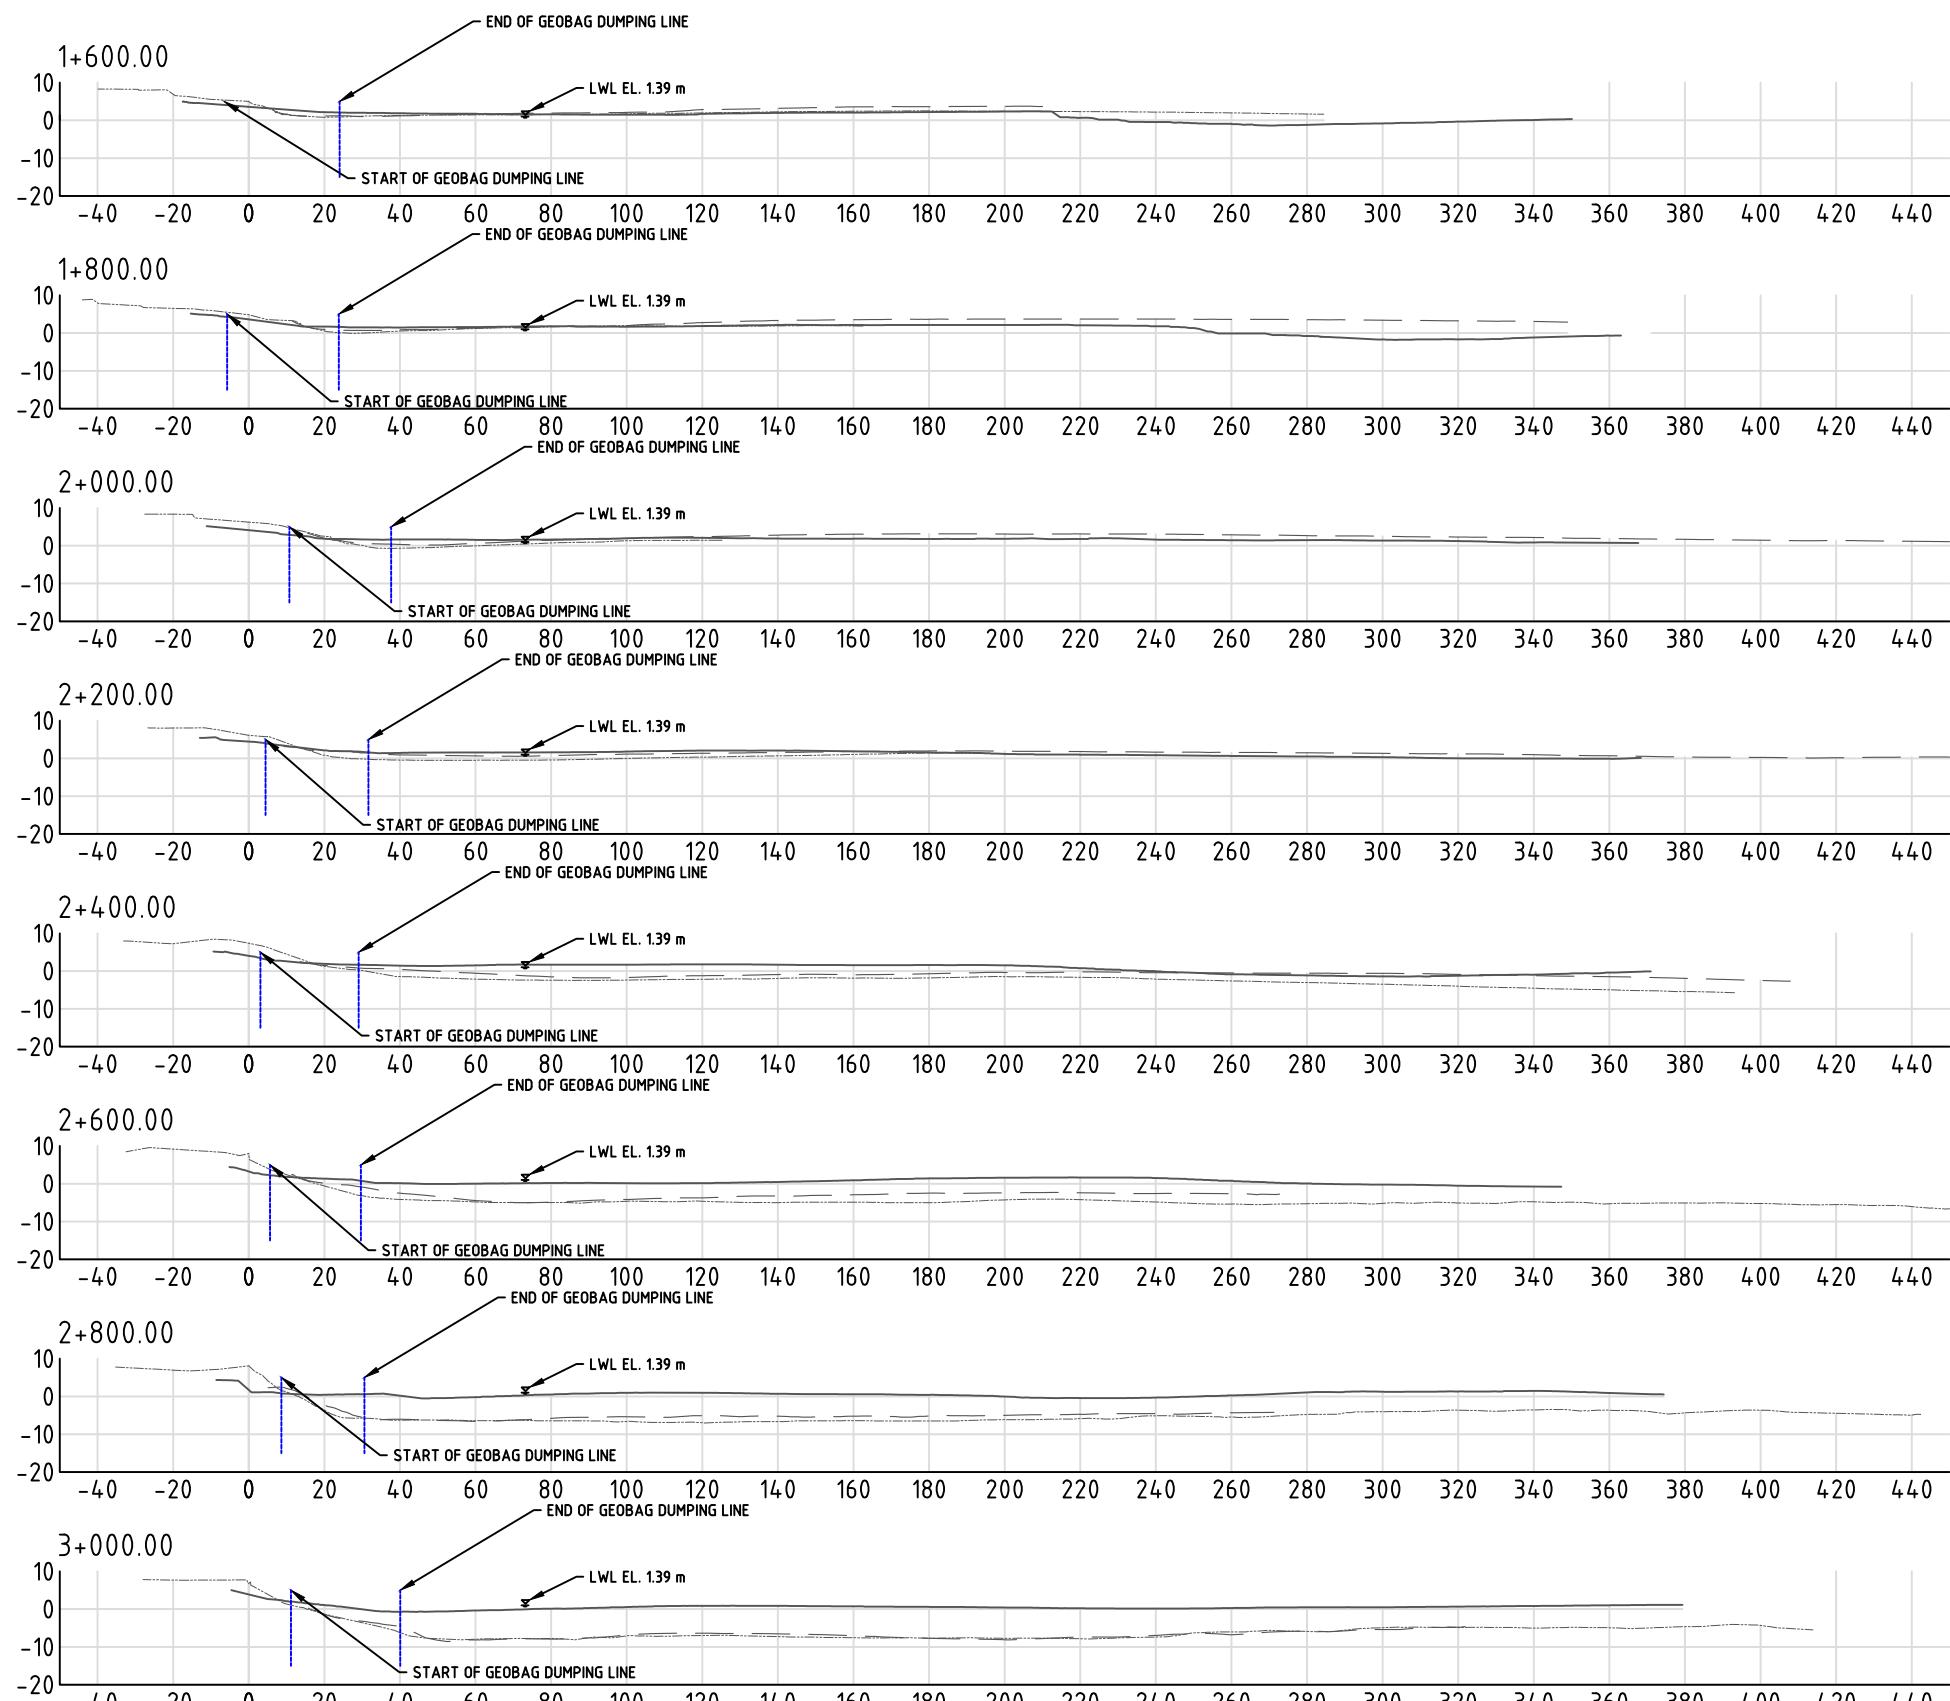


## LEGENDS:

PRE-CONSTRUCTION SURVEY

## JUNE MONITORING SURVEY

## AS-BUILT SURVEY

This drawing is confidential and shall only be used for the purposes of this project.				THE SIGNING OF THIS TITLE BLOCK CONFIRMS THE DESIGN AND DRAFTING OF THIS PROJECT HAVE BEEN PREPARED AND CHECKED				SCALES:  AS SHOWN IN THE DRAWING	CLIENT:  	CONSULTANT  <b>nhc</b> northwest hydraulic consultants	FLOOD AND RIVERBANK EROSION RISK MANAGEMENT INVESTMENT PROGRAM			
				DESIGNED	MYA	CHECKED	GV							
				DRAWN	MYA	CHECKED	GV							
				APPROVED	KO	DATE								
0	MYA	26.07.2016	FIRST DRAFT	KO							SHEET NO:	11	Mott MacDonald	
No.	BY	DATE	DESCRIPTION	APPD				STATUS:	AS BUILT_JULY 2016	DRAWING NO:	FRERMIP-ISPMC-HAR-11	REVISION:	0	

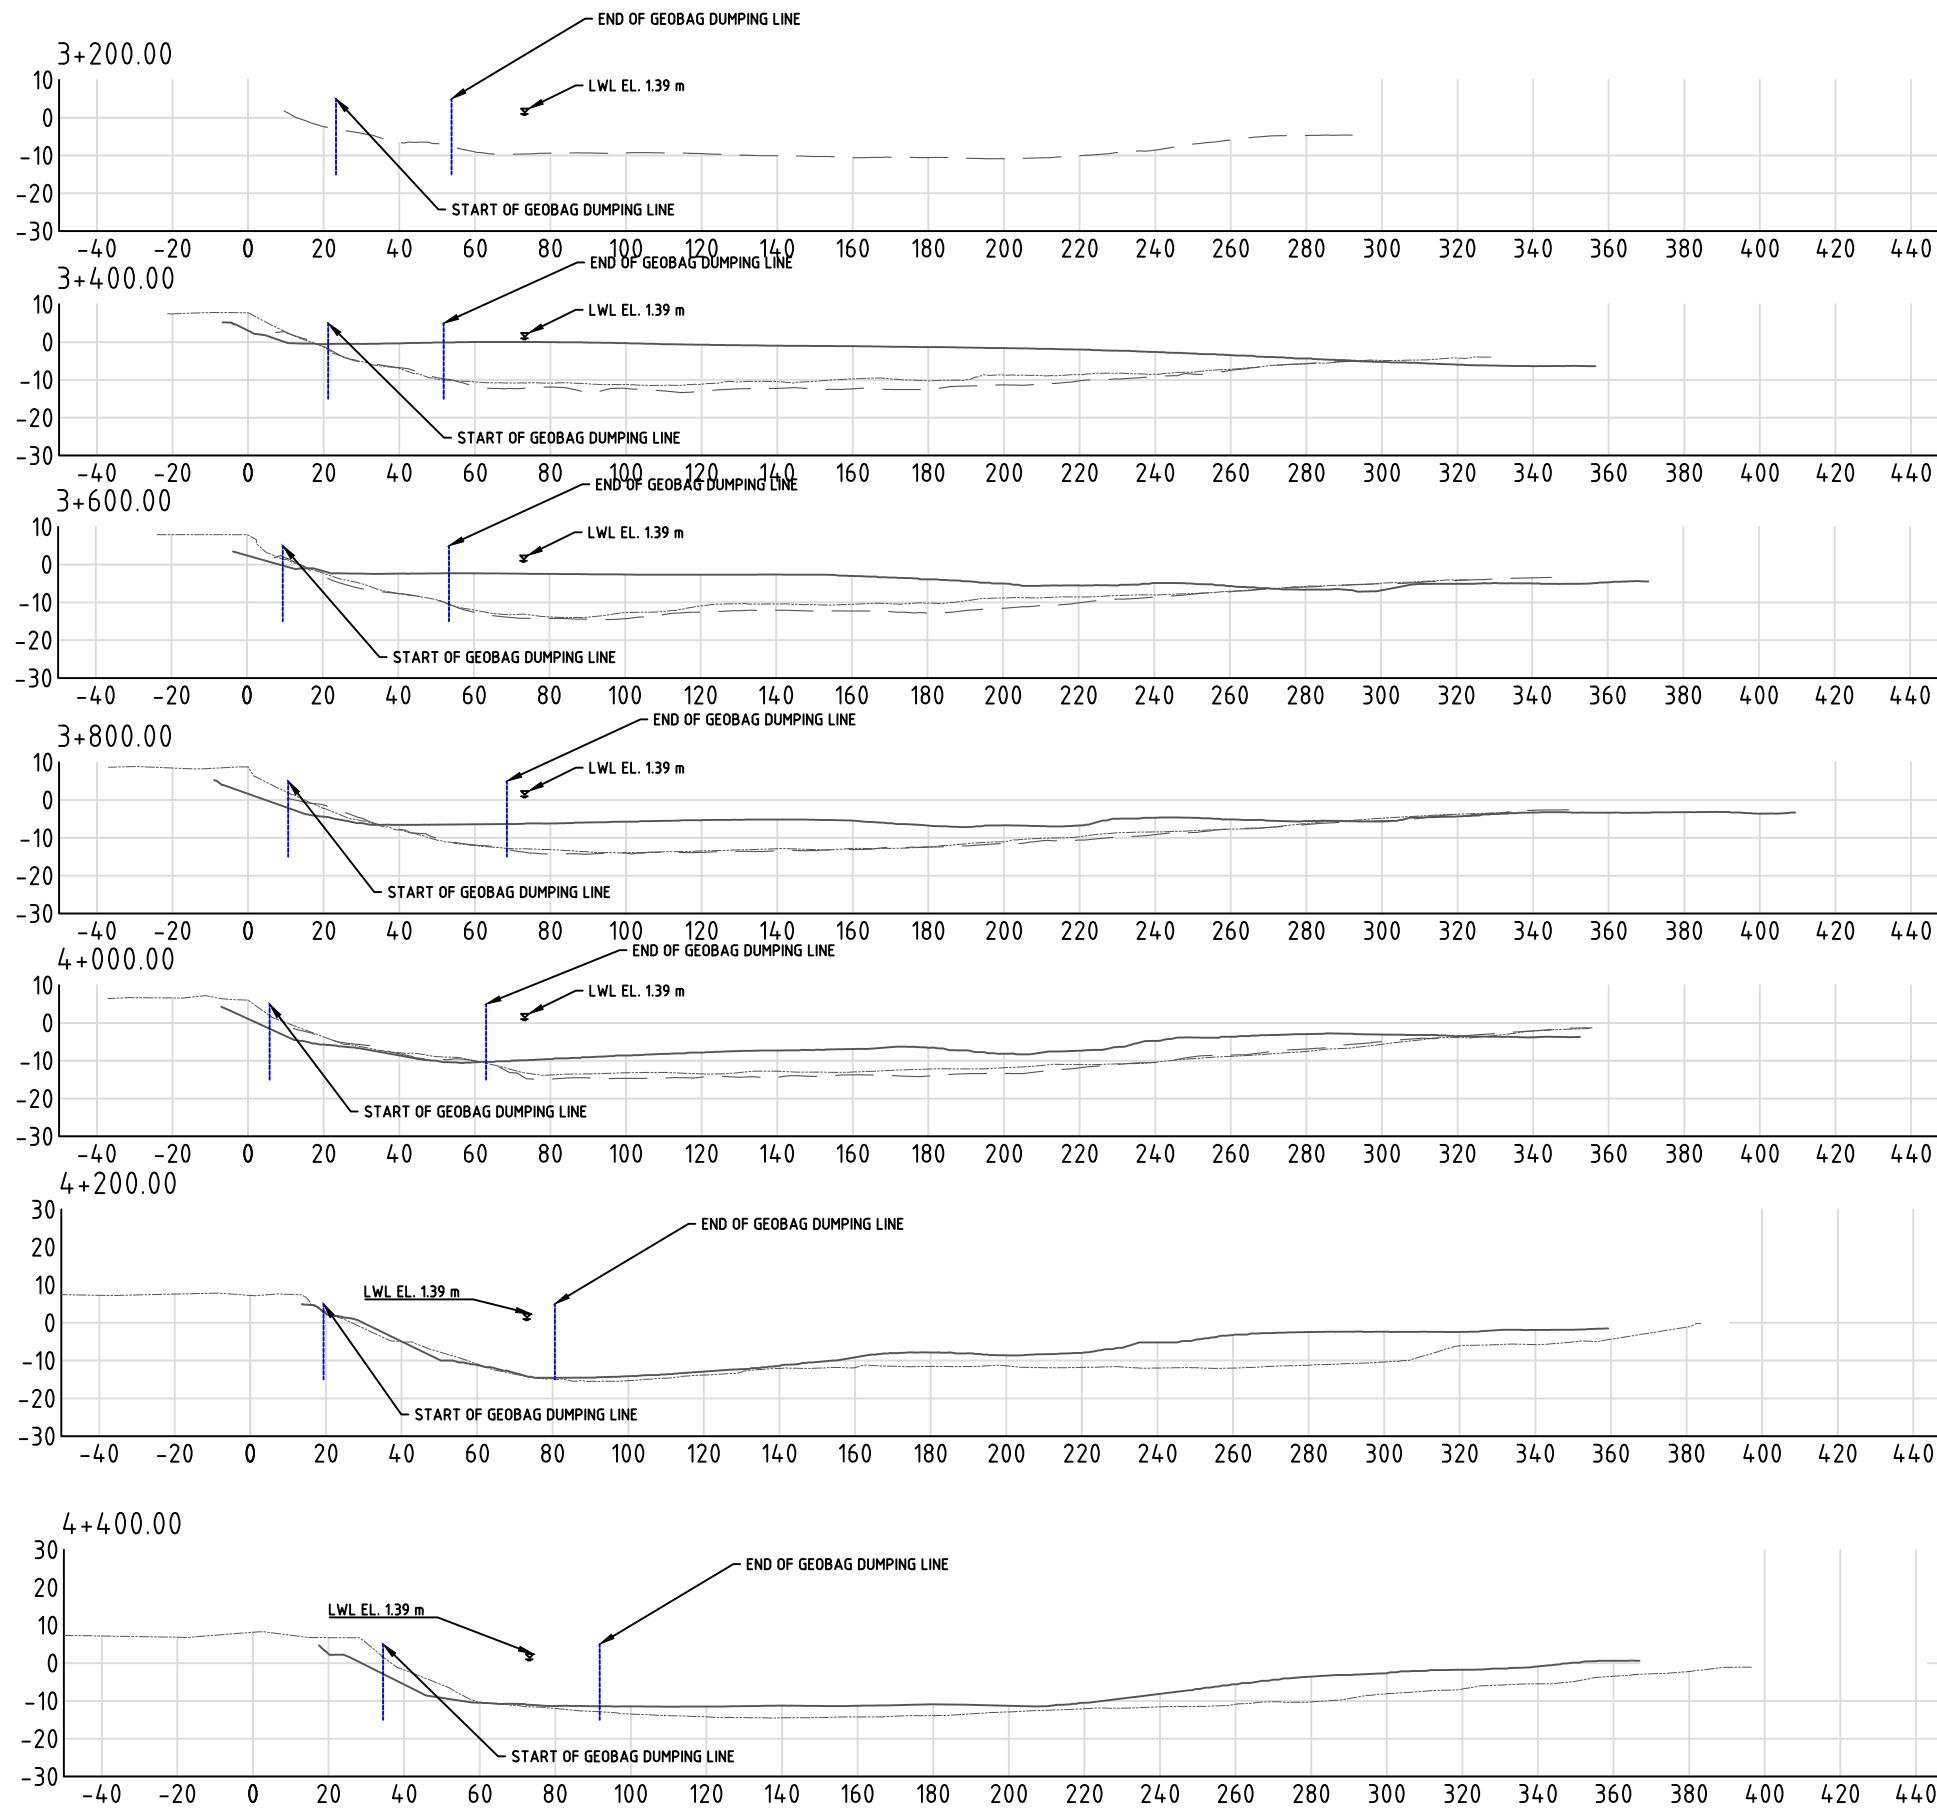

#### LEGENDS:

PRE-CONSTRUCTION SURVEY

JUNE MONITORING SURVEY

AS-BUILT SURVEY

This drawing is confidential and shall only be used for the purposes of this project.

THE SIGNING OF THIS TITLE BLOCK CONFIRMS THE DESIGN AND DRAFTING  
OF THIS PROJECT HAVE BEEN PREPARED AND CHECKED

SCALES:

AS SHOWN IN THE DRAWING

CLIENT:



CONSULTANT

**nhc**  
northwest hydraulic consultants

Mott MacDonald

FLOOD AND RIVERBANK EROSION RISK MANAGEMENT INVESTMENT PROGRAM

DRAWING NAME:

SECTION VIEW FROM CH 3+200 TO CH 4+400

0	MYA	26.07.2016	FIRST DRAFT	KO
No.	BY	DATE	DESCRIPTION	APPD

DESIGNED	MYA	CHECKED	GV
DRAWN	MYA	CHECKED	GV
APPROVED	KO	DATE	






SHEET NO.: 12

BANGLADESH WATER DEVELOPMENT BOARD

STATUS: AS BUILT\_JULY 2016

DRAWING NO: FRERMIP-ISPMC-HAR-12

REVISION: 0

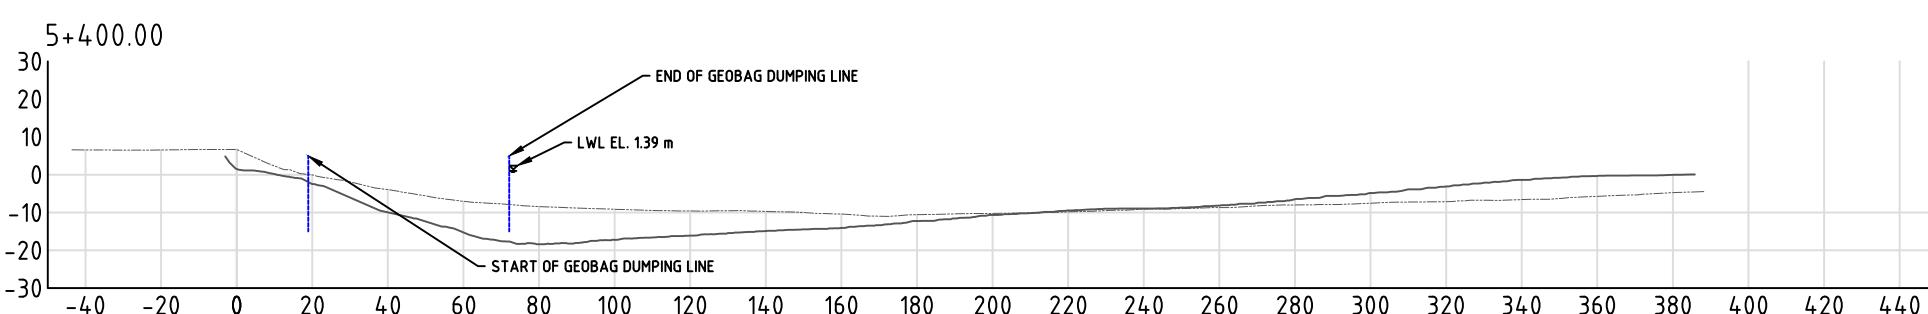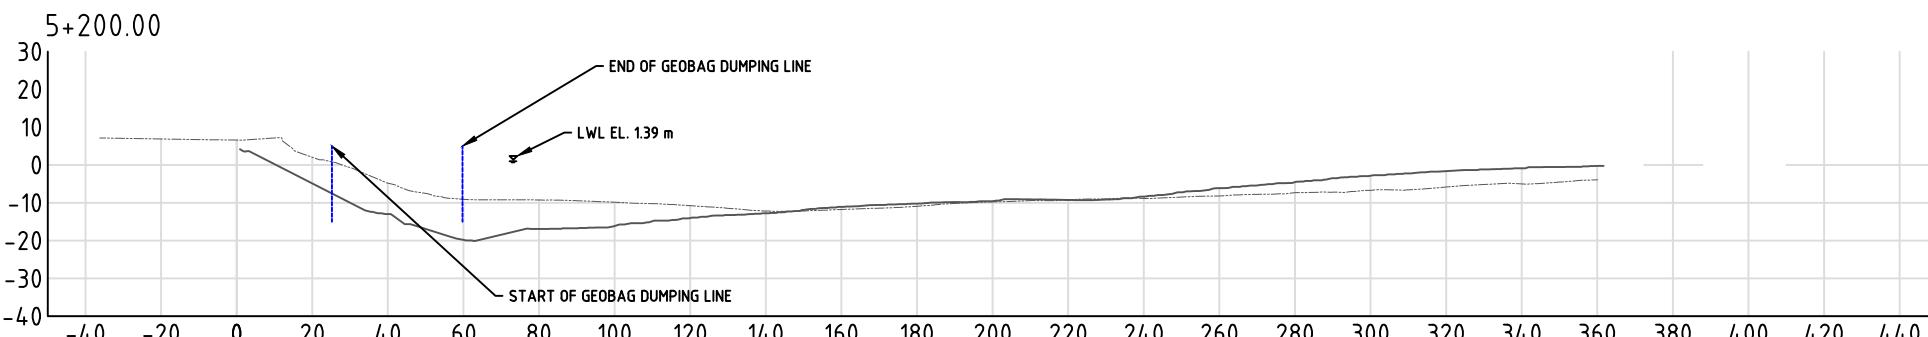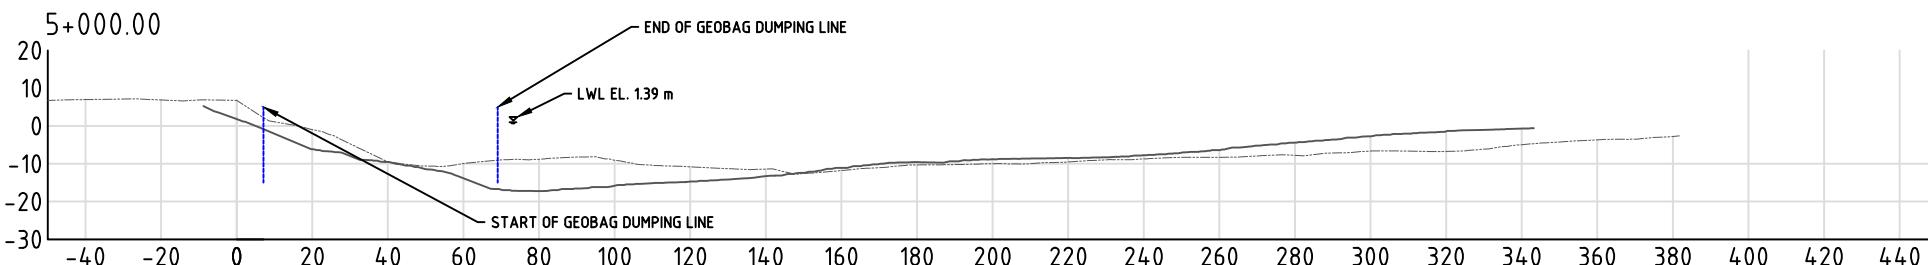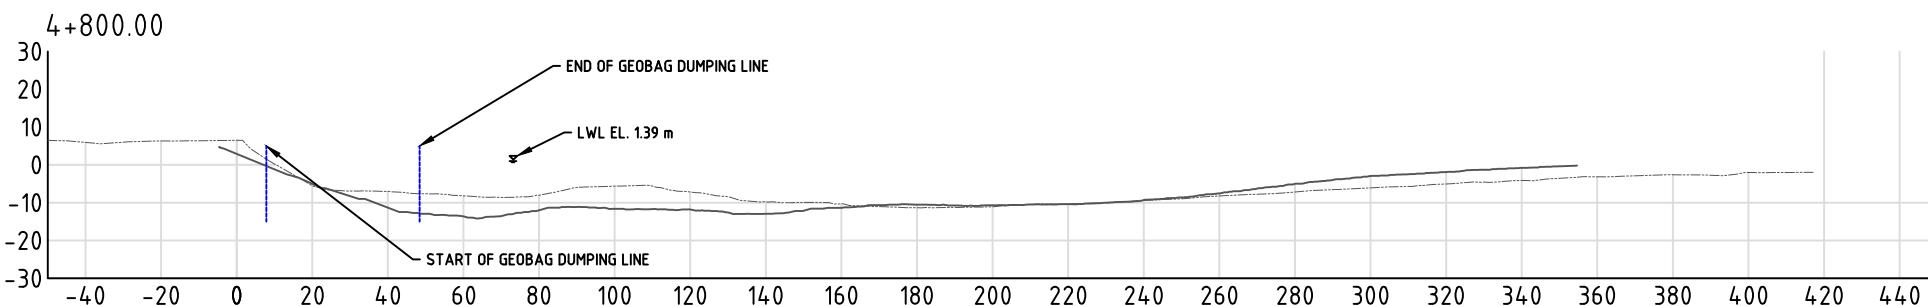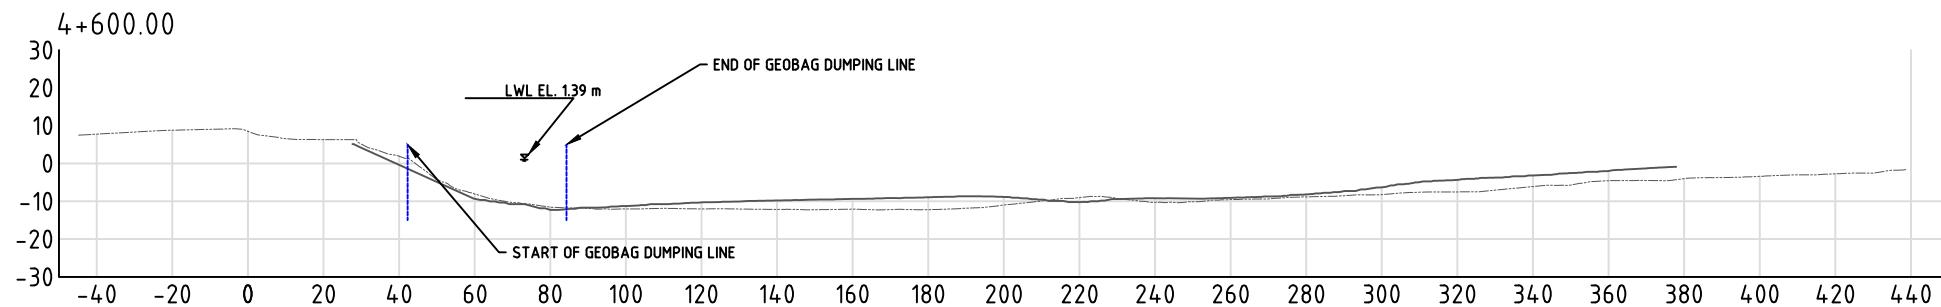

LEGENDS:

PRE-CONSTRUCTION SURVEY -----

JUNE MONITORING SURVEY - - - -

AS-BUILT SURVEY \_\_\_\_\_

This drawing is confidential and shall only be used for the purposes of this project.

THE SIGNING OF THIS TITLE BLOCK CONFIRMS THE DESIGN AND DRAFTING OF THIS PROJECT HAVE BEEN PREPARED AND CHECKED

SCALES:

CLIENT:

CONSULTANT:

DRAWN:

DESIGNED:

CHECKED:

APPROVED:

DATE:

MYA:


GV:



BANGLADESH WATER DEVELOPMENT BOARD

FLOOD AND RIVERBANK EROSION RISK MANAGEMENT INVESTMENT PROGRAM

DRAWING NAME:

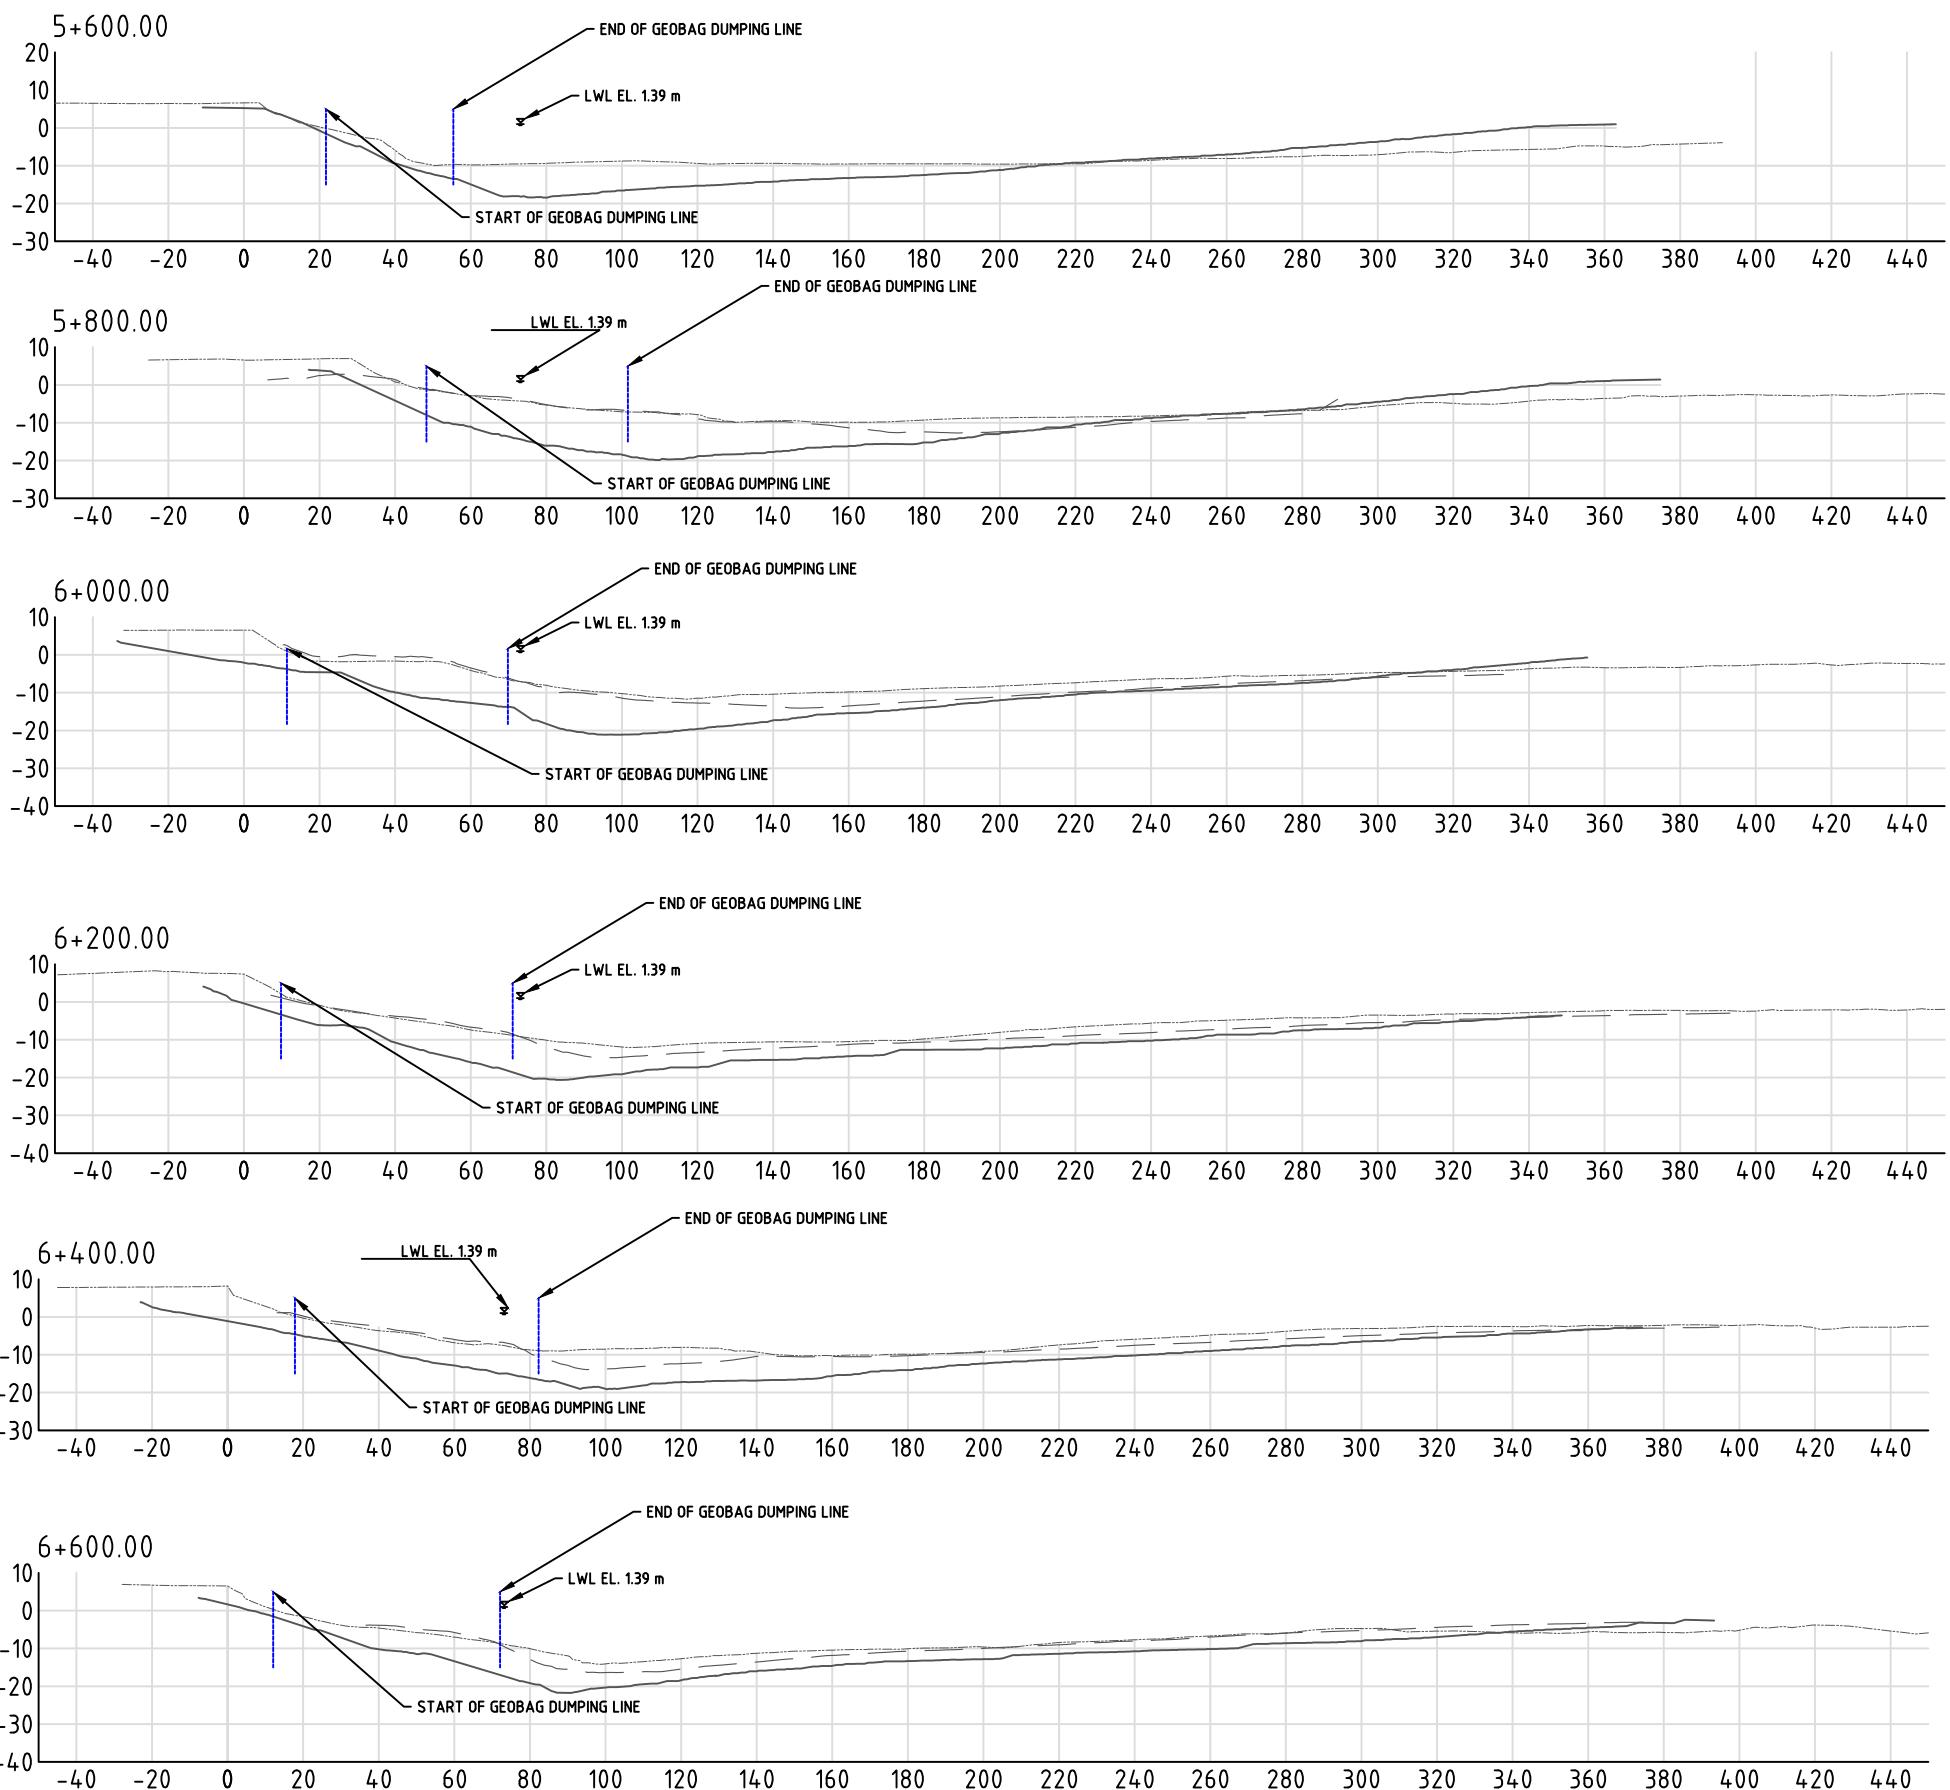


## LEGENDS:

## PRE-CONSTRUCTION SURVEY

JUNE MONITORING SURVEY

AS-BUILT SURVEY

This drawing is confidential and shall only be used for the purposes of this project.				THE SIGNING OF THIS TITLE BLOCK CONFIRMS THE DESIGN AND DRAFTING OF THIS PROJECT HAVE BEEN PREPARED AND CHECKED				SCALES:  AS SHOWN IN THE DRAWING	CLIENT:  	CONSULTANT  <b>nhc</b> northwest hydraulic consultants	FLOOD AND RIVERBANK EROSION RISK MANAGEMENT INVESTMENT PROGRAM			
				DESIGNED	MYA	CHECKED	GV							
				DRAWN	MYA	CHECKED	GV							
				APPROVED	KO	DATE								
0	MYA	26.07.2016	FIRST DRAFT	KO										
No.	BY	DATE	DESCRIPTION	APPD	SHEET NO.: 14				DRAWING NAME:  SECTION VIEW FROM CH 5+600 TO CH 6+600	STATUS:  AS BUILT_JULY 2016	DRAWING NO:  FRERMIP-ISPNC-HAR-14	REVISION:  0		

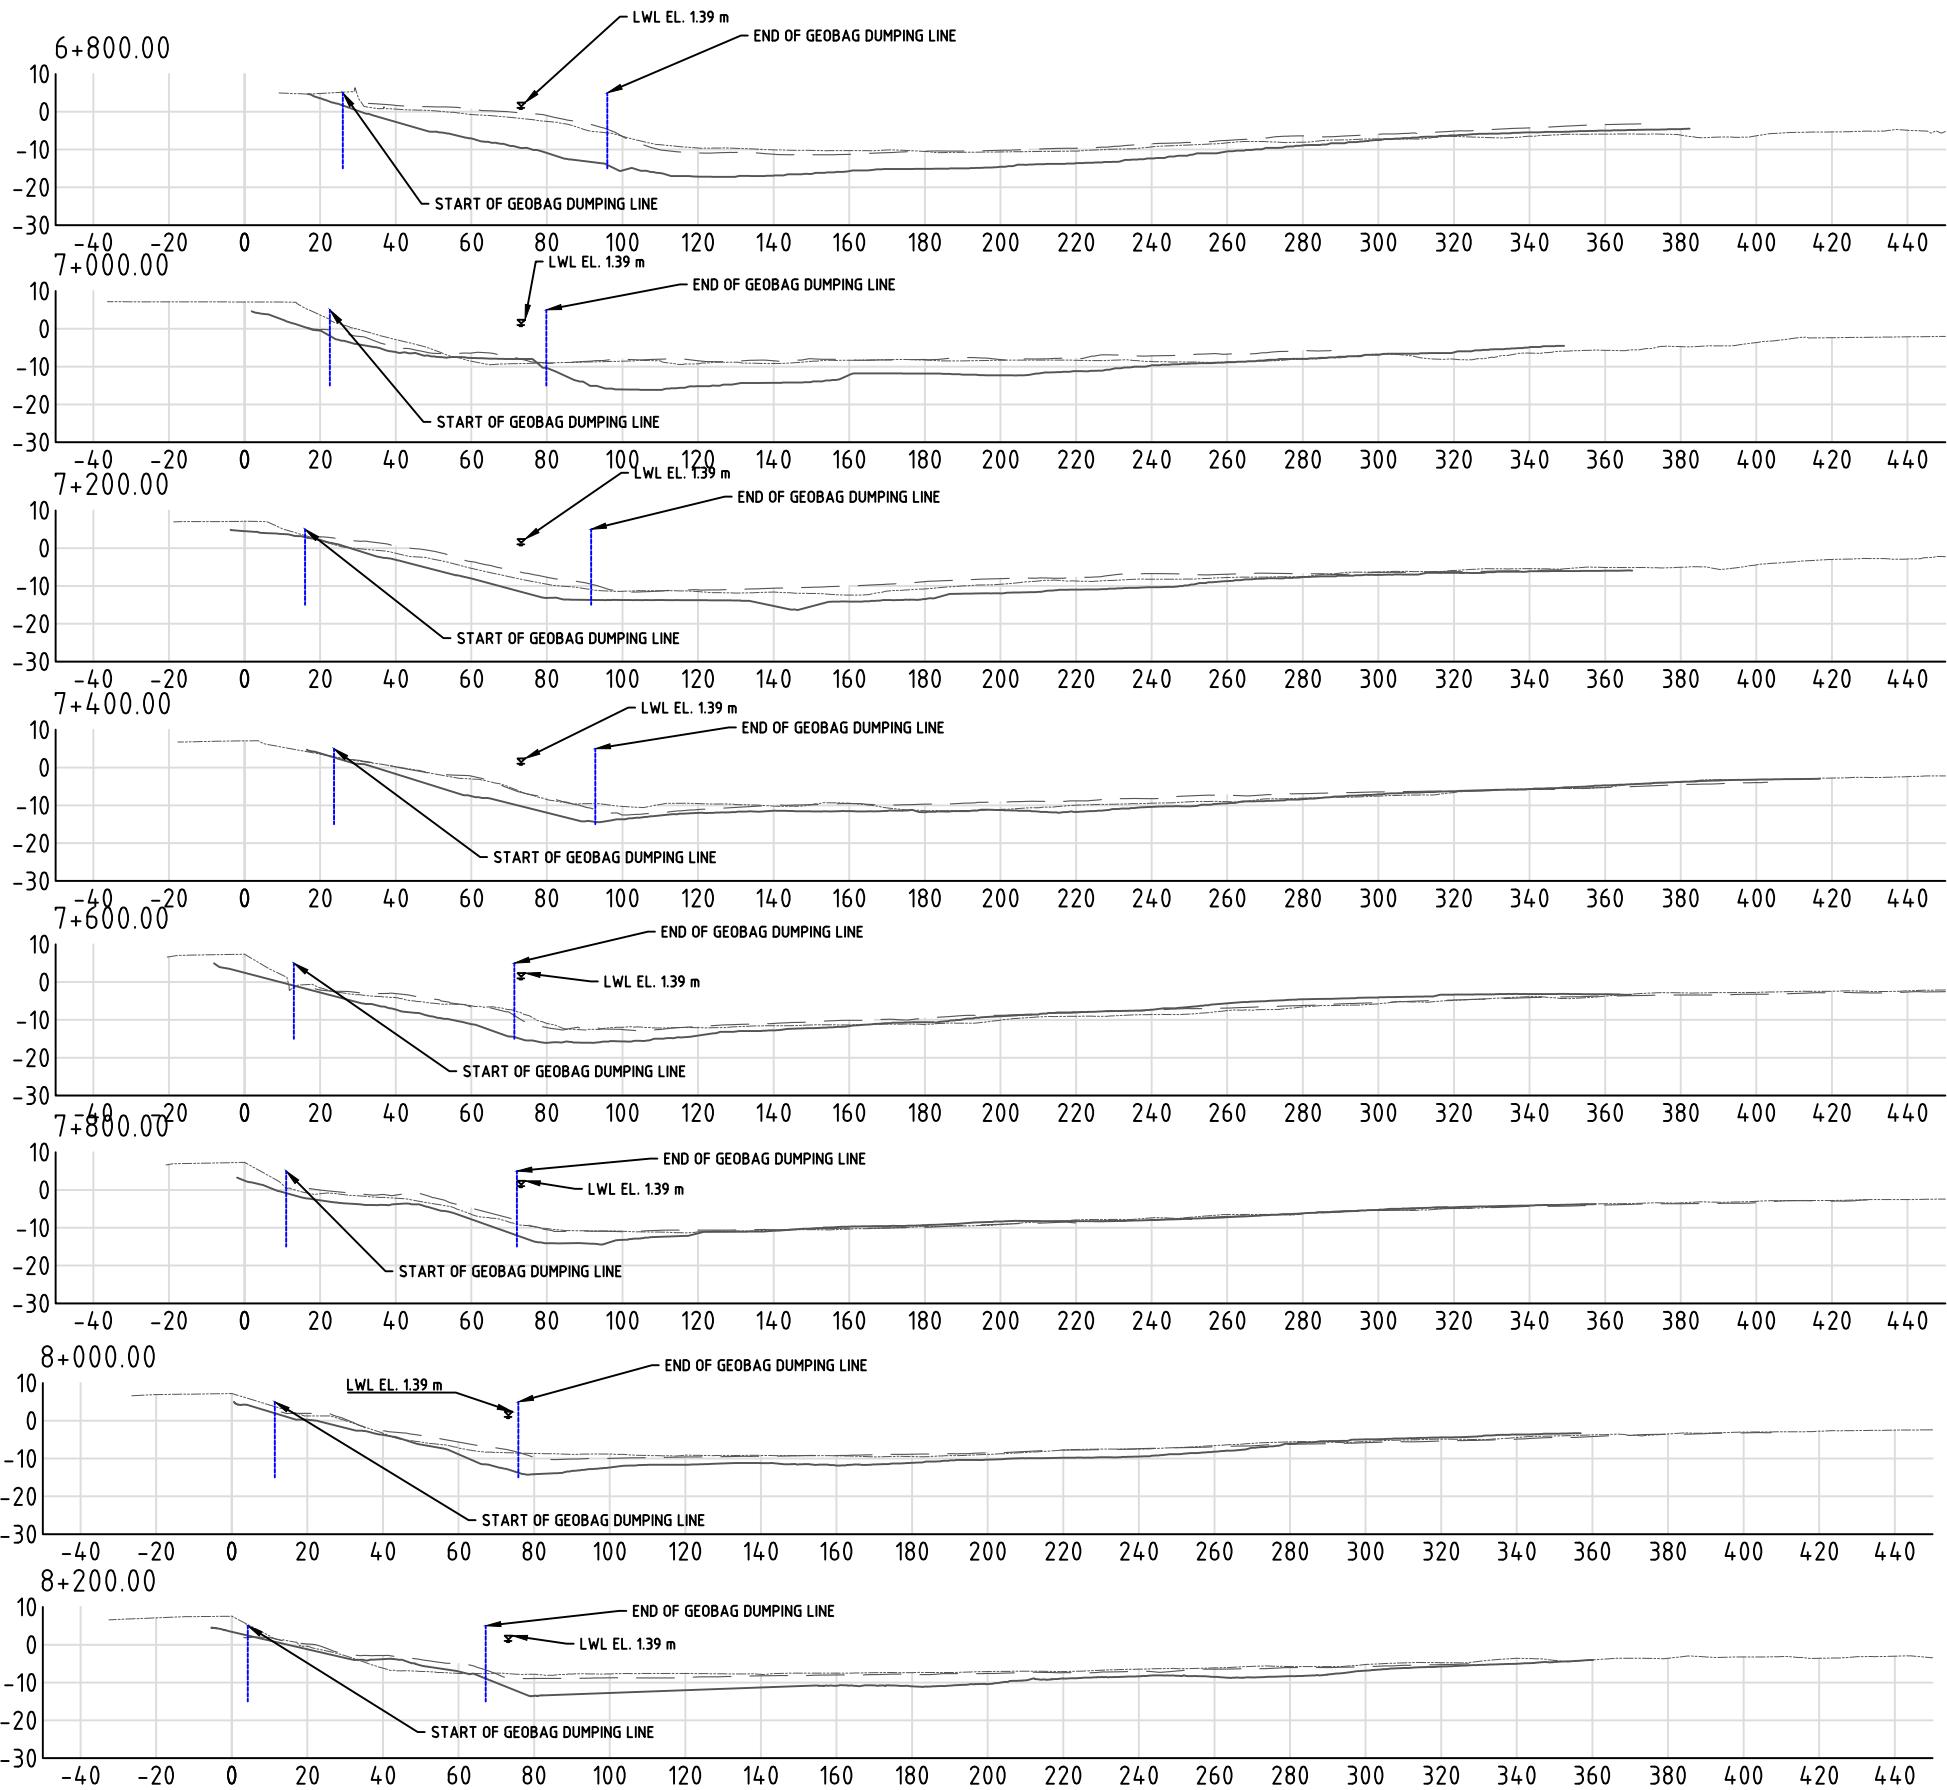

LEGENDS:

PRE-CONSTRUCTION SURVEY -----







JUNE MONITORING SURVEY -----

AS-BUILT SURVEY \_\_\_\_\_

This drawing is confidential and shall only be used for the purposes of this project.

THE SIGNING OF THIS TITLE BLOCK CONFIRMS THE DESIGN AND DRAFTING  
OF THIS PROJECT HAVE BEEN PREPARED AND CHECKED

SCALES:

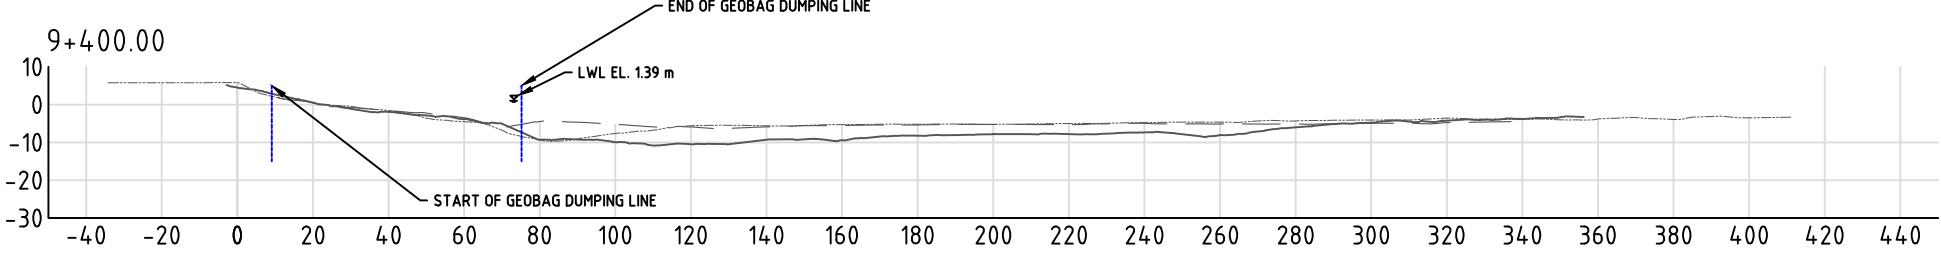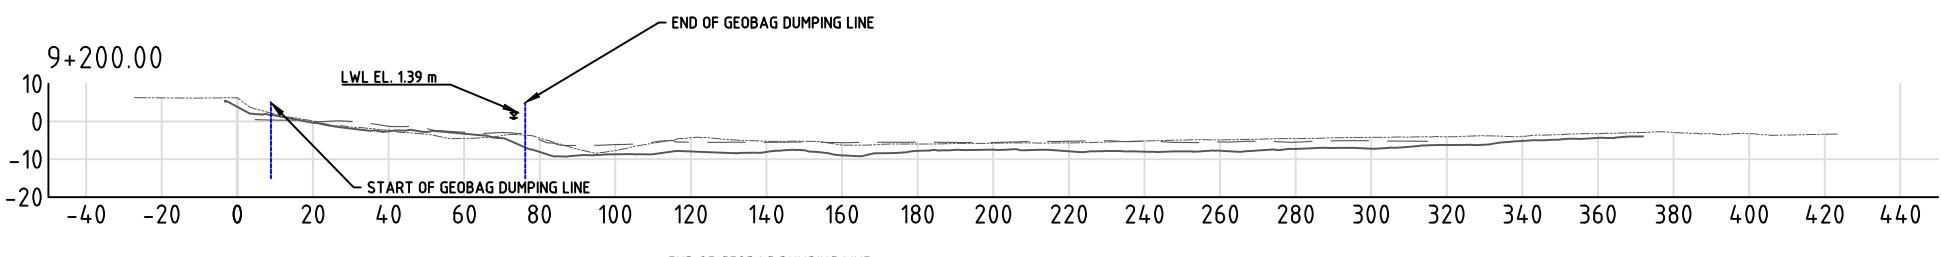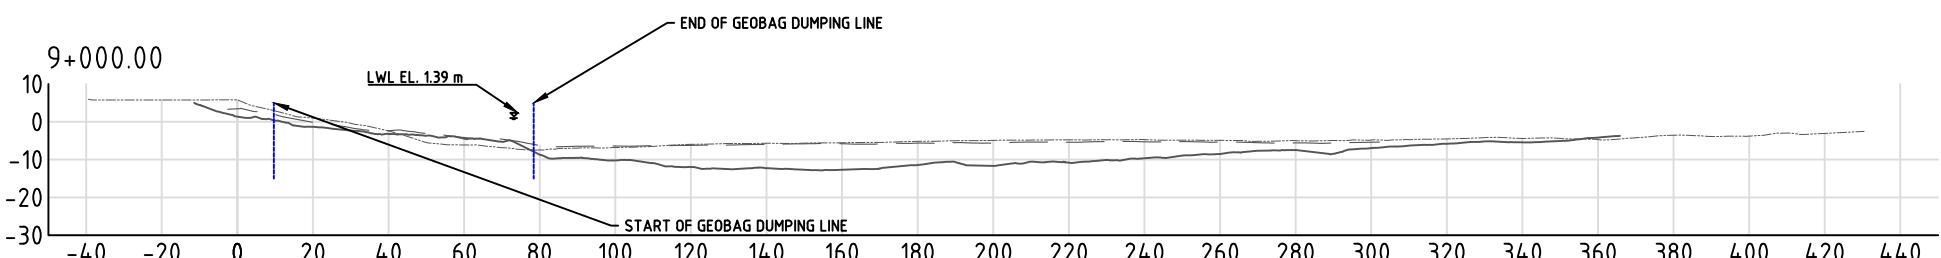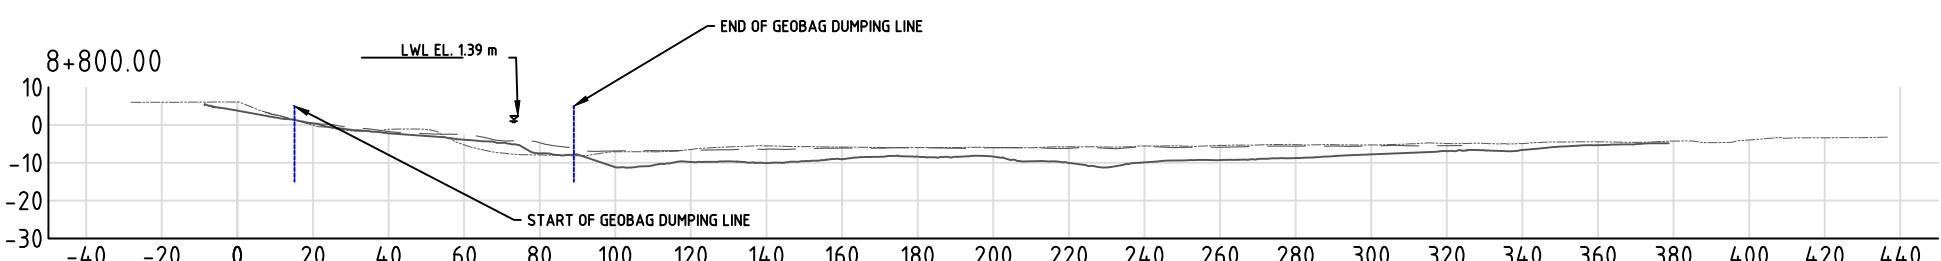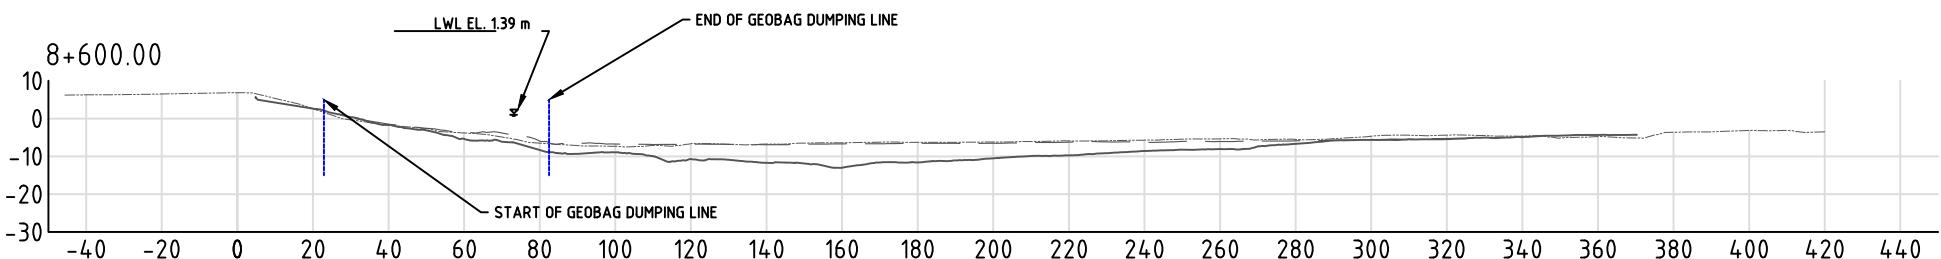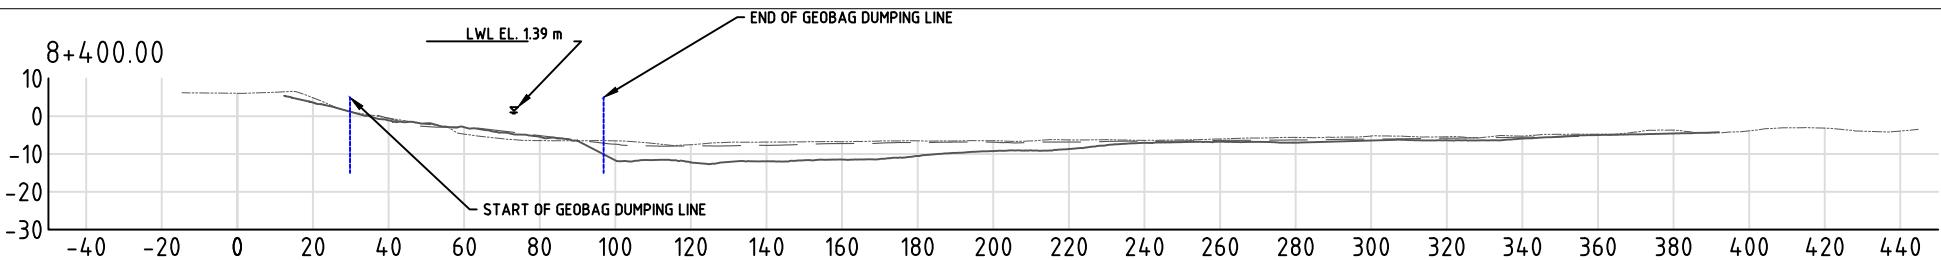

#### LEGENDS:

PRE-CONSTRUCTION SURVEY -----

JUNE MONITORING SURVEY - - - -

AS-BUILT SURVEY \_\_\_\_\_

This drawing is confidential and shall only be used for the purposes of this project.

THE SIGNING OF THIS TITLE BLOCK CONFIRMS THE DESIGN AND DRAFTING  
OF THIS PROJECT HAVE BEEN PREPARED AND CHECKED

SCALES:

CLIENT:

AS SHOWN IN THE DRAWING



CONSULTANT

**nhc**  
northwest hydraulic consultants  
Mott MacDonald

FLOOD AND RIVERBANK EROSION RISK MANAGEMENT INVESTMENT PROGRAM

DRAWING NAME:

SECTION VIEW FROM CH 8+400 TO CH 9+400

0	MYA	26.07.2016	FIRST DRAFT	KO
No.	BY	DATE	DESCRIPTION	APPD

DESIGNED

MYA

CHECKED

GV

DRAWN

MYA

CHECKED

GV

APPROVED

KO

DATE

SHEET NO:

16

BANGLADESH WATER DEVELOPMENT BOARD

STATUS:


AS BUILT\_JULY 2016

DRAWING NO:

FRERMIP-ISPMC-HAR-16

REVISION:

0

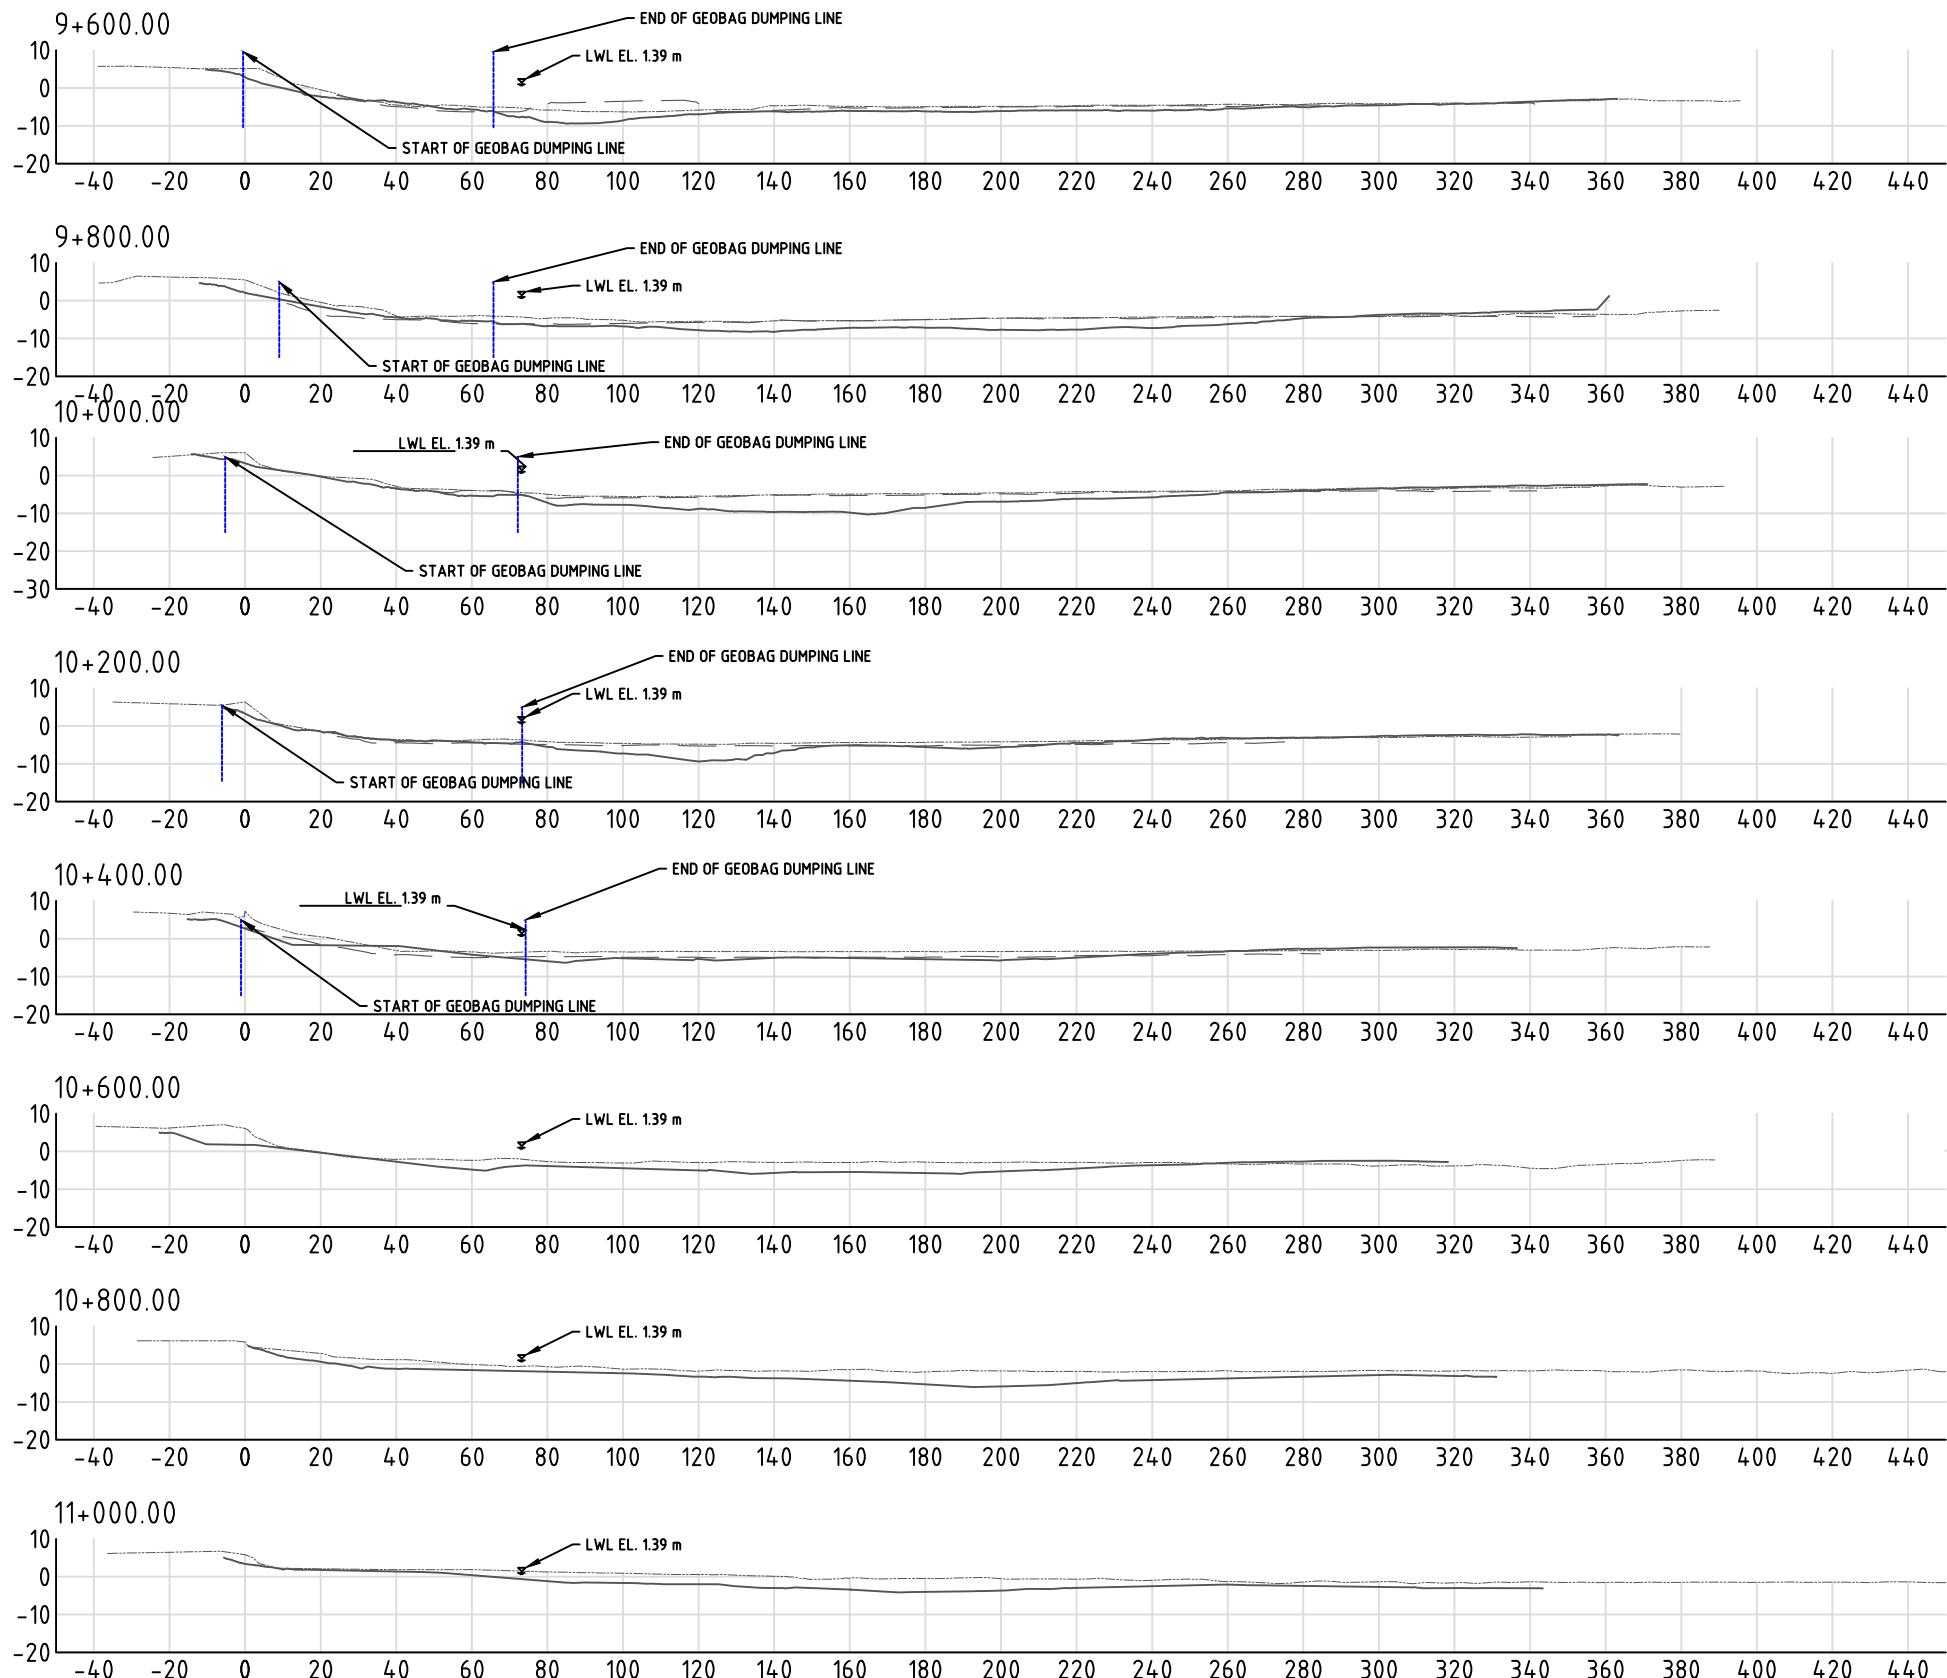

#### LEGENDS:

PRE-CONSTRUCTION SURVEY

JUNE MONITORING SURVEY

AS-BUILT SURVEY

This drawing is confidential and shall only be used for the purposes of this project.

THE SIGNING OF THIS TITLE BLOCK CONFIRMS THE DESIGN AND DRAFTING  
OF THIS PROJECT HAVE BEEN PREPARED AND CHECKED

SCALES:

AS SHOWN IN THE DRAWING

CLIENT:



BANGLADESH WATER DEVELOPMENT BOARD

CONSULTANT



northwest hydraulic consultants



FLOOD AND RIVERBANK EROSION RISK MANAGEMENT INVESTMENT PROGRAM

DRAWING NAME:

SECTION VIEW FROM CH 9+600 TO CH 11+000

STATUS:

AS BUILT\_JULY 2016

DRAWING NO:

FRERMIP-ISPMC-HAR-17

REVISION: 0

0	MYA	26.07.2016	FIRST DRAFT	KO
No.	BY	DATE	DESCRIPTION	APPD

SHEET NO:

17

**Figure A.6 Zaffarganj Interim Construction Completion Drawings**

Joint Venture



# FRERMIP – ZAFARGANJ SITE


## INTERIM CONSTRUCTION RECORD DRAWINGS

JULY, 2016



PROJECT LOCATION  
NTS

NOTES:  
PROJECTION SYSTEM USED FOR PRODUCING THESE  
DRAWINGS IS BANGLADESH TRANSVERSE MERCATOR  
(BTM)

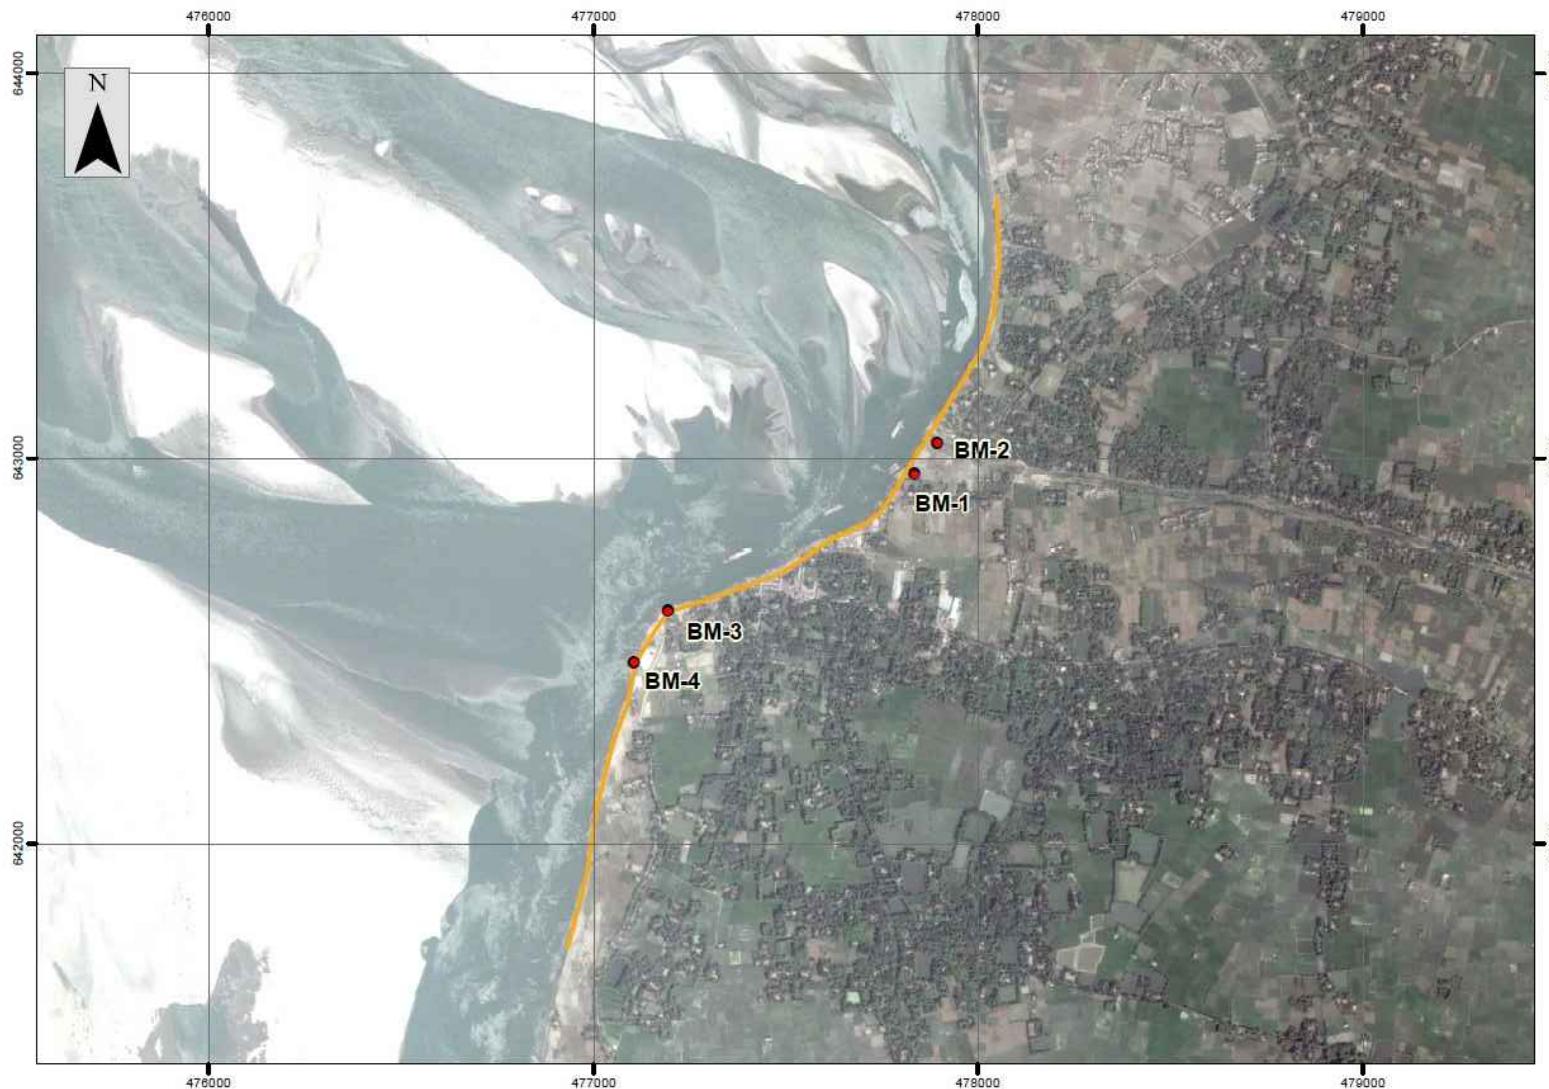

BAG PLACEMENT  
RECORDS  
AS OF JUNE 30,  
2016

SITE PLAN  
NTS

BM CO-ORDINATES		
BM NO	EASTING	NORTHING
1	477836	642958
2	477895	643039
3	477194	642604
4	477105	642470

DRAWING INDEX		
SHEET NUMBER	DESCRIPTION	REVISION
1	SITE & LOCATION MAP,BM POSITIONS	0
2	KEY MAP	0
3	PLAN KM 6+000 – 7+000	0
4	PLAN KM 7+000 – 8+000	0
5	SECTION KM 6+000 – 6+600	0
7	SECTION KM 6+800 – 7+400	0
8	SECTION KM 7+600 – 8+000	0

This drawing is confidential and shall only be used for the purposes of this project.				THE SIGNING OF THIS TITLE BLOCK CONFIRMS THE DESIGN AND DRAFTING OF THIS PROJECT HAVE BEEN PREPARED AND CHECKED				SCALES:	CLIENT:   BANGLADESH WATER DEVELOPMENT BOARD	CONSULTANT:   northwest hydraulic consultants 	FLOOD AND RIVERBANK EROSION RISK MANAGEMENT INVESTMENT PROGRAM				
DESIGNED	MYA	CHECKED	GV	DRAWN	MYA	CHECKED	GV	AS SHOWN IN THE DRAWING			DRAWING NAME:	SITE & LOCATION MAP,BM POSITIONS			
APPROVED	KO	DATE		APPROVED	KO	DATE					STATUS:	AS BUILT_JULY 2016			
0	MYA	28.07.2016	FIRST DRAFT	KO				SHEET NO.: 001			DRAWING NO:	FRERMIP-ISPMC-ZAF-01			
No.	BY	DATE	DESCRIPTION	APPD					REVISION:	0					



SCALE 1:10000

PACKAGE W-08

SHEET 0061

SHEET 1

## ADCP MONITORING SURVEY LINE

ADCP MONITORING  
SURVEY LINE

RING

1

1

١٣

WATER


NOTES

**1.DIVING CROSS SECTION (DS#) DESCRIBED IN APPENDIX 1 OF INTERIM CONSTRUCTION COMPLETION REPORT**

This drawing is confidential and shall only be used for the purposes of this project.				THE SIGNING OF THIS TITLE BLOCK CONFIRMS THE DESIGN AND DRAFTING OF THIS PROJECT HAVE BEEN PREPARED AND CHECKED				SCALES:  AS SHOWN IN THE DRAWING	CLIENT:  	CONSULTANT  <b>nhc</b> northwest hydraulic consultants 	FLOOD AND RIVERBANK EROSION RISK MANAGEMENT INVESTMENT PROGRAM			
DESIGNED		MYA	CHECKED	GV	DRAWING NAME:									
DRAWN		MYA	CHECKED	GV	KEY MAP									
APPROVED		KO	DATE											
0	MYA	28.07.2016	FIRST DRAFT	KO	SHEET NO:	002	BANGLADESH WATER DEVELOPMENT BOARD	STATUS:	AS BUILT_JULY 2016	DRAWING NO:	FRERMIP-ISPMC-ZAF-01	REVISION:	0	
No.	BY	DATE	DESCRIPTION	APPD										



SCALE 1:3500

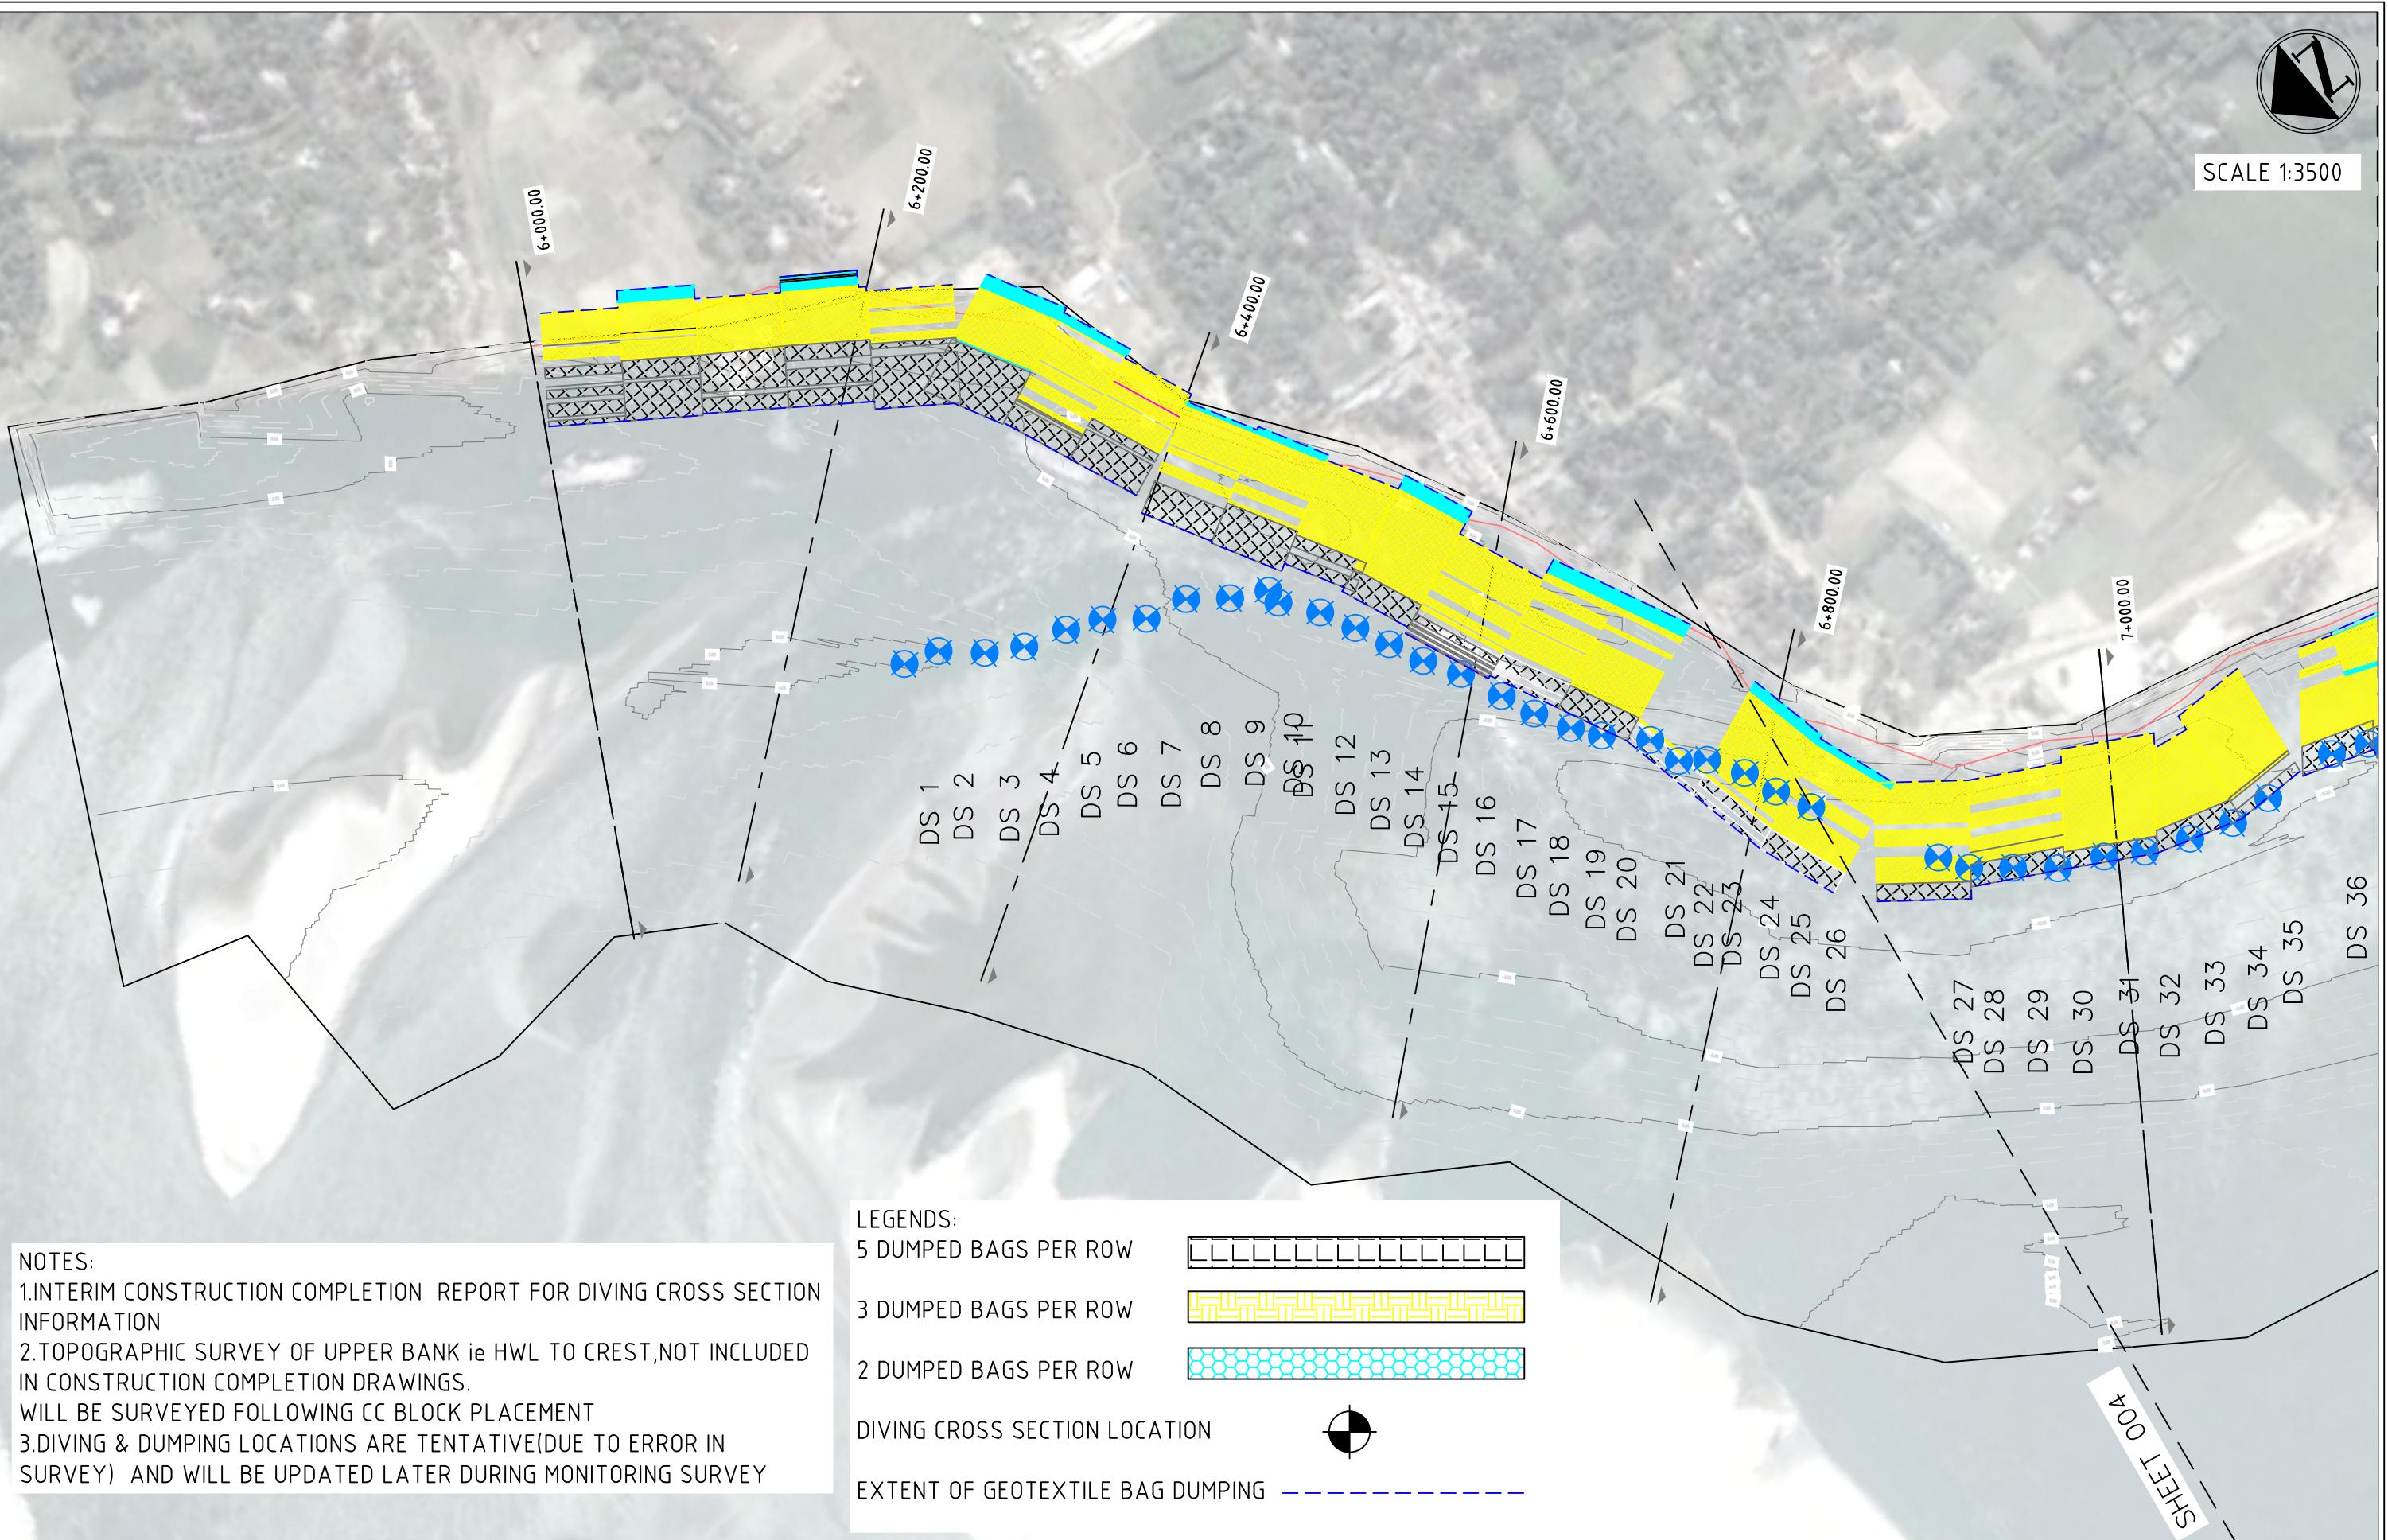

This drawing is confidential and shall only be used for the purposes of this project.

THE SIGNING OF THIS TITLE BLOCK CONFIRMS THE DESIGN AND DRAFTING OF THIS PROJECT HAVE BEEN PREPARED AND CHECKED

SCALES:

AS SHOWN IN THE DRAWING

CLIENT:



BANGLADESH WATER DEVELOPMENT BOARD

CONSULTANT



FLOOD AND RIVERBANK EROSION RISK MANAGEMENT INVESTMENT PROGRAM

DRAWING NAME:

PLAN KM 6+000 TO KM 7+000

DRAWING NO:

FRERMIP-ISPMC-ZAF-01

REVISION: 0

DESIGNED	MYA	CHECKED	GV
DRAWN	MYA	CHECKED	GV
APPROVED	KO	DATE	
0	MYA	28.07.2016	FIRST DRAFT
No.	BY	DATE	DESCRIPTION
			APPD

SHEET NO.: 003



SCALE 1:3500



## NOTES:

1. INTERIM CONSTRUCTION COMPLETION REPORT FOR DIVING CROSS SECTION INFORMATION
2. TOPOGRAPHIC SURVEY OF UPPER BANK ie HWL TO CREST, NOT INCLUDED IN CONSTRUCTION COMPLETION DRAWINGS.
- WILL BE SURVEYED FOLLOWING CC BLOCK PLACEMENT
3. DIVING & DUMPING LOCATIONS ARE TENTATIVE(DUE TO ERROR IN SURVEY) AND WILL BE UPDATED LATER DURING MONITORING SURVEY

## LEGENDS:


5 DUMPED BAGS PER ROW



3 DUMPED BAGS PER ROW



2 DUMPED BAGS PER ROW

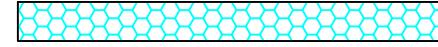

DIVING CROSS SECTION LOCATION



EXTENT OF GEOTEXTILE BAG DUMPING

This drawing is confidential and shall only be used for the purposes of this project.

THE SIGNING OF THIS TITLE BLOCK CONFIRMS THE DESIGN AND DRAFTING OF THIS PROJECT HAVE BEEN PREPARED AND CHECKED

SCALE:

AS SHOWN IN THE DRAWING

CLIENT:



BANGLADESH WATER DEVELOPMENT BOARD

CONSULTANT:



FLOOD AND RIVERBANK EROSION RISK MANAGEMENT INVESTMENT PROGRAM

DRAWING NAME:

PLAN KM 7+000 TO KM 8+000

STATUS: AS BUILT\_JULY 2016

DRAWING NO:


FRERMIP-ISPMC-ZAF-01

REVISION: 0

0	MYA	28.07.2016	FIRST DRAFT	KO
No.	BY	DATE	DESCRIPTION	APPD

SHEET NO.:

004

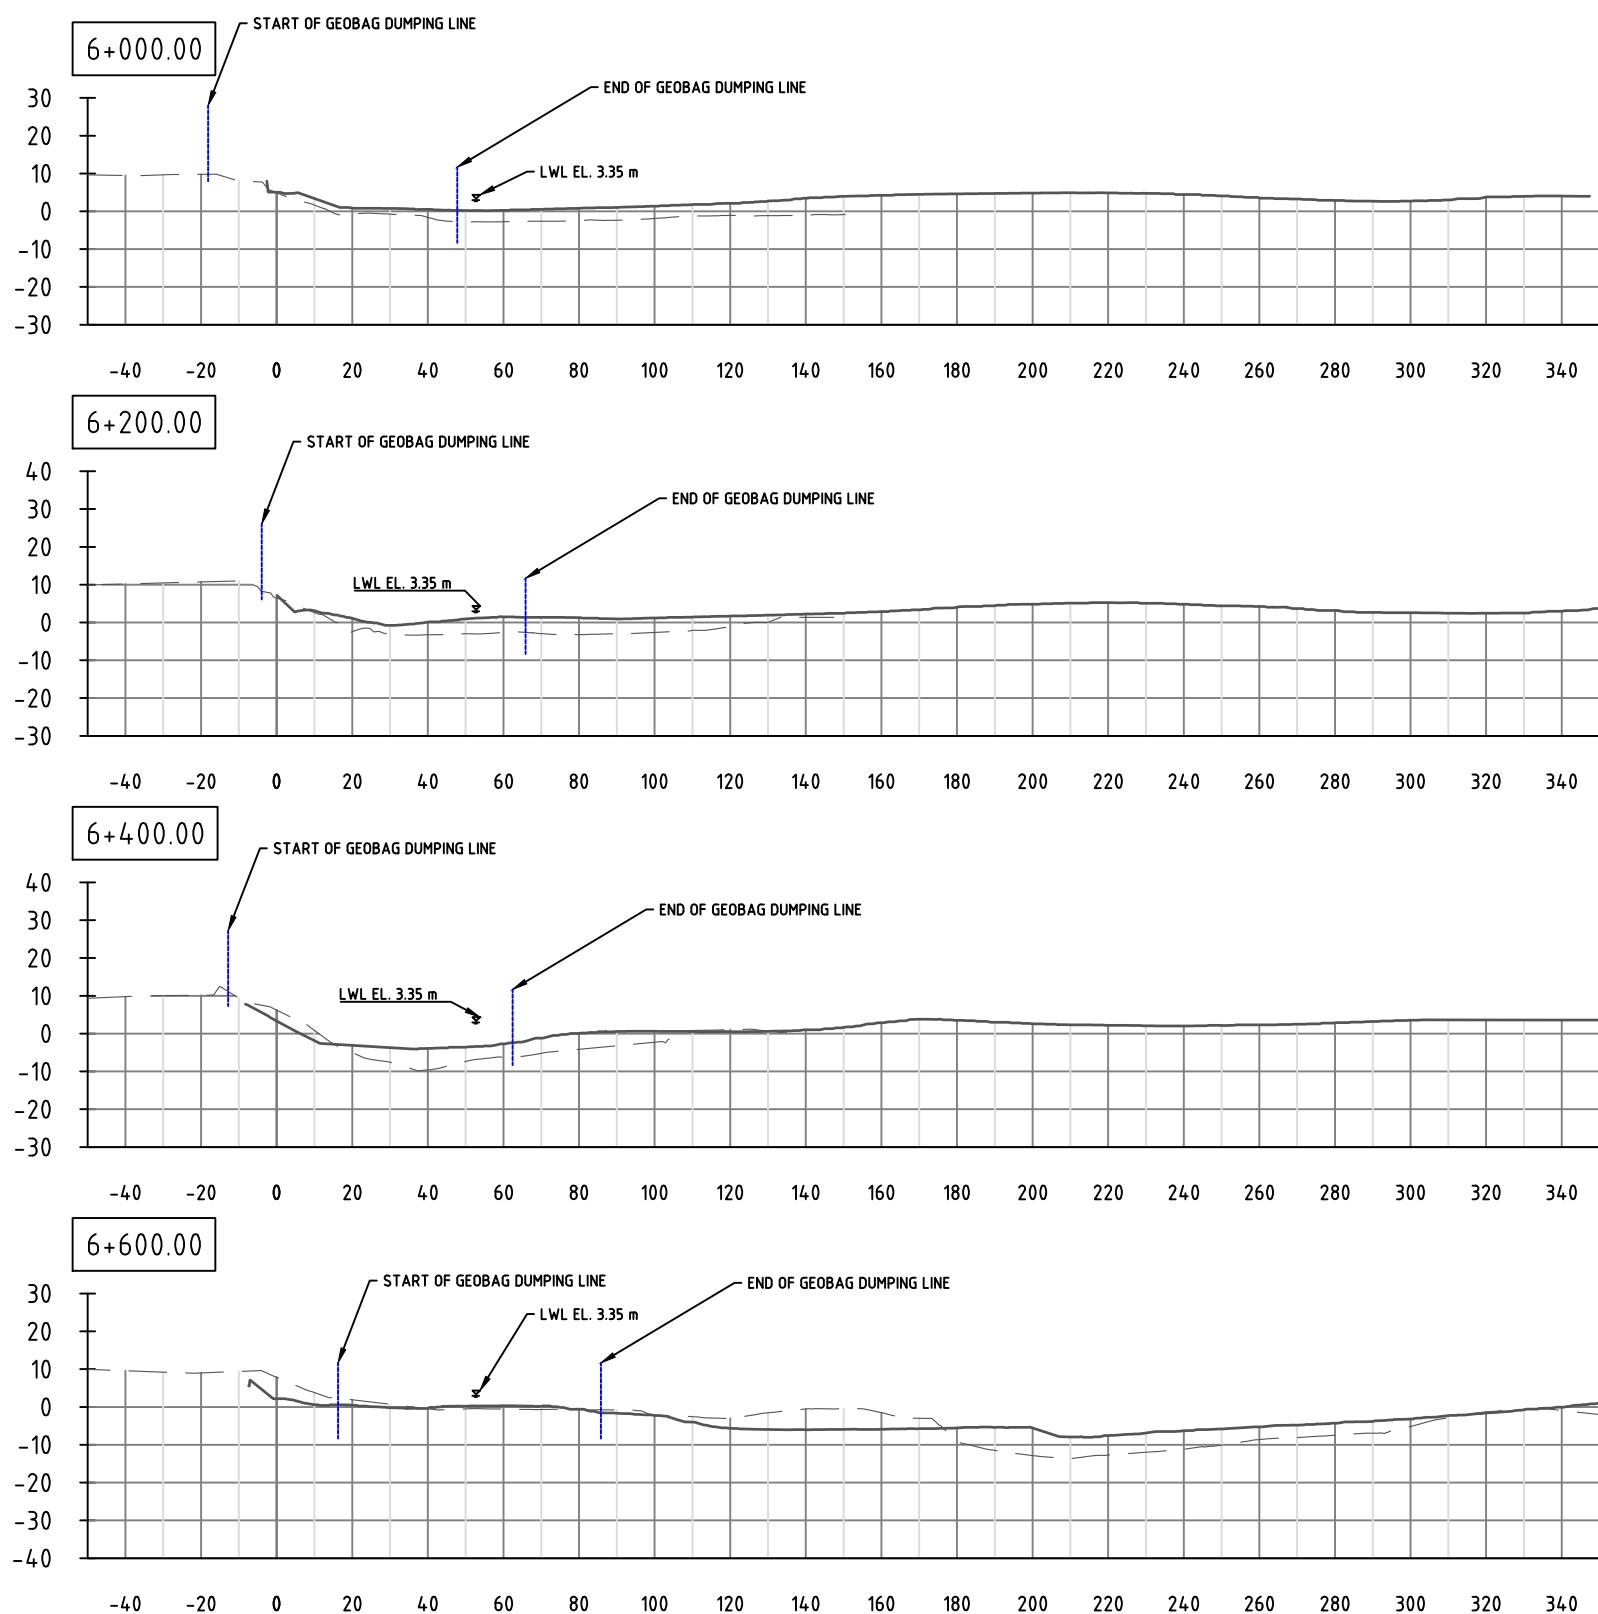

LEGENDS:

PRE-CONSTRUCTION SURVEY -----

AS-BUILT SURVEY \_\_\_\_\_

This drawing is confidential and shall only be used for the purposes of this project.

THE SIGNING OF THIS TITLE BLOCK CONFIRMS THE DESIGN AND DRAFTING  
OF THIS PROJECT HAVE BEEN PREPARED AND CHECKED

SCALES:

CLIENT:

AS SHOWN IN THE DRAWING



BANGLADESH WATER DEVELOPMENT BOARD

CONSULTANT

**nhc**  
northwest hydraulic consultants  
Mott MacDonald

FLOOD AND RIVERBANK EROSION RISK MANAGEMENT INVESTMENT PROGRAM

DRAWING NAME:

SECTION KM 6+000 TO KM 6+600

STATUS:

AS BUILT

JULY 2016

DRAWING NO:

FRERMIP-ISPMC-ZAF-01

REVISION:

0

DESIGNED	MYA	CHECKED	GV
----------	-----	---------	----

DRAWN	MYA	CHECKED	GV
-------	-----	---------	----





APPROVED	KO	DATE	
----------	----	------	--

0	MYA	28.07.2016	FIRST DRAFT	KO
---	-----	------------	-------------	----

No.	BY	DATE	DESCRIPTION	APPD
-----	----	------	-------------	------

SHEET NO:

005

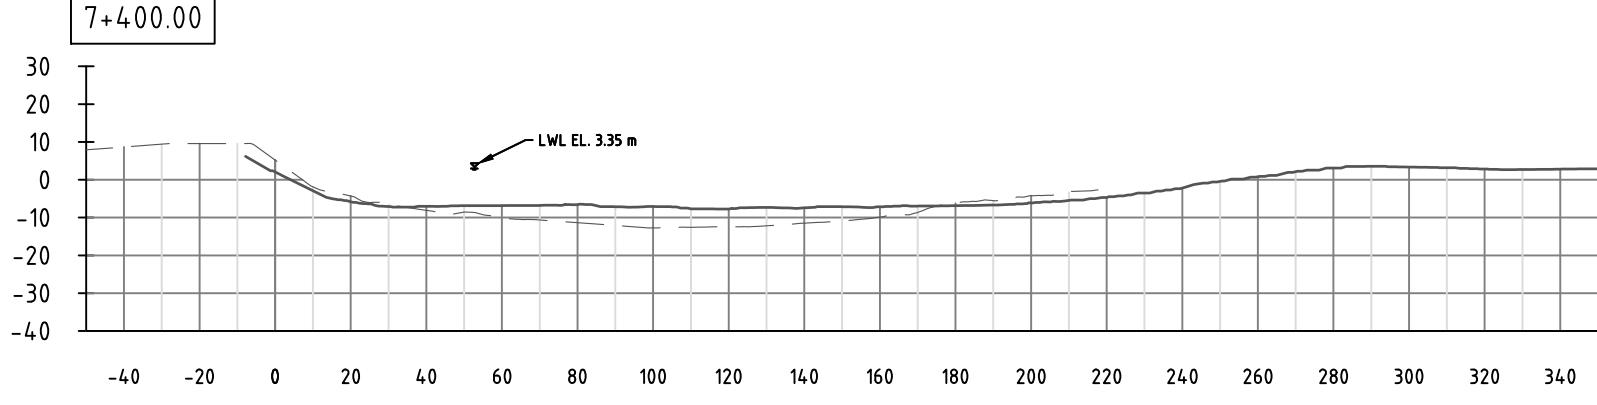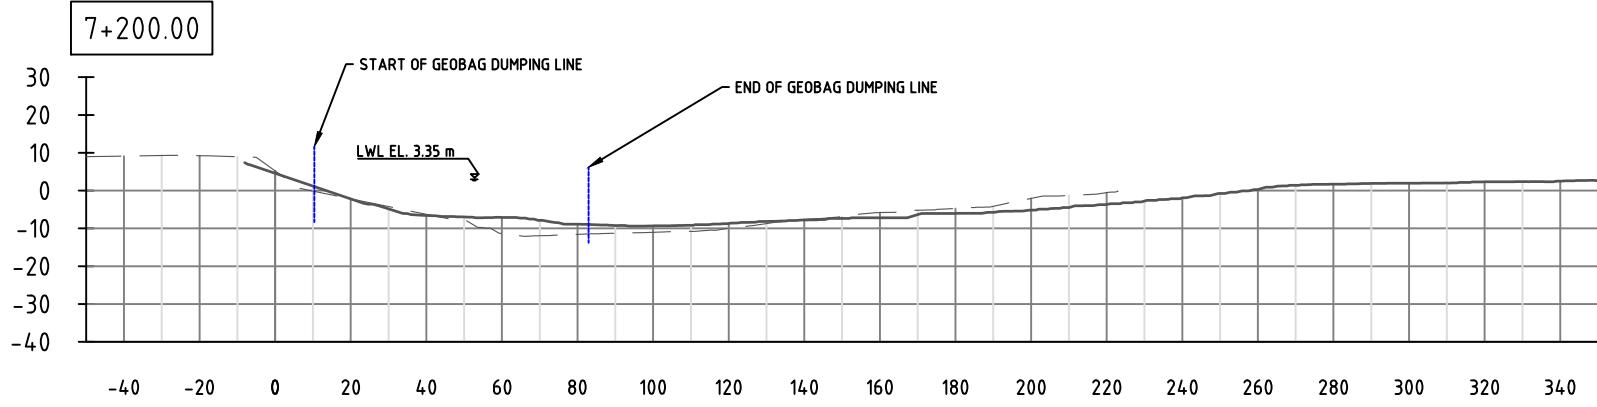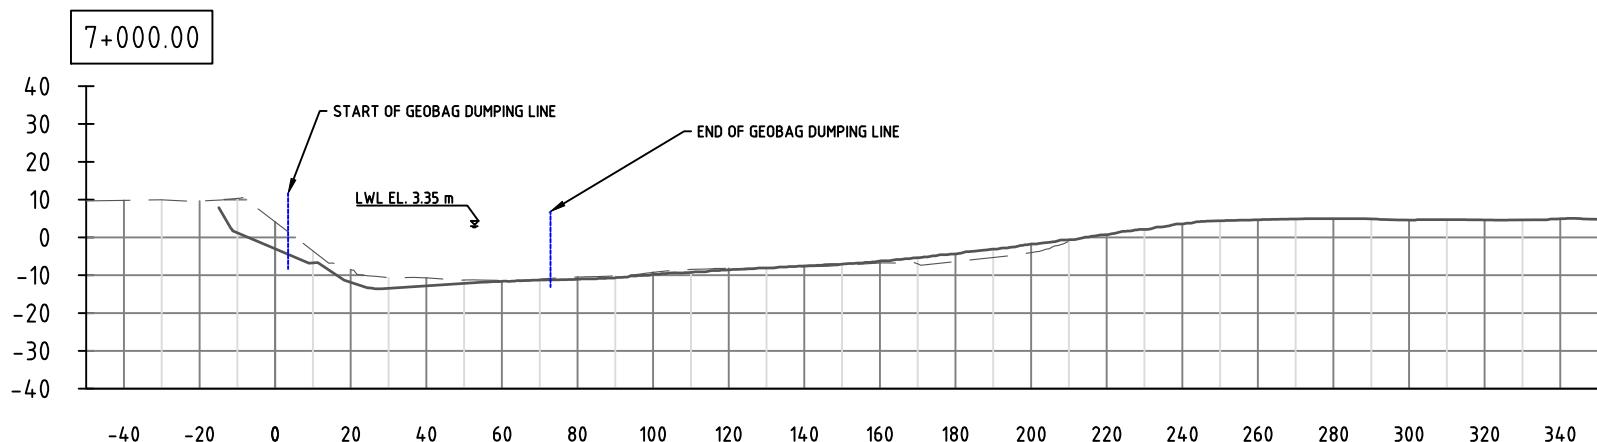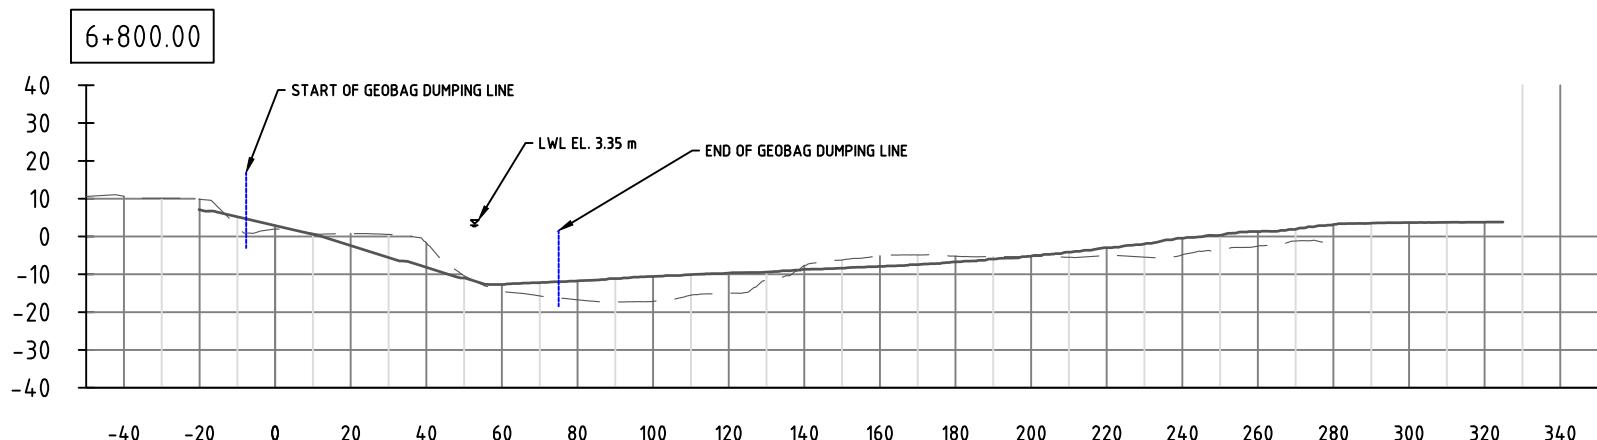

LEGENDS:

PRE-CONSTRUCTION SURVEY -----

AS-BUILT SURVEY \_\_\_\_\_

This drawing is confidential and shall only be used for the purposes of this project.

THE SIGNING OF THIS TITLE BLOCK CONFIRMS THE DESIGN AND DRAFTING  
OF THIS PROJECT HAVE BEEN PREPARED AND CHECKED

SCALES:

AS SHOWN IN THE DRAWING

CLIENT:



BANGLADESH WATER DEVELOPMENT BOARD

CONSULTANT



northwest hydraulic consultants



FLOOD AND RIVERBANK EROSION RISK MANAGEMENT INVESTMENT PROGRAM

DRAWING NAME:

SECTION KM 6+800 TO KM 7+400

STATUS: AS BUILT\_JULY 2016




DRAWING NO: FRERMIP-ISPMC-ZAF-01

REVISION: 0

0	MYA	28.07.2016	FIRST DRAFT	KO
No.	BY	DATE	DESCRIPTION	APPD

SHEET NO:

006

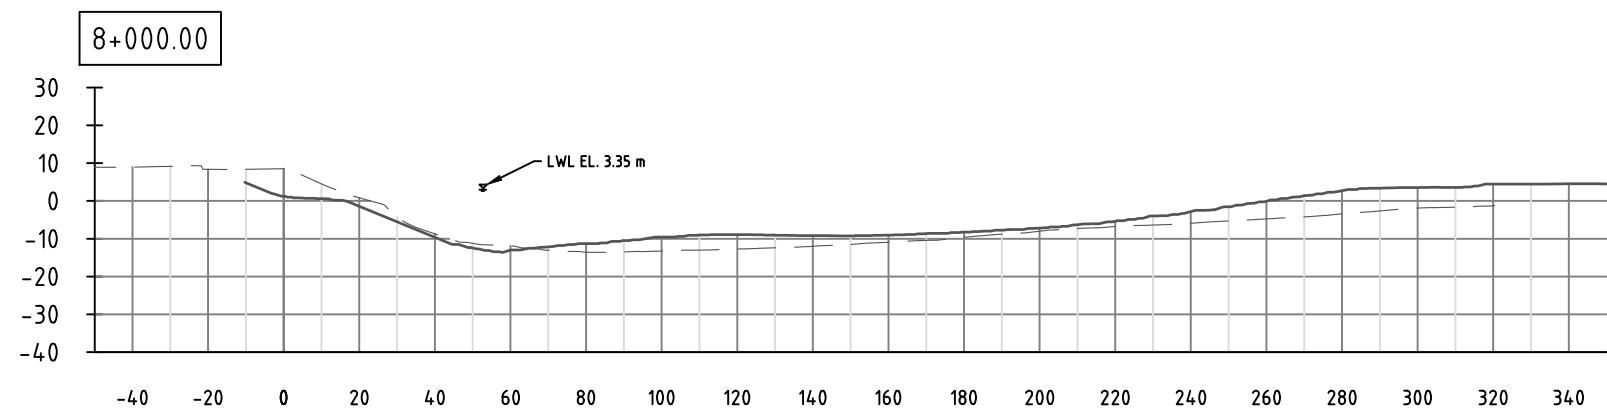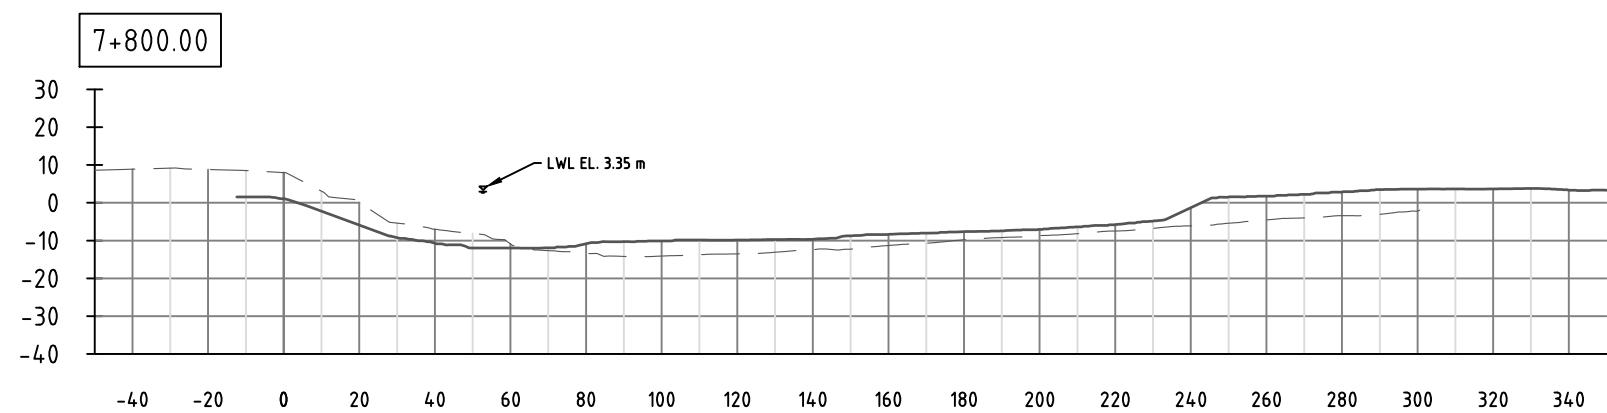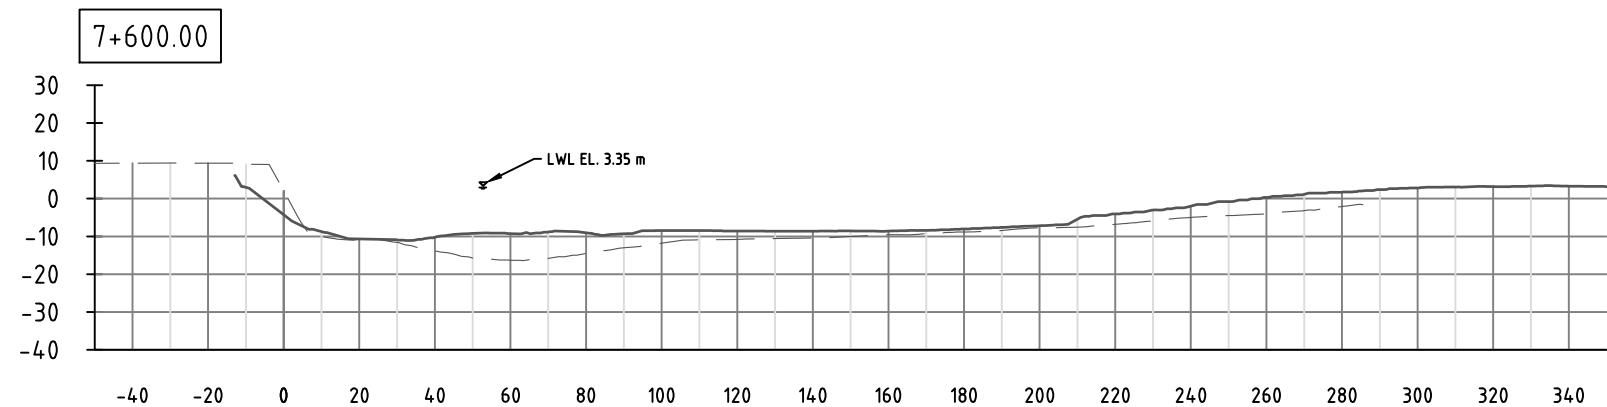

LEGENDS:

PRE-CONSTRUCTION SURVEY -----

AS-BUILT SURVEY \_\_\_\_\_

This drawing is confidential and shall only be used for the purposes of this project.

THE SIGNING OF THIS TITLE BLOCK CONFIRMS THE DESIGN AND DRAFTING  
OF THIS PROJECT HAVE BEEN PREPARED AND CHECKED

SCALES:

AS SHOWN IN THE DRAWING

CLIENT:



BANGLADESH WATER DEVELOPMENT BOARD

CONSULTANT

**nhc**  
northwest hydraulic consultants

Mott MacDonald

FLOOD AND RIVERBANK EROSION RISK MANAGEMENT INVESTMENT PROGRAM

DRAWING NAME:

SECTION KM 7+600 TO KM 8+000

STATUS: AS BUILT\_JULY 2016

DRAWING NO:

FRERMIP-ISPMC-ZAF-01

REVISION: 0

0	MYA	28.07.2016	FIRST DRAFT	KO
No.	BY	DATE	DESCRIPTION	APPD


SHEET NO: 007

**Figure A.5 Chauhali Interim Construction Completion Drawings**

# FRERMIP – CHAUHALI SITE

## INTERIM CONSTRUCTION RECORD DRAWINGS

### JULY, 2016

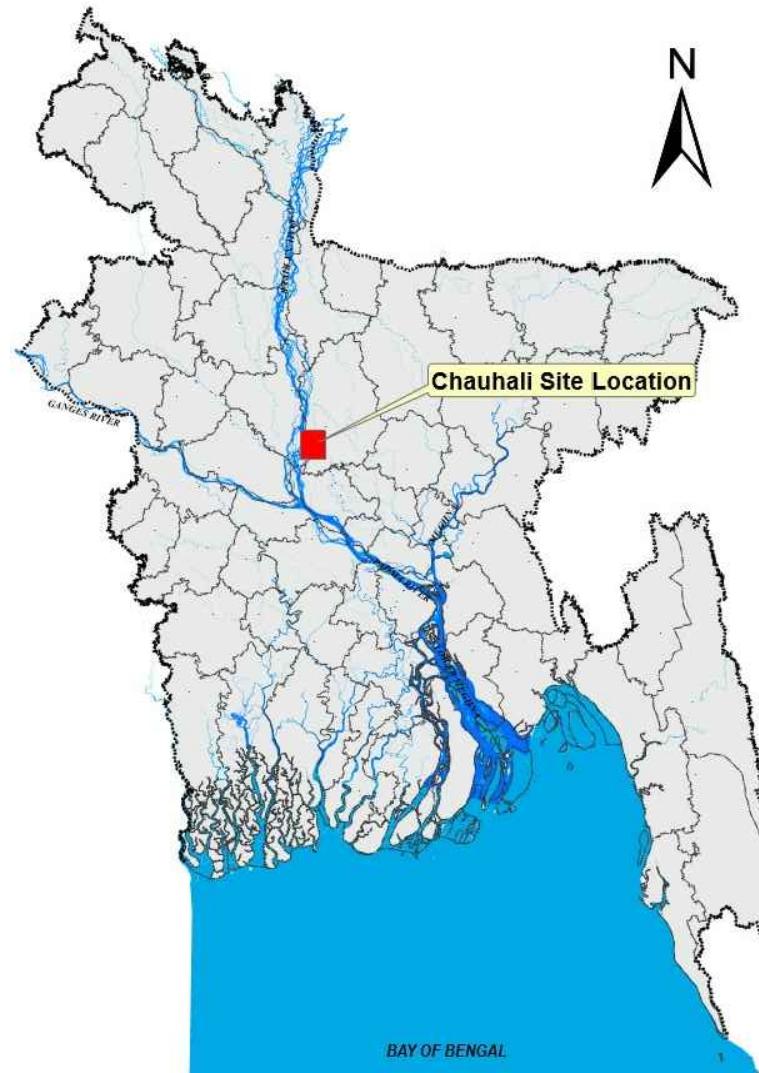

PROJECT LOCATION  
NTS

NOTES:

PROJECTION SYSTEM USED FOR PRODUCING THESE DRAWINGS IS BANGLADESH TRANSVERSE MERCATOR (BTM)

BM CO-ORDINATES		
BM NO	EASTING	NORTHING
1	478714	666549
2	479398	667409
3	480027	668264
4	480588	669087
5	480918	669998
6	481064	670930



BAG PLACEMENT RECORDS  
AS OF JUNE 30, 2016


SITE PLAN  
NTS

DRAWING INDEX			DRAWING INDEX		
SHEET NUMBER	DESCRIPTION	REVISION	SHEET NUMBER	DESCRIPTION	REVISION
1	SITE & LOCATION MAP,BM POSITIONS	0	10	SECTION KM 2+600 TO KM 1+600	0
2	KEY MAP	0	11	SECTION KM 1+400 TO KM 0+400	0
3	PLAN VIEW FROM KM 6+200 TO 4+200	0	12	SECTION KM 0+200 TO -0+560.19	0
4	PLAN VIEW FROM KM 4+600 TO 2+800	0			
5	PLAN VIEW FROM KM 2+800 TO 1+000	0			
6	PLAN VIEW FROM KM 1+000 TO -0+560.19	0			
7	SECTION VIEW FROM KM 6+200 TO KM 5+200	0			
8	SECTION VIEW FROM KM 5+000 TO KM 4+000	0			
9	SECTION VIEW FROM KM 3+800 TO KM 2+800	0			

This drawing is confidential and shall only be used for the purposes of this project.				THE SIGNING OF THIS TITLE BLOCK CONFIRMS THE DESIGN AND DRAFTING OF THIS PROJECT HAVE BEEN PREPARED AND CHECKED				SCALES:	CLIENT:   BANGLADESH WATER DEVELOPMENT BOARD	CONSULTANT:   northwest hydraulic consultants 	FLOOD AND RIVERBANK EROSION RISK MANAGEMENT INVESTMENT PROGRAM		
DESIGNED	MYA	CHECKED	GV	DRAWN	MYA	CHECKED	GV	DRAWING NAME:					
DRAWN	MYA	CHECKED	GV	APPROVED	KO	DATE		SITE & LOCATION MAP,BM POSITIONS					
APPROVED	KO	DATE		SHEET NO:	001		STATUS:	AS BUILT_JULY 2016					
0	MYA	28.07.2016	FIRST DRAFT	KO			DRAWING NO:	FRERMIP-ISPMC-CHA-01		REVISION:			
No.	BY	DATE	DESCRIPTION	APPD						0			



SCALE 1:22500

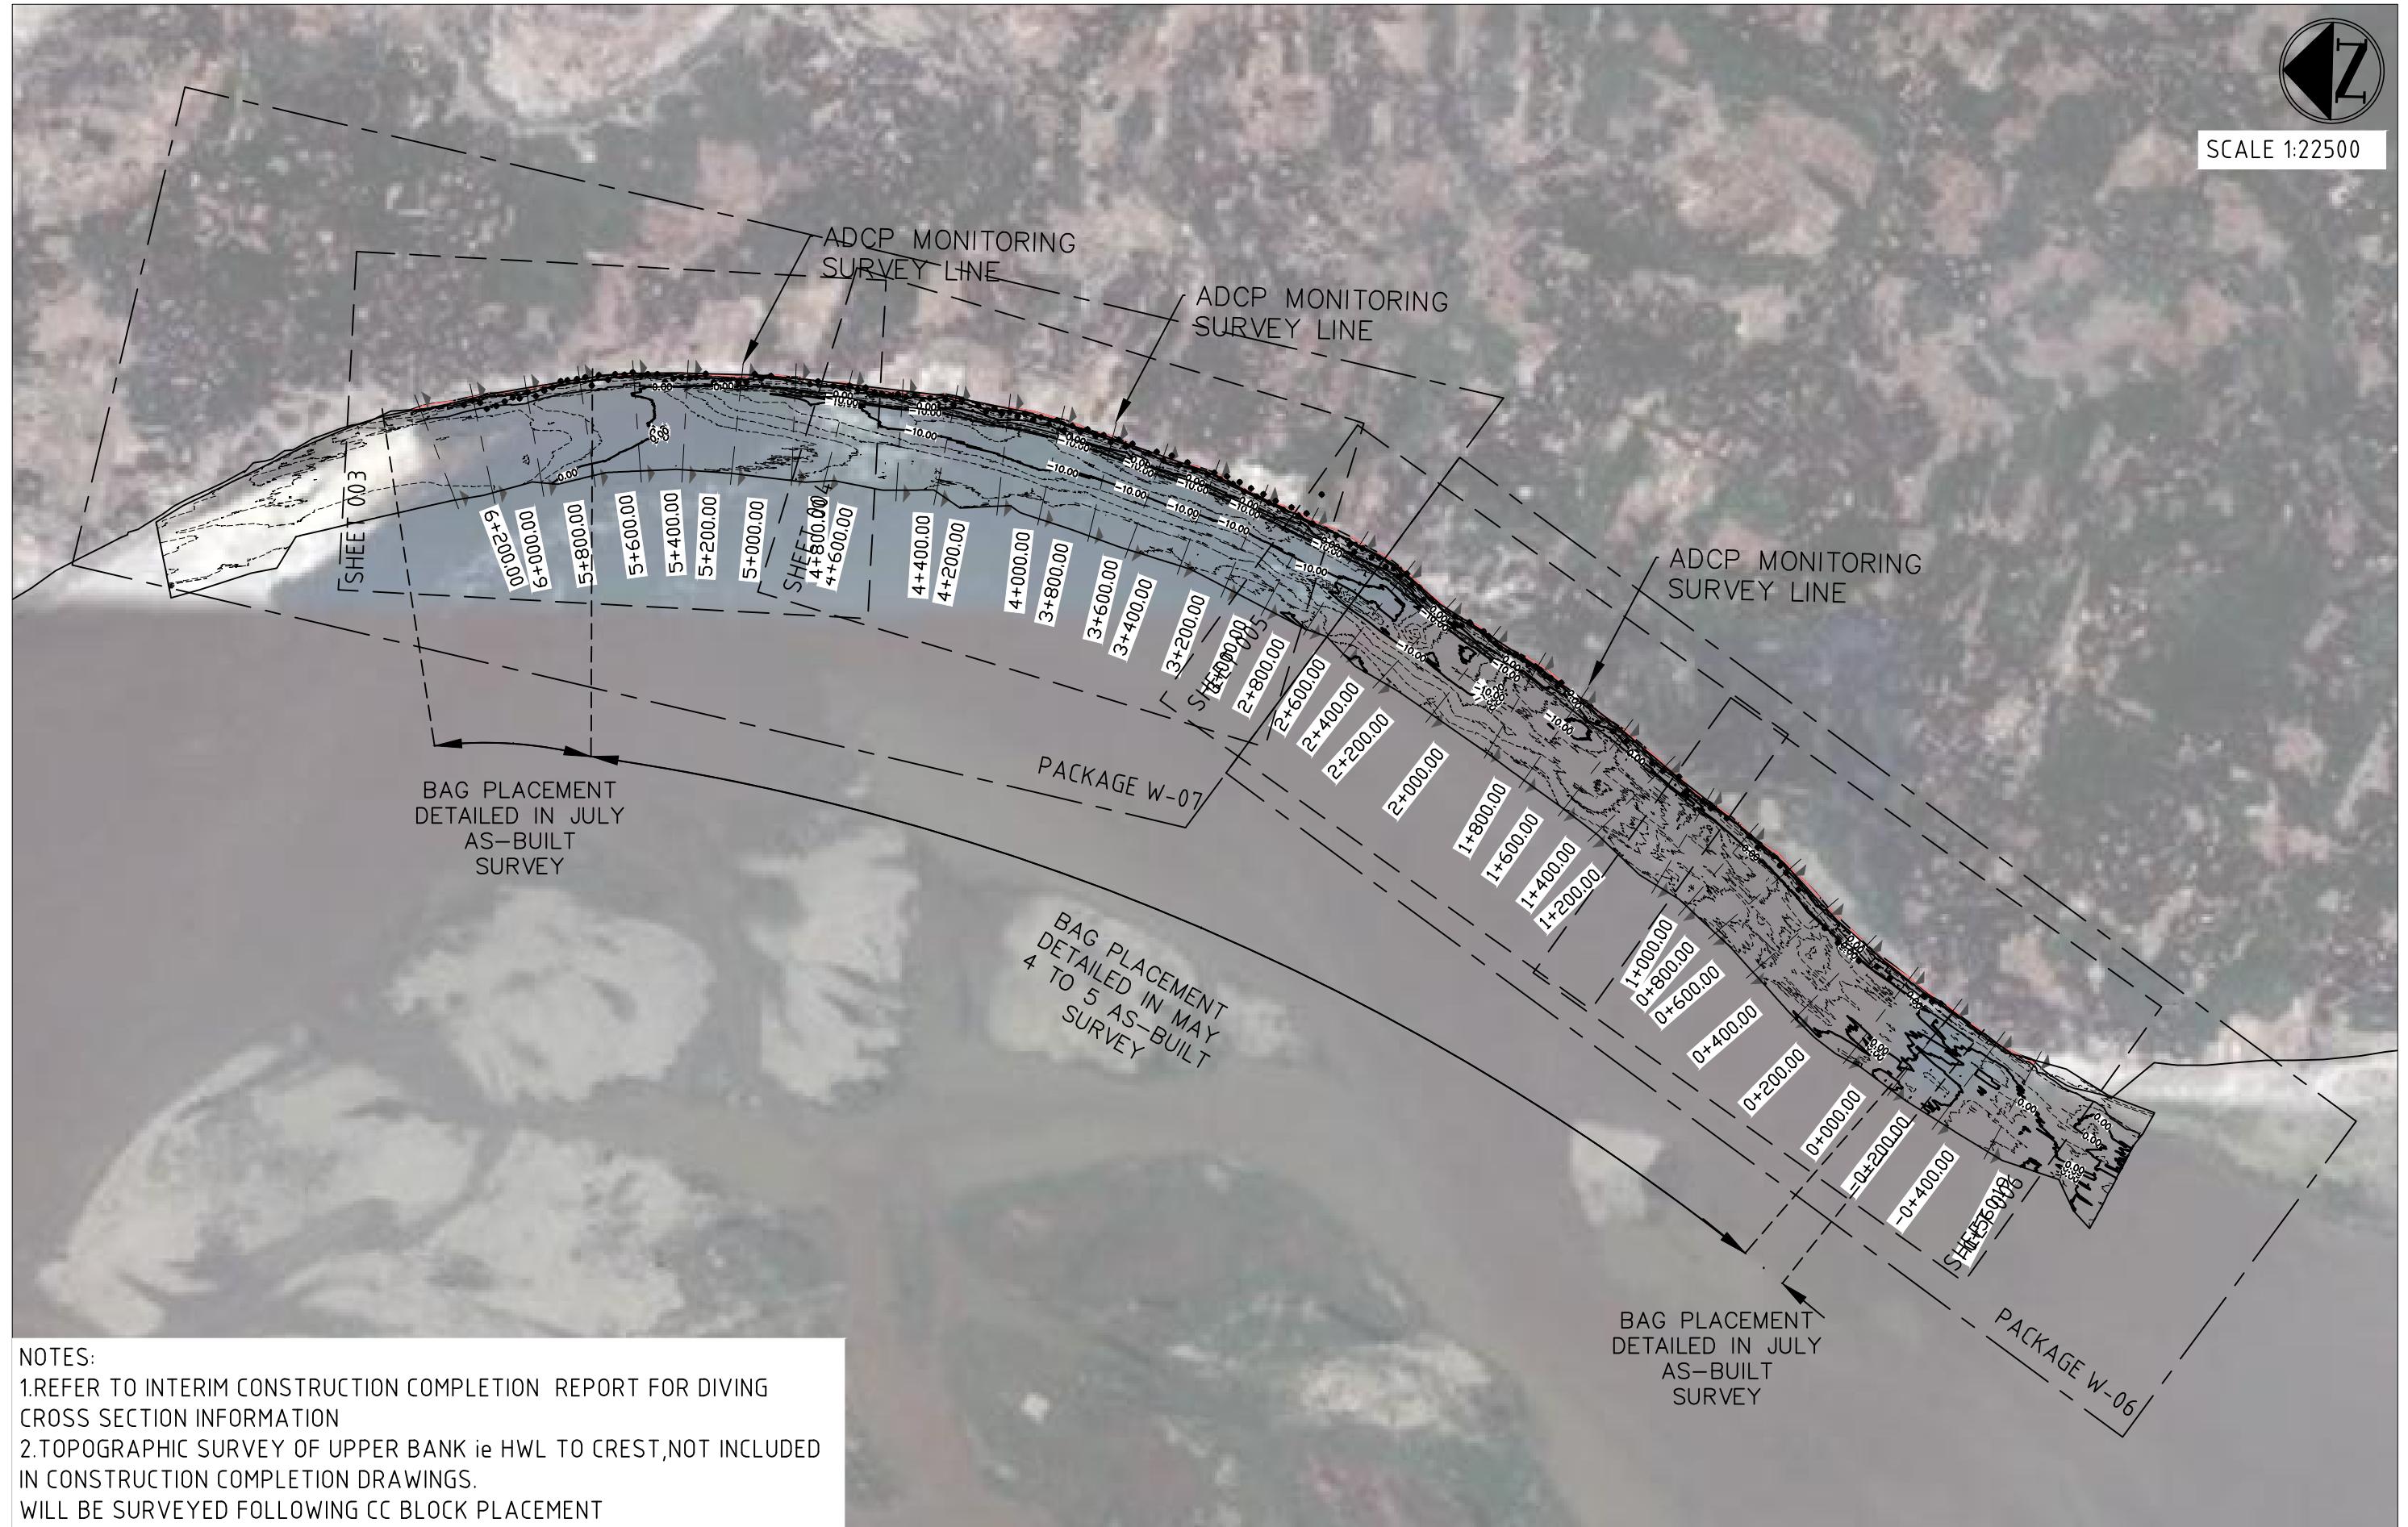

This drawing is confidential and shall only be used for the purposes of this project.

THE SIGNING OF THIS TITLE BLOCK CONFIRMS THE DESIGN AND DRAFTING OF THIS PROJECT HAVE BEEN PREPARED AND CHECKED

SCALE:

AS SHOWN IN THE DRAWING

CLIENT:



BANGLADESH WATER DEVELOPMENT BOARD

CONSULTANT

**nhc**  
 northwest hydraulic consultants  
*Mott MacDonald*

FLOOD AND RIVERBANK EROSION RISK MANAGEMENT INVESTMENT PROGRAM

DRAWING NAME:

KEY MAP

0	MYA	28.07.2016	FIRST DRAFT	KO
No.	BY	DATE	DESCRIPTION	APPD

DESIGNED

MYA

CHECKED

GV

DRAWN

MYA


CHECKED

GV

APPROVED

KO

DATE

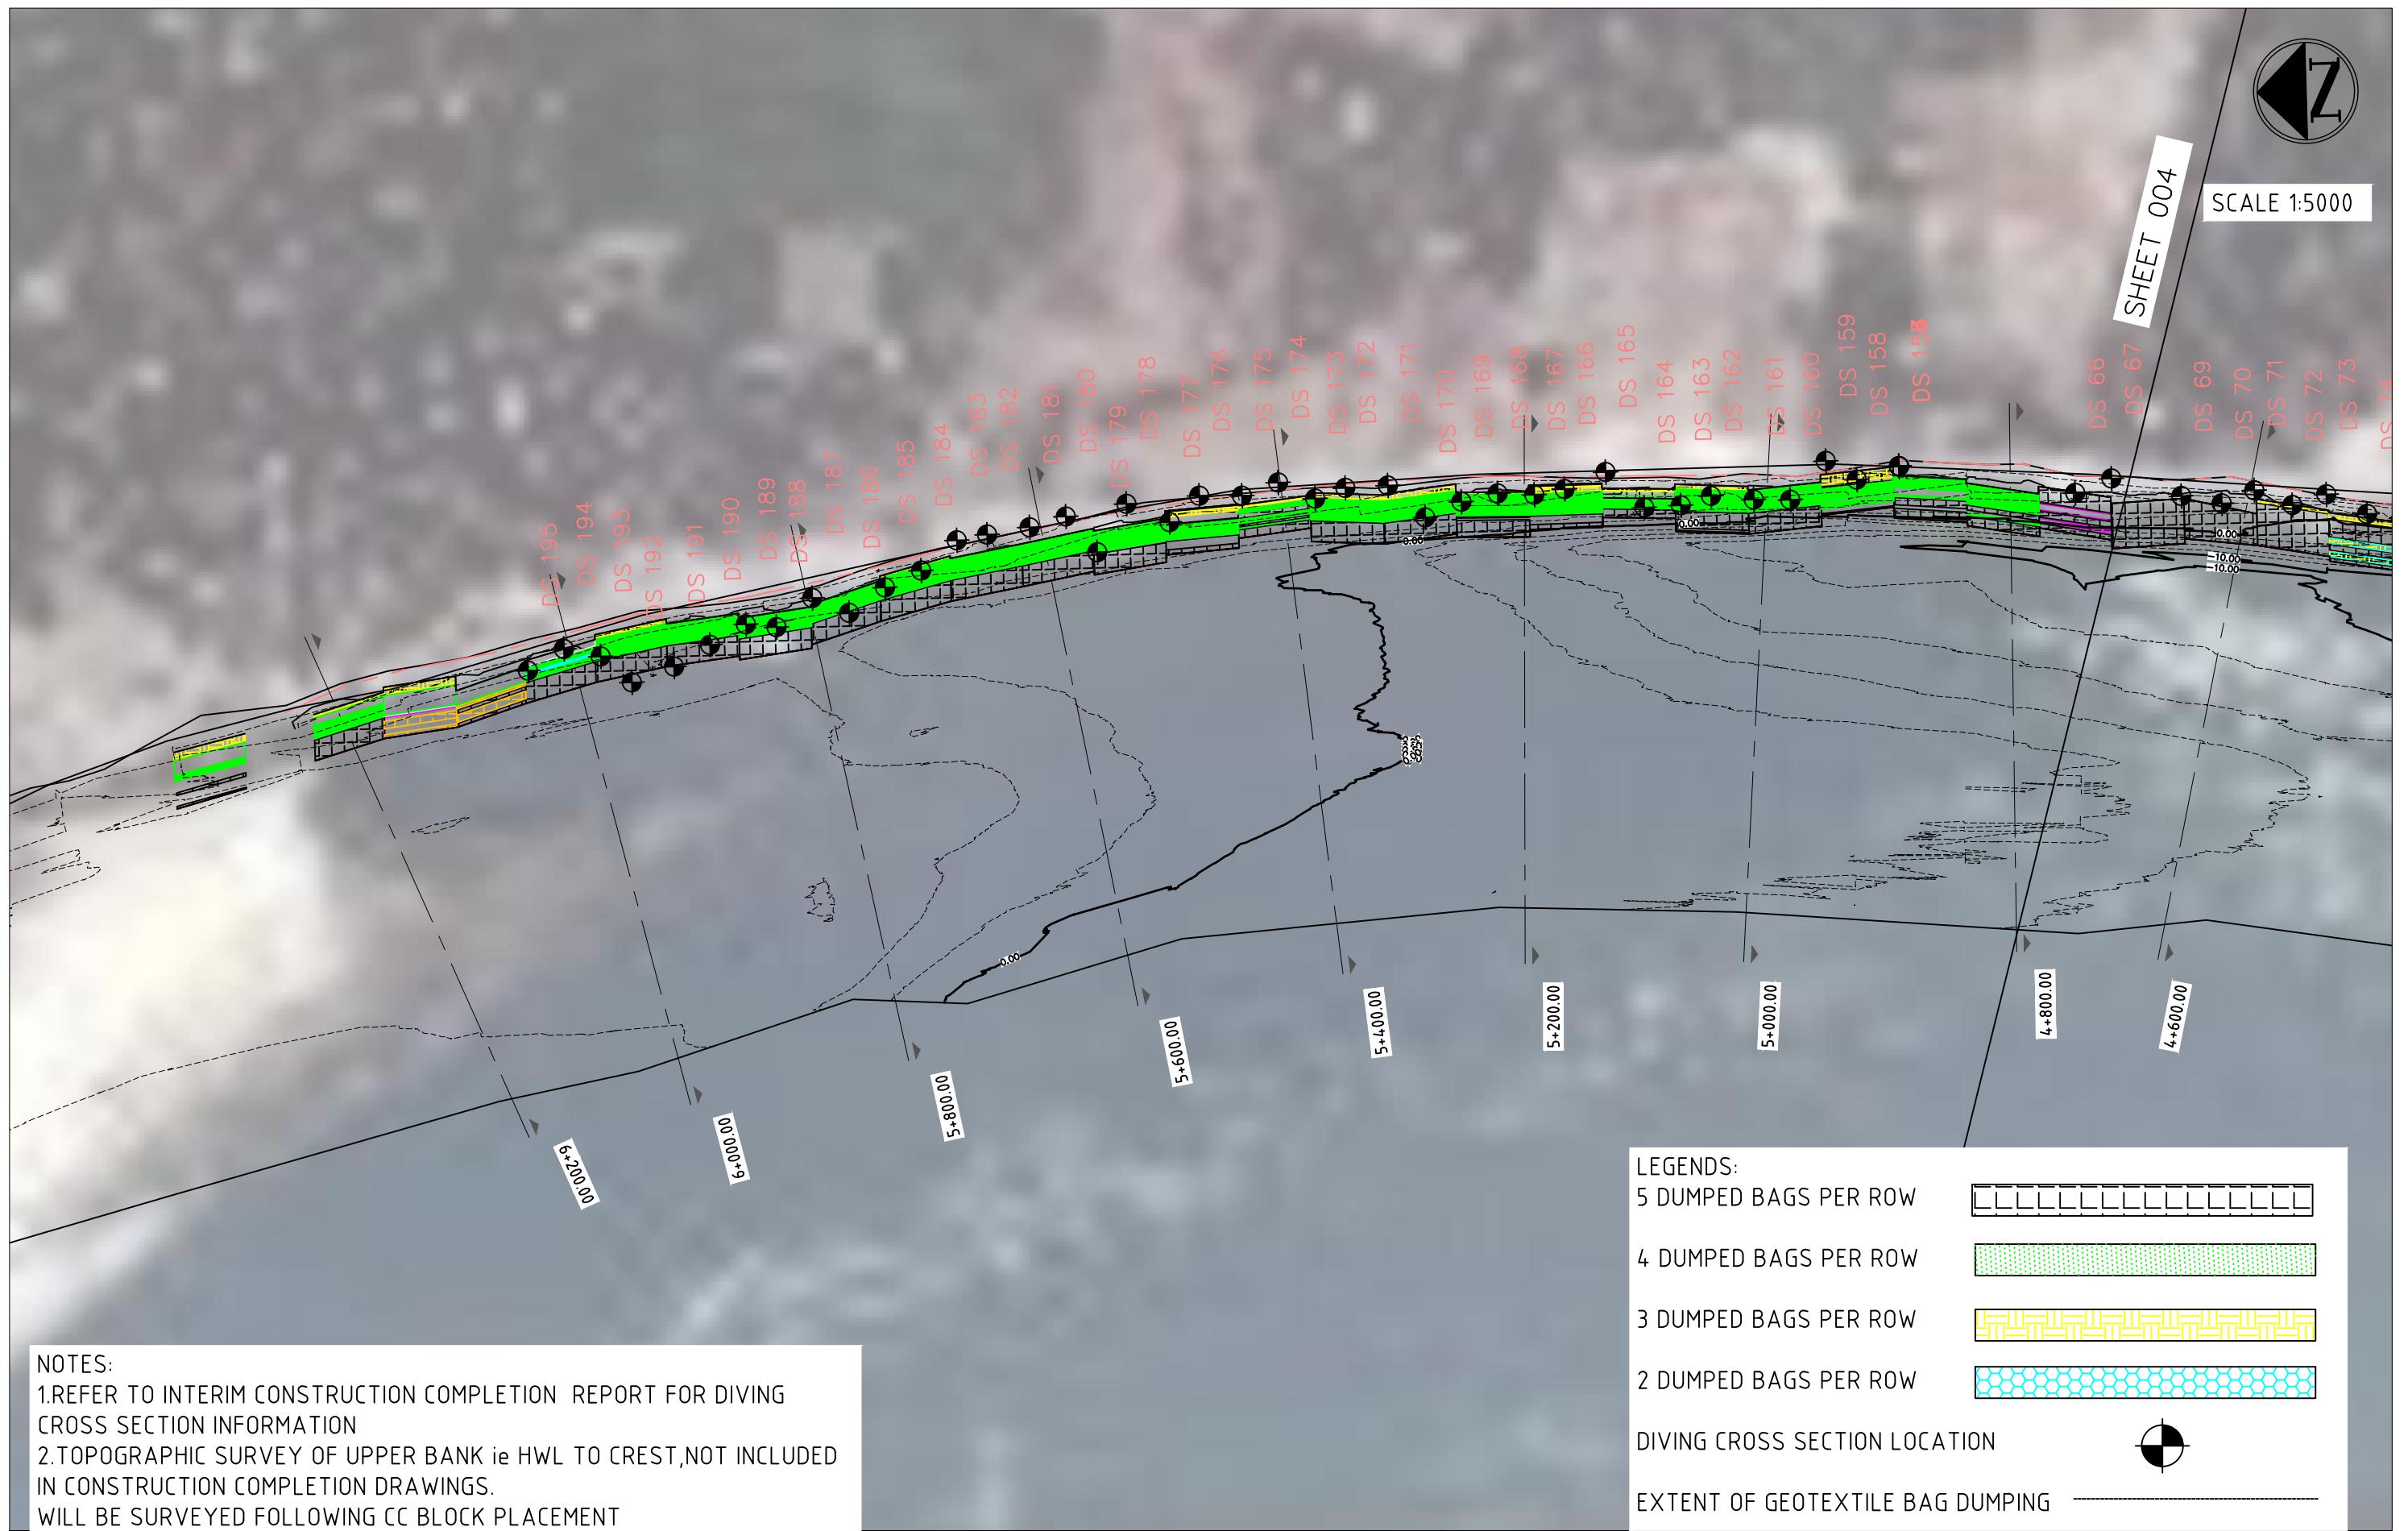

This drawing is confidential and shall only be used for the purposes of this project.

THE SIGNING OF THIS TITLE BLOCK CONFIRMS THE DESIGN AND DRAFTING OF THIS PROJECT HAVE BEEN PREPARED AND CHECKED

SCALES:

AS SHOWN IN THE DRAWING

SHEET NO.: 003



BANGLADESH WATER DEVELOPMENT BOARD

CONSULTANT

**nhc**  
northwest hydraulic consultants  
**Mott MacDonald**

FLOOD AND RIVERBANK EROSION RISK MANAGEMENT INVESTMENT PROGRAM

DRAWING NAME:

PLAN VIEW FROM KM 6+200 TO 4+600


STATUS: AS BUILT\_JULY 2016

DRAWING NO:

FRERMIP-ISPMC-CHA-01

REVISION: 0

0	MYA	28.07.2016	FIRST DRAFT	KO
No.	BY	DATE	DESCRIPTION	APPD

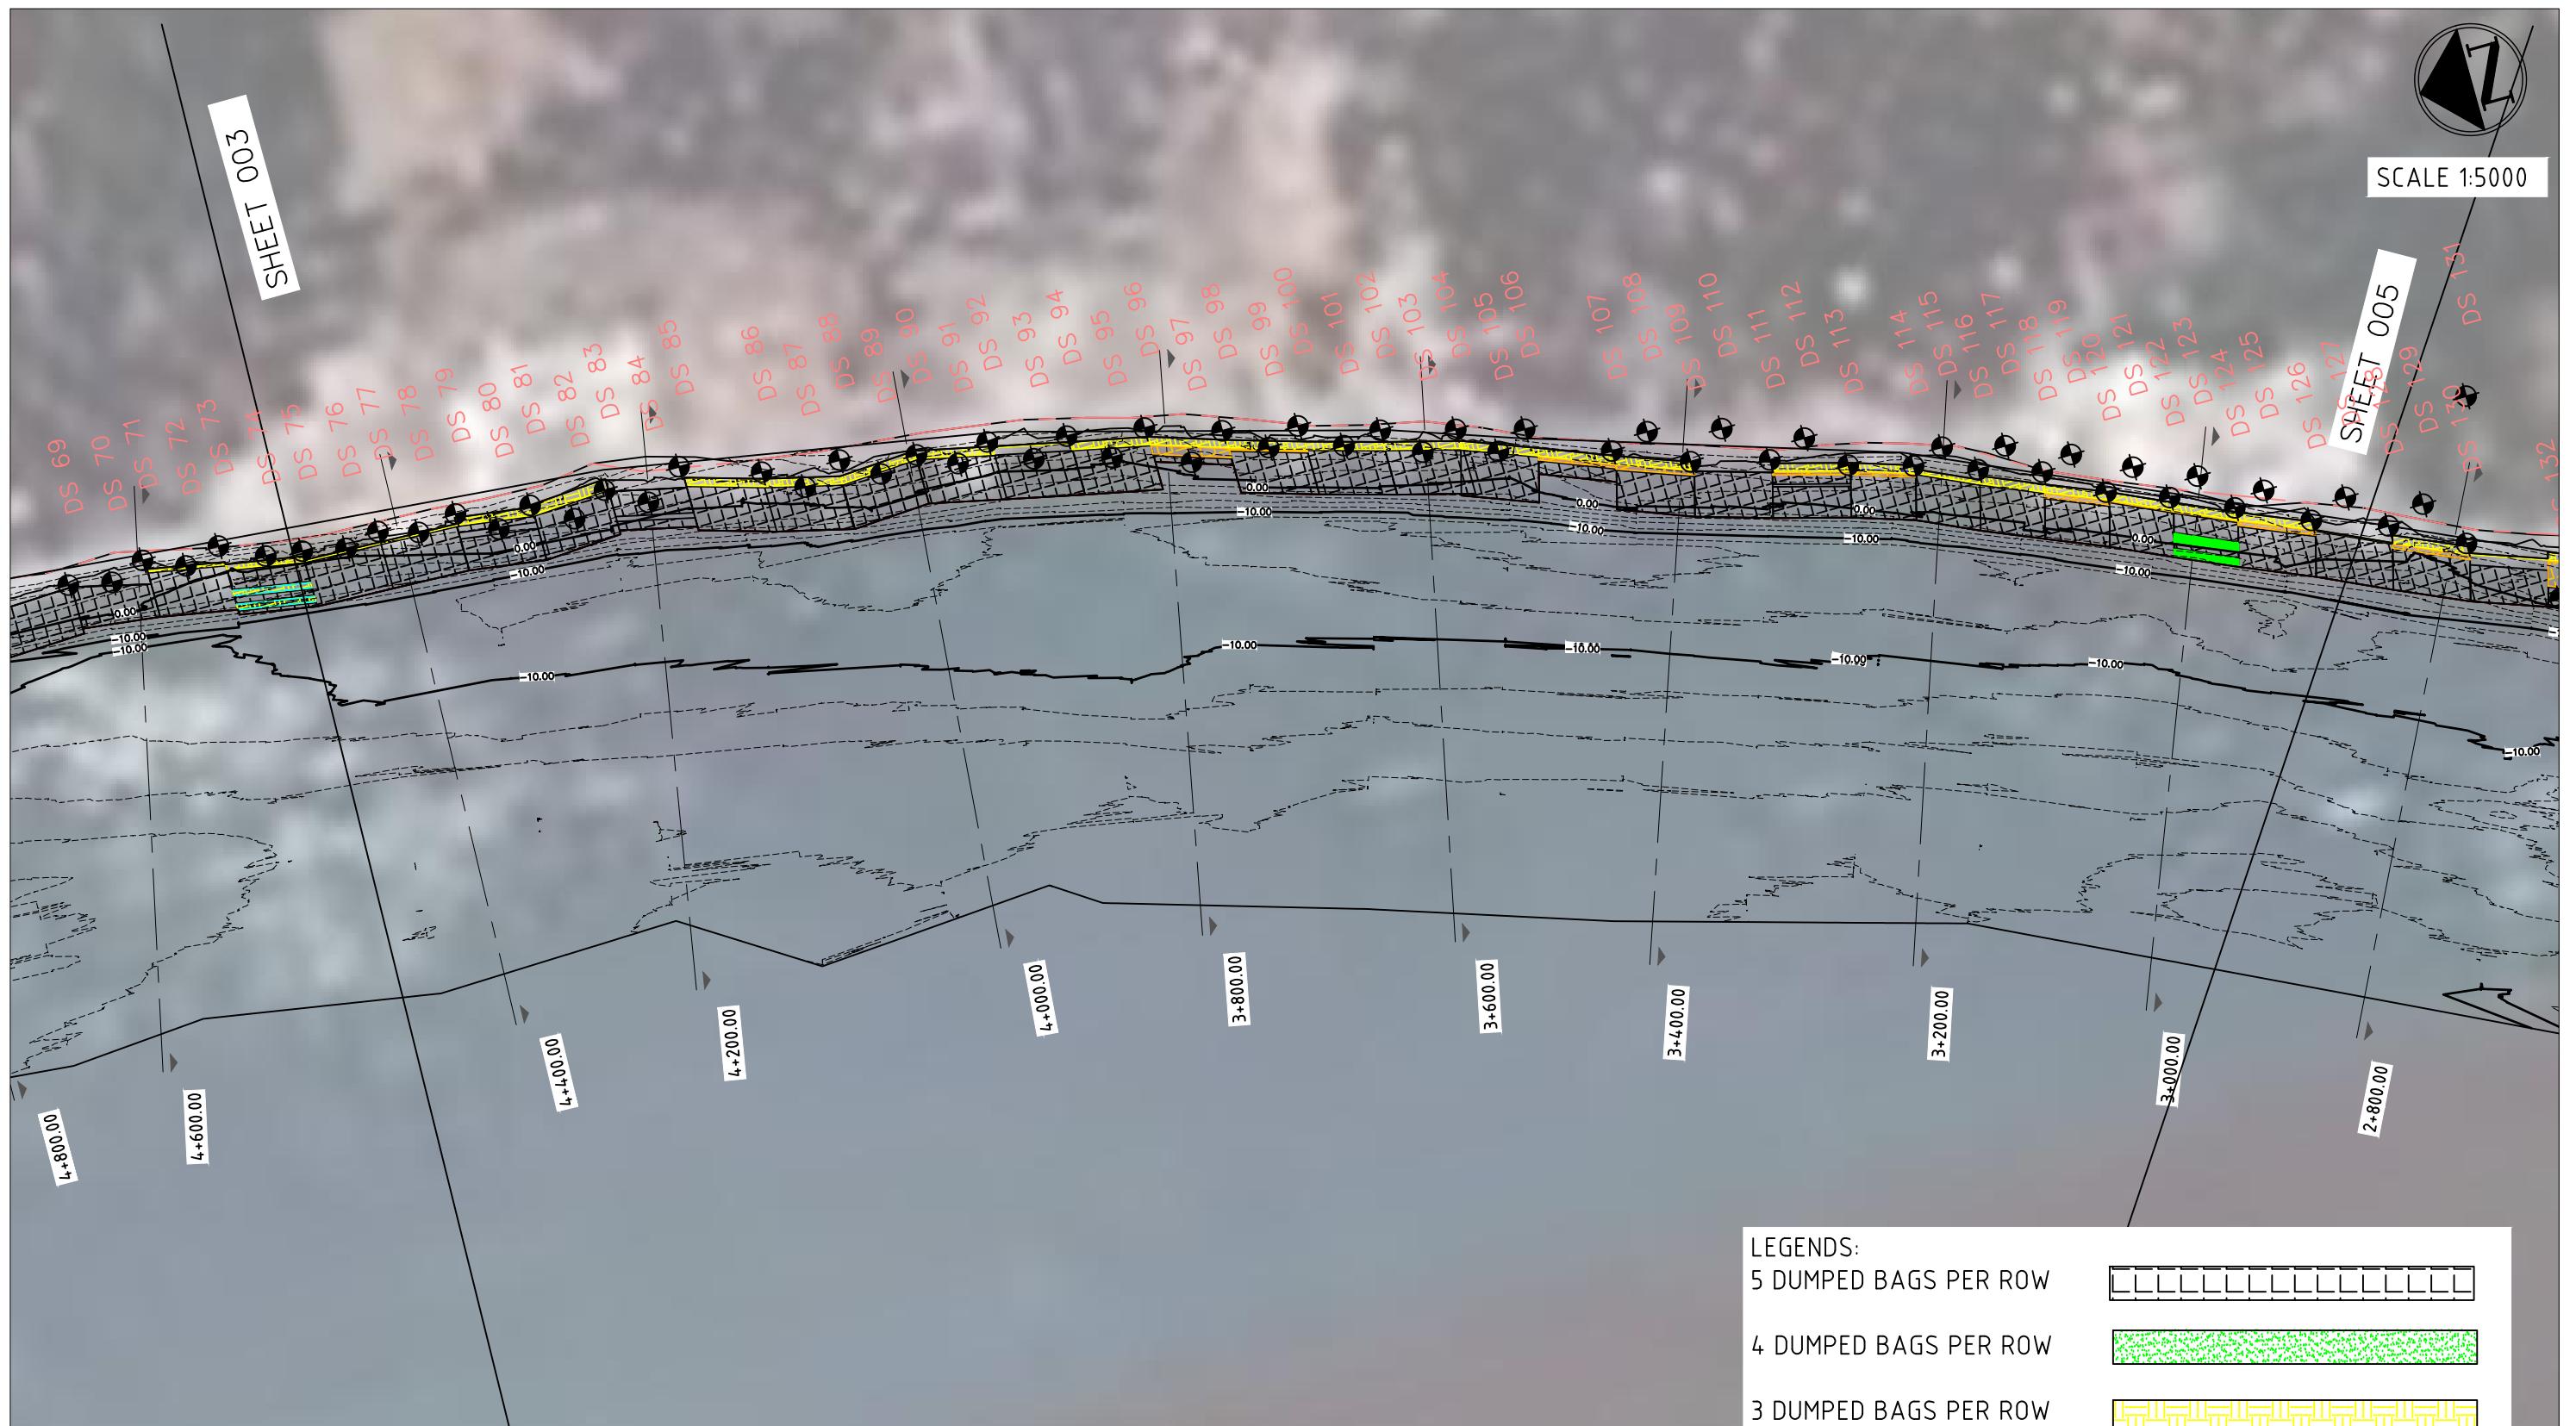

NOTES:

1. REFER TO INTERIM CONSTRUCTION COMPLETION REPORT FOR DIVING CROSS SECTION INFORMATION
2. TOPOGRAPHIC SURVEY OF UPPER BANK ie HWL TO CREST, NOT INCLUDED IN CONSTRUCTION COMPLETION DRAWINGS.  
WILL BE SURVEYED FOLLOWING CC BLOCK PLACEMENT

LEGENDS:

5 DUMPED BAGS PER ROW



4 DUMPED BAGS PER ROW



3 DUMPED BAGS PER ROW



2 DUMPED BAGS PER ROW



DIVING CROSS SECTION LOCATION



EXTENT OF GEOTEXTILE BAG DUMPING

This drawing is confidential and shall only be used for the purposes of this project.

THE SIGNING OF THIS TITLE BLOCK CONFIRMS THE DESIGN AND DRAFTING  
OF THIS PROJECT HAVE BEEN PREPARED AND CHECKED

SCALES:

AS SHOWN IN THE DRAWING

CLIENT:



BANGLADESH WATER DEVELOPMENT BOARD

CONSULTANT



northwest hydraulic consultants



MOTT MACDONALD

FLOOD AND RIVERBANK EROSION RISK MANAGEMENT INVESTMENT PROGRAM

DRAWING NAME:

PLAN VIEW FROM KM 4+600 TO 2+800

STATUS: AS BUILT\_JULY 2016


DRAWING NO:

FRERMIP-ISPMC-CHA-01

REVISION: 0

0	MYA	28.07.2016	FIRST DRAFT	KO
No.	BY	DATE	DESCRIPTION	APPD

SHEET NO: 004

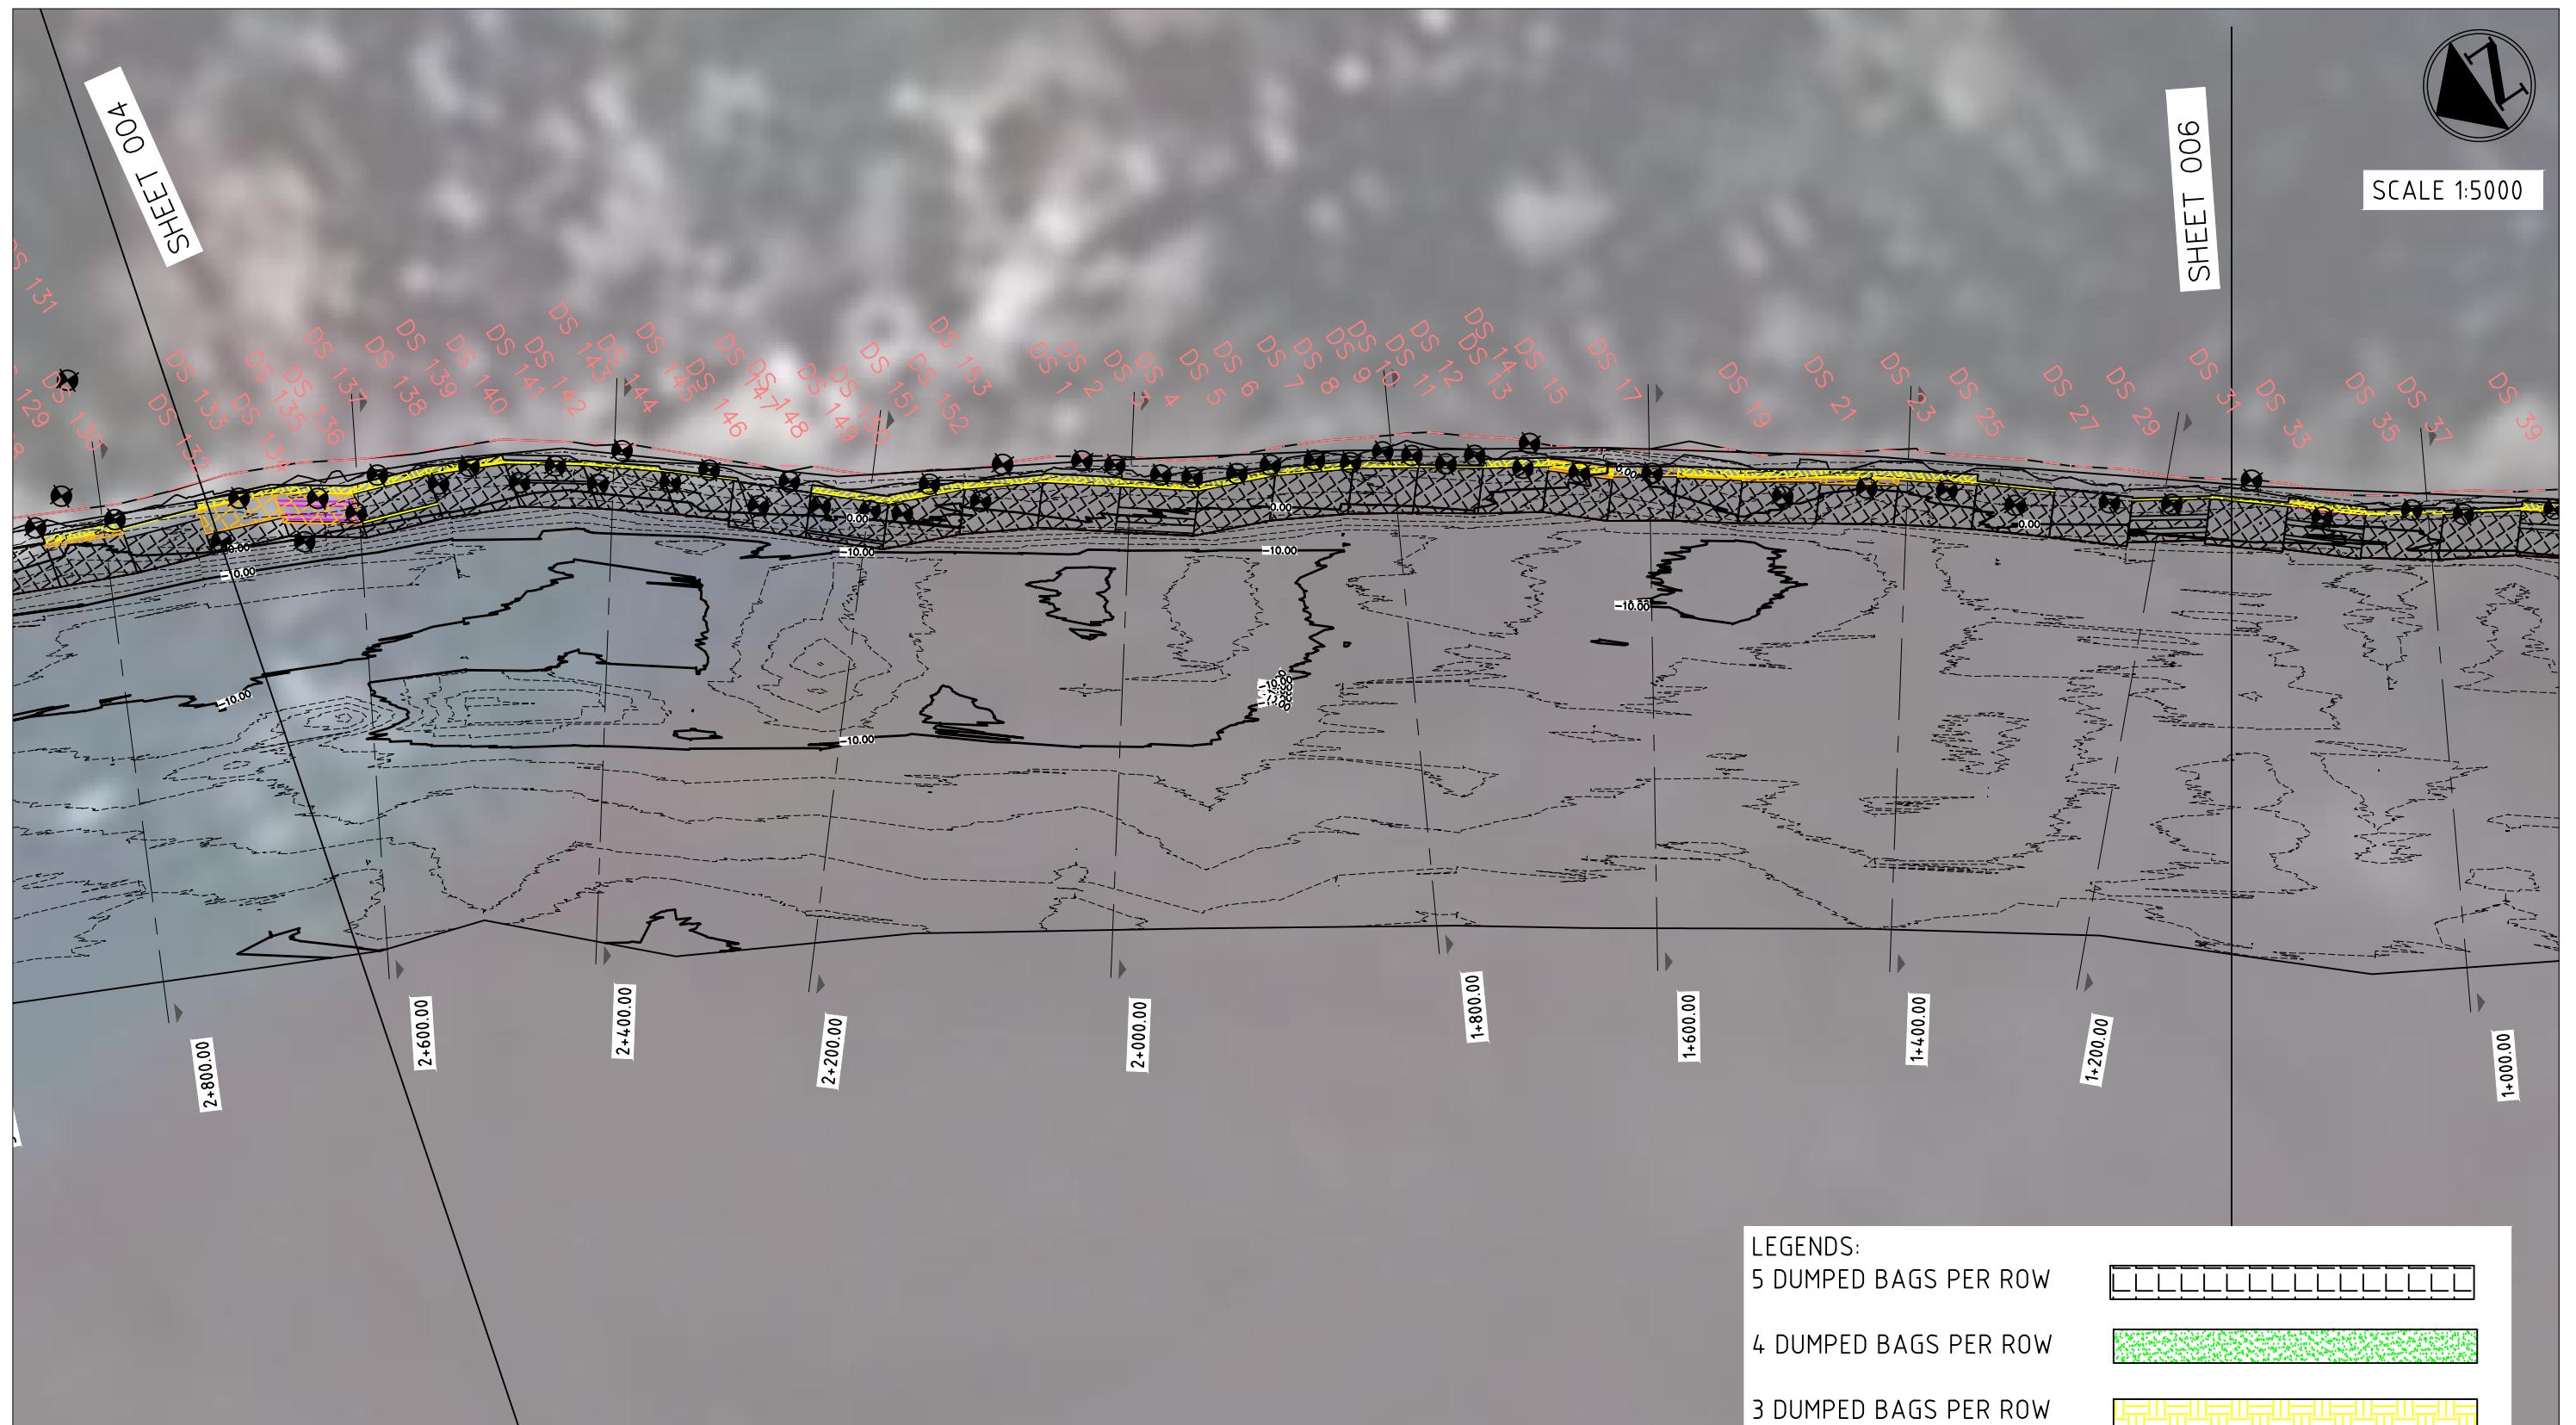

**NOTES:**

1. REFER TO INTERIM CONSTRUCTION COMPLETION REPORT FOR DIVING CROSS SECTION INFORMATION
  2. TOPOGRAPHIC SURVEY OF UPPER BANK ie HWL TO CREST, NOT INCLUDED IN CONSTRUCTION COMPLETION DRAWINGS.  
WILL BE SURVEYED FOLLOWING CC BLOCK PLACEMENT

## LEGENDS:

5 DUMPED BAGS PFR ROW



4 DUMPED BAGS PER ROW



3 DUMPED BAGS PER ROW



2 DUMPED BAGS PER ROW




## EXTENT OF GEOTEXTILE BAG DUMPING

This drawing is confidential and shall only be used for the purposes of this project.				THE SIGNING OF THIS TITLE BLOCK CONFIRMS THE DESIGN AND DRAFTING OF THIS PROJECT HAVE BEEN PREPARED AND CHECKED				SCALES:  AS SHOWN IN THE DRAWING	CLIENT:  	CONSULTANT   northwest hydraulic consultants	FLOOD AND RIVERBANK EROSION RISK MANAGEMENT INVESTMENT PROGRAM			
		DESIGNED	MYA	CHECKED	GV									
		DRAWN	MYA	CHECKED	GV									
		APPROVED	KO	DATE										
0	MYA	28.07.2016	FIRST DRAFT	KO	SHEET NO: 005		STATUS: AS BUILT_JULY 2016	DRAWING NO: FRERMIP-ISPMC-CHA-01	REVISION: 0					
No.	BY	DATE	DESCRIPTION	APPD										



SCALE 1:5000

SHEET 005

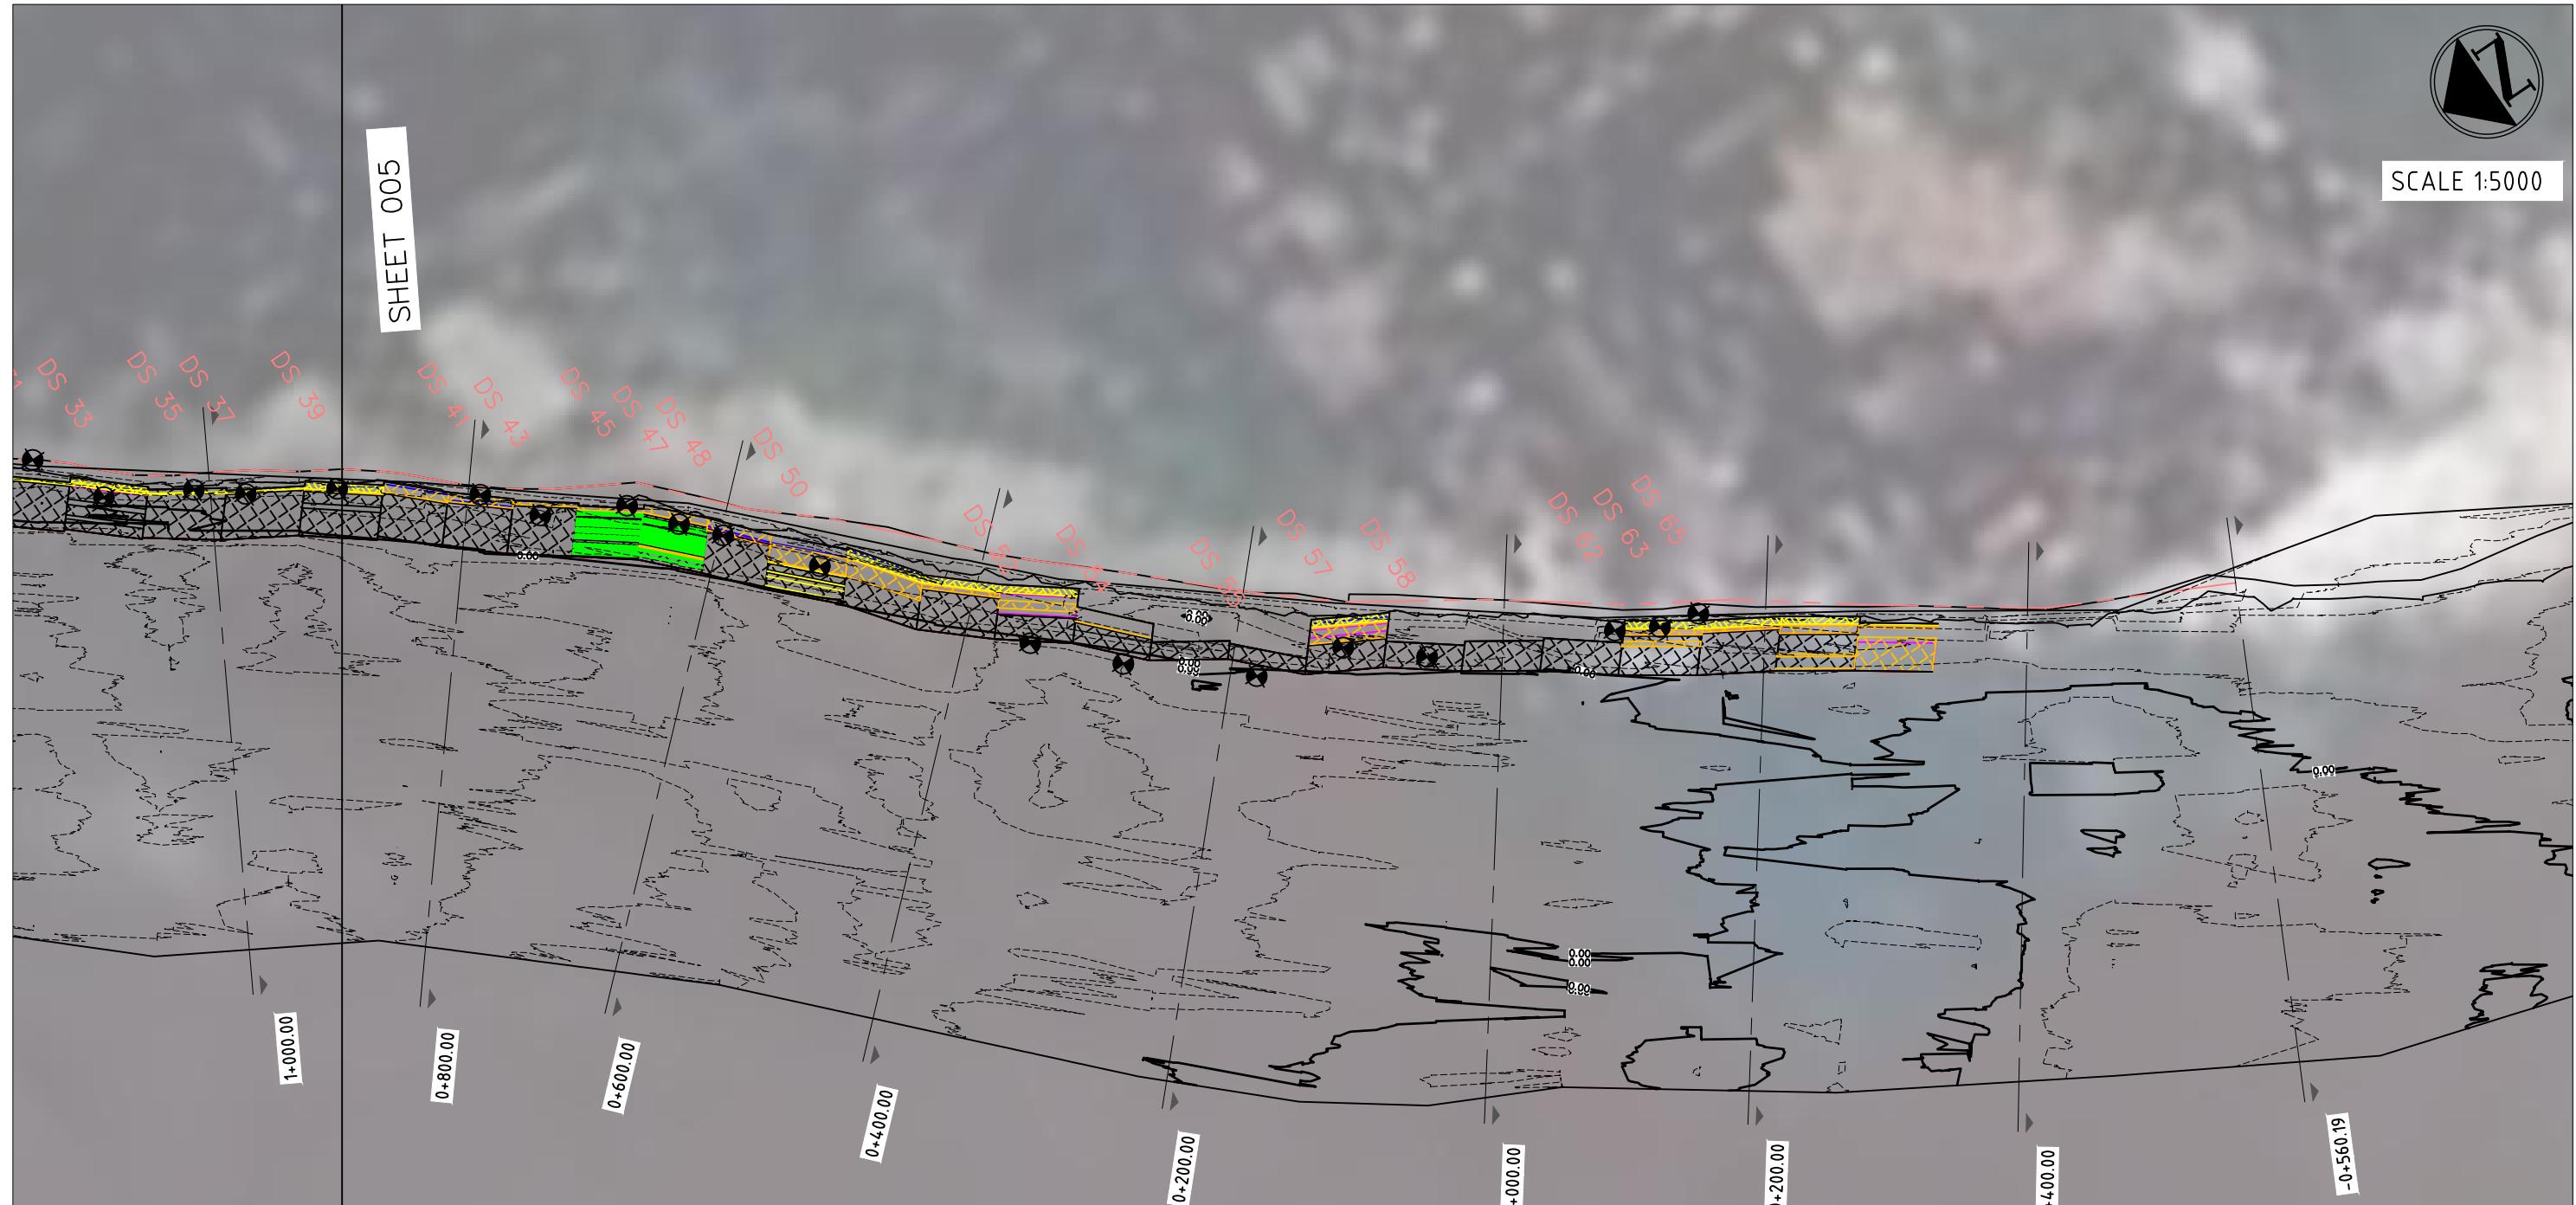

## LEGENDS:

## 5 DUMPED BAGS PER ROW




4 DUMPED BAGS PFR ROW



3 DUMPED BAGS PER ROW



2 DUMPED BAGS PER ROW

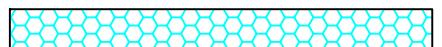

## DIVING CROSS SECTION LOCATION



## EXTENT OF GEOTEXTILE BAG DUMPING

**NOTES:**

1. REFER TO INTERIM CONSTRUCTION COMPLETION REPORT FOR DIVING CROSS SECTION INFORMATION
  2. TOPOGRAPHIC SURVEY OF UPPER BANK ie HWL TO CREST, NOT INCLUDED IN CONSTRUCTION COMPLETION DRAWINGS.  
WILL BE SURVEYED FOLLOWING CC BLOCK PLACEMENT

This drawing is confidential and shall only be used for the purposes of this project.

THE SIGNING OF THIS TITLE BLOCK CONFIRMS THE DESIGN AND DRAFTING  
OF THIS PROJECT HAVE BEEN PREPARED AND CHECKED

SCA

ES:

CLIENT



BANGLADESH WATER DEVELOPMENT BOARD

NET NO: 555

1

The logo for nhc northwest hydraulic consulting. It features the lowercase letters "nhc" in a large, bold, blue sans-serif font. Below "nhc", the words "northwest hydraulic" are written in a smaller, black, all-caps sans-serif font.

1

Mott







FLOOD AND RIVERBANK EROSION RISK MANAGEMENT INVESTMENT PROGRAM

**STUDENT NAME:**

PLAN VIEW FROM KM 1+000 TO -0+560.19

---

**REVISION:**

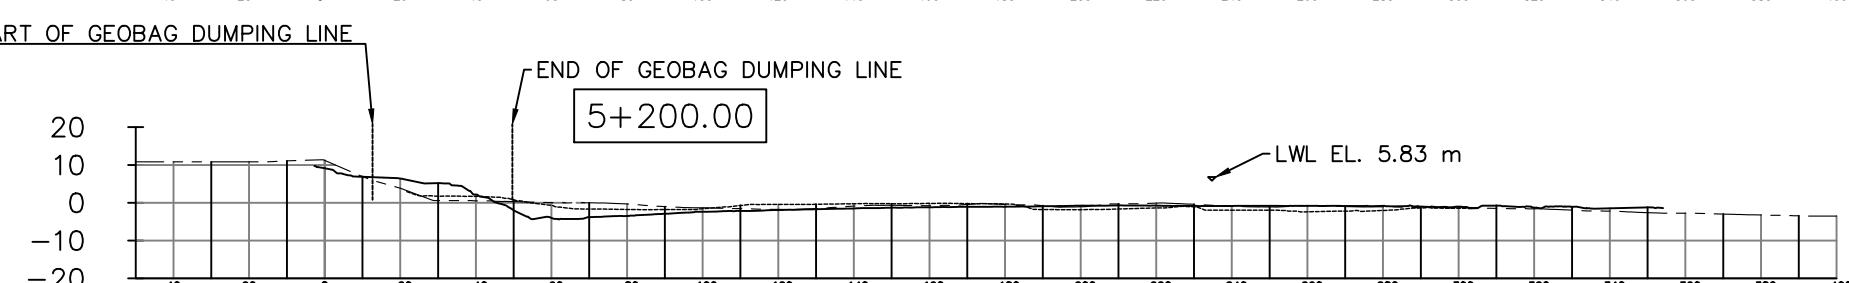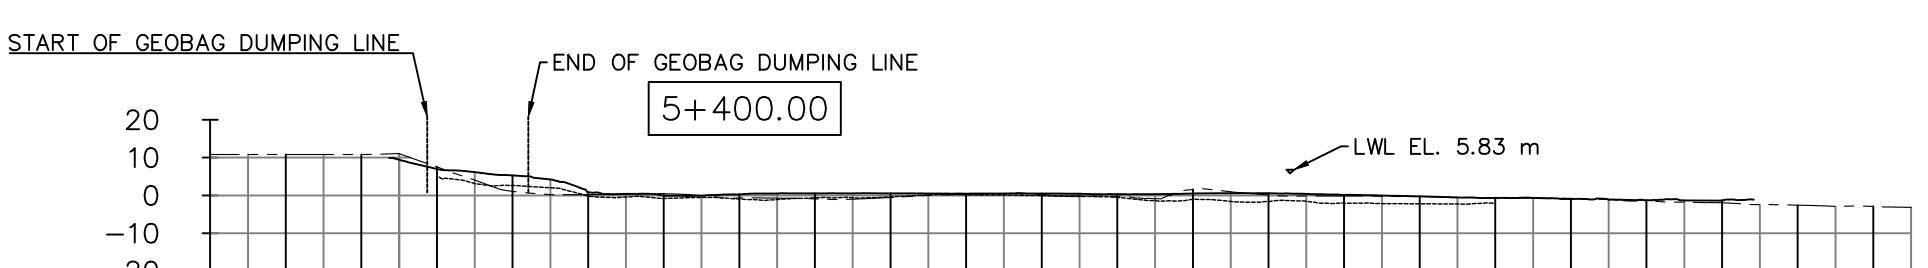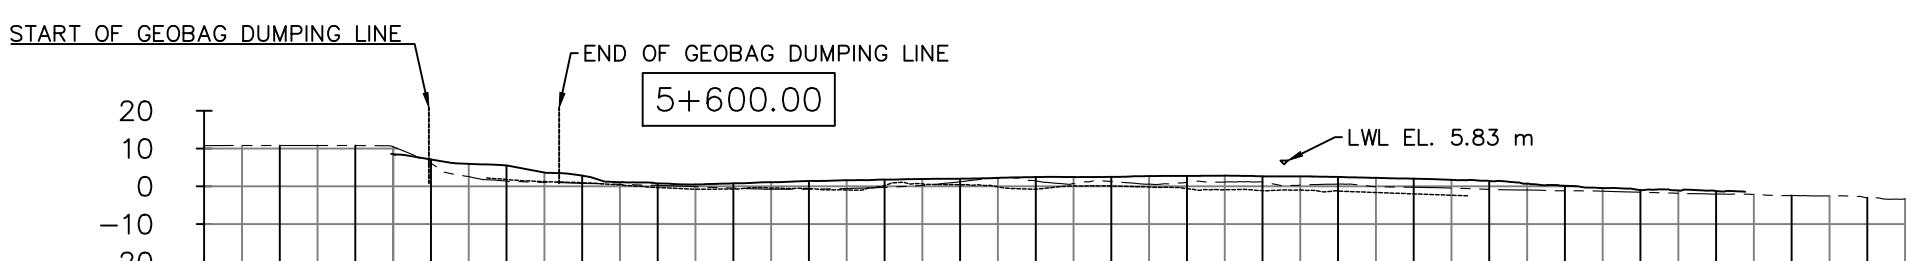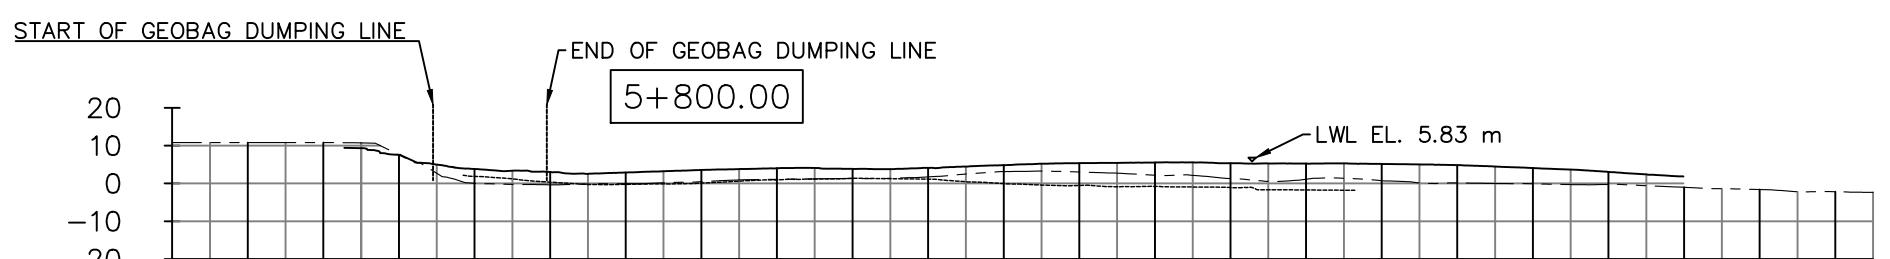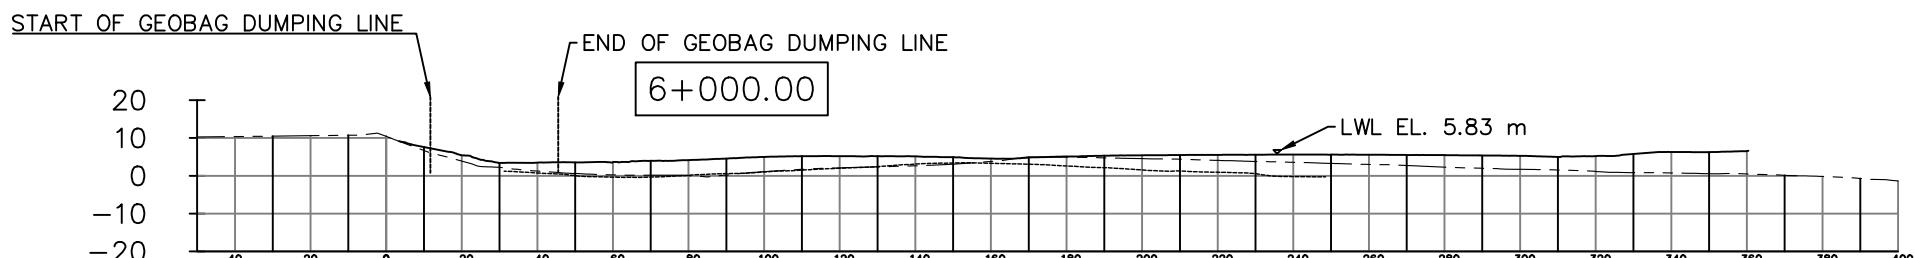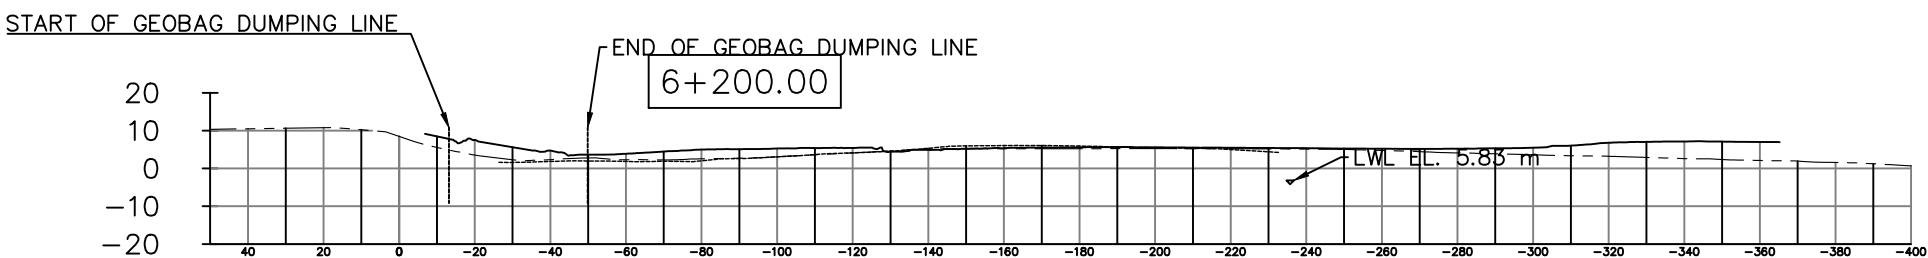

LEGENDS:

PRE-CONSTRUCTION SURVEY	-----
MAY AS-BUILT SURVEY	-----
JULY AS-BUILT SURVEY	-----

This drawing is confidential and shall only be used for the purposes of this project.

THE SIGNING OF THIS TITLE BLOCK CONFIRMS THE DESIGN AND DRAFTING OF THIS PROJECT HAVE BEEN PREPARED AND CHECKED

SCALES:

AS SHOWN IN THE DRAWING

CLIENT:



BANGLADESH WATER DEVELOPMENT BOARD

CONSULTANT

**nhc**  
northwest hydraulic consultants

Mott MacDonald

FLOOD AND RIVERBANK EROSION RISK MANAGEMENT INVESTMENT PROGRAM

DRAWING NAME:

SECTION KM 6+200 TO KM 5+200

STATUS:

AS BUILT\_JULY 2016







DRAWING NO:

FRERMIP-ISPMC-CHA-01

REVISION: 0

0	MYA	28.07.2016	FIRST DRAFT	KO
No.	BY	DATE	DESCRIPTION	APPD

SHEET NO.: 007

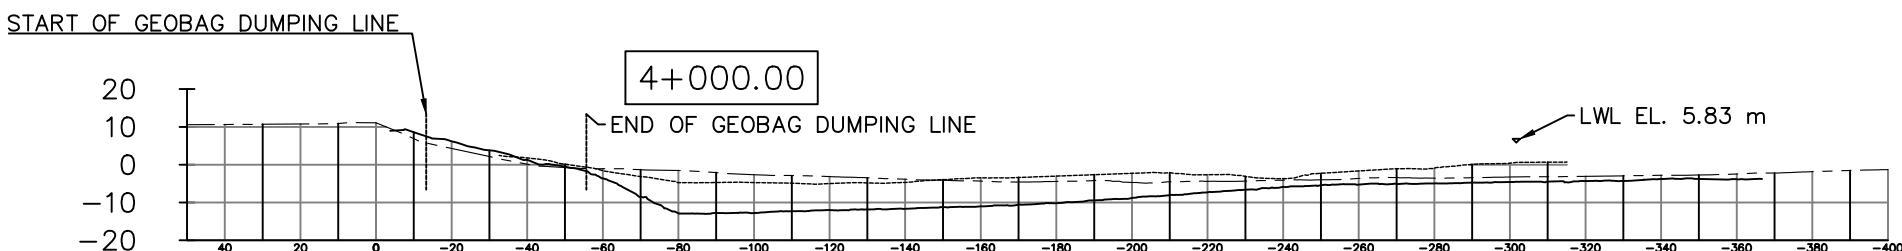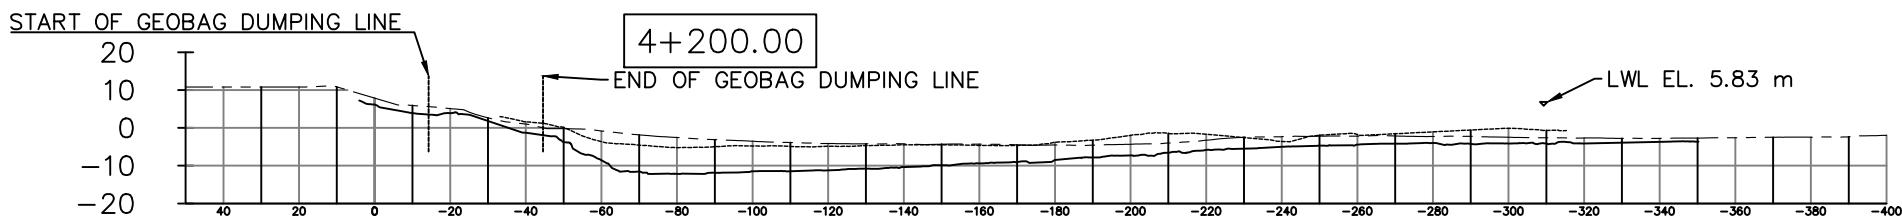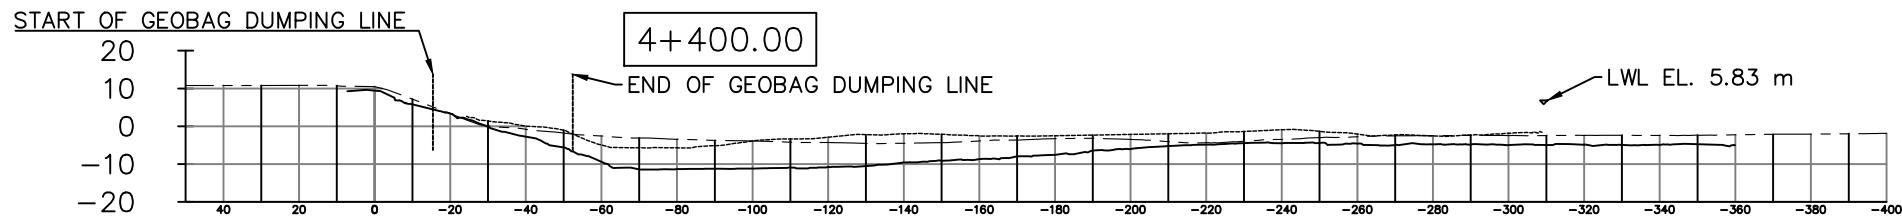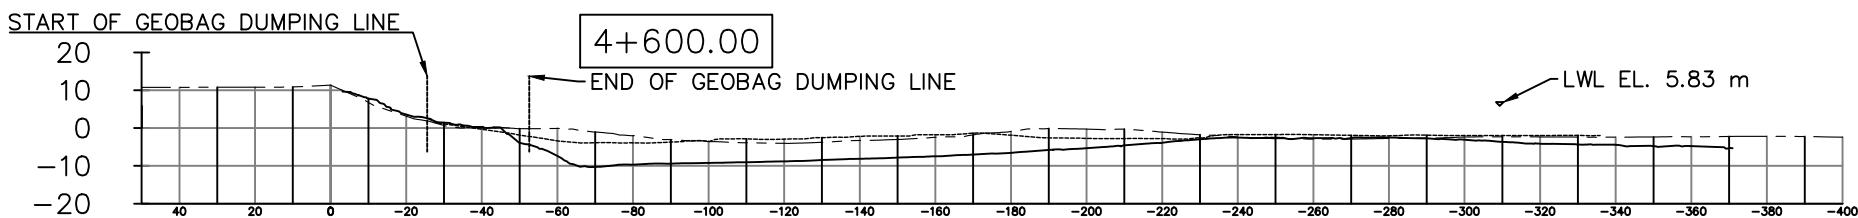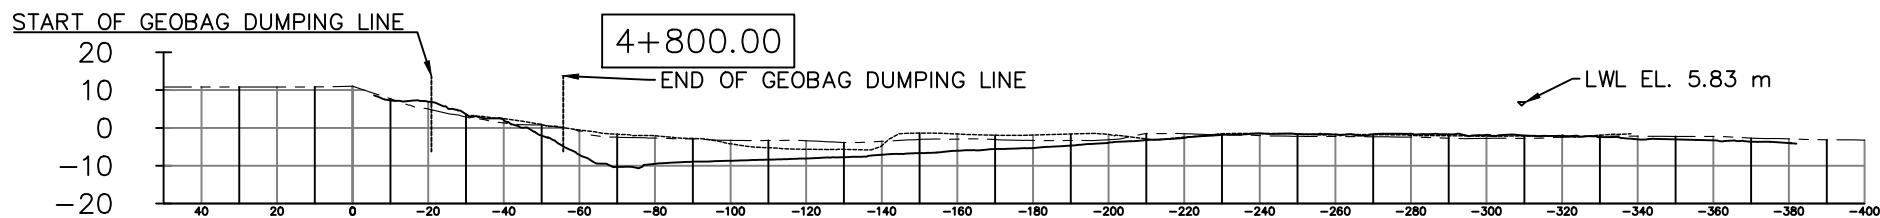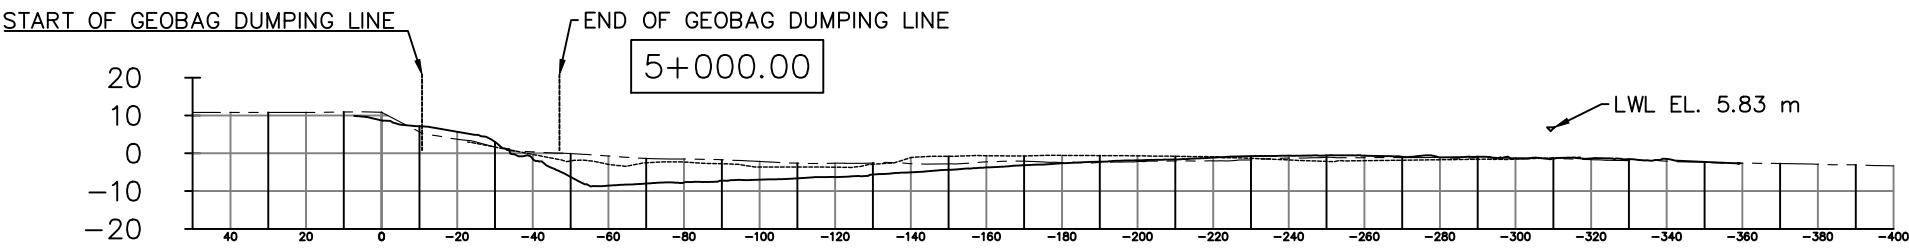







## LEGENDS:

## PRE-CONSTRUCTION SURVEY—

## MAY AS-BUILT SURVEY

JULY AS-BUILT SURVEY







This drawing is confidential and shall only be used for the purposes of this project.				THE SIGNING OF THIS TITLE BLOCK CONFIRMS THE DESIGN AND DRAFTING OF THIS PROJECT HAVE BEEN PREPARED AND CHECKED				SCALES:  AS SHOWN IN THE DRAWING	CLIENT:  	CONSULTANT  <b>nhc</b> northwest hydraulic consultants 	FLOOD AND RIVERBANK EROSION RISK MANAGEMENT INVESTMENT PROGRAM			
		DESIGNED	MYA	CHECKED	GV	DRAWING NAME:								
		DRAWN	MYA	CHECKED	GV	SECTION KM 5+000 TO KM 4+000								
		APPROVED	KO	DATE										
0	MYA	28.07.2016	FIRST DRAFT	KO	SHEET NO:	008	STATUS: AS BUILT JULY 2016							
No	RY	DATE	DESCRIPTION	APPD	DRAWING NO:				FRERMIP-ISPMC-CHA-01	REVISION:	0			

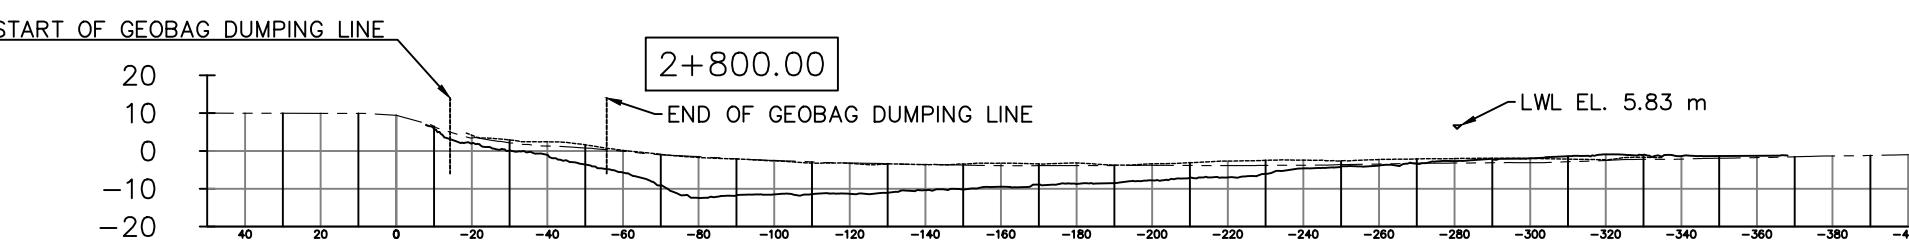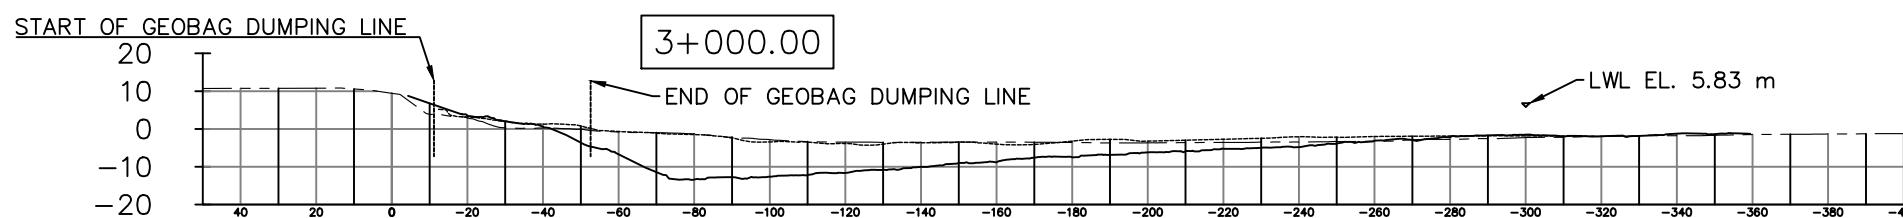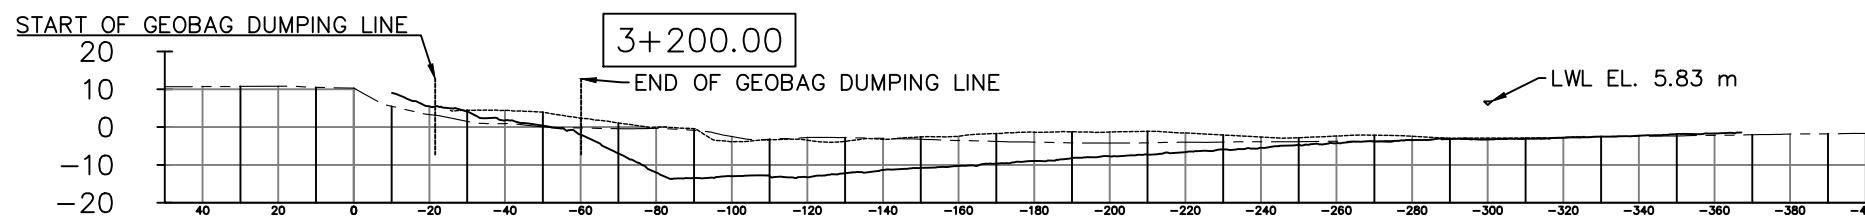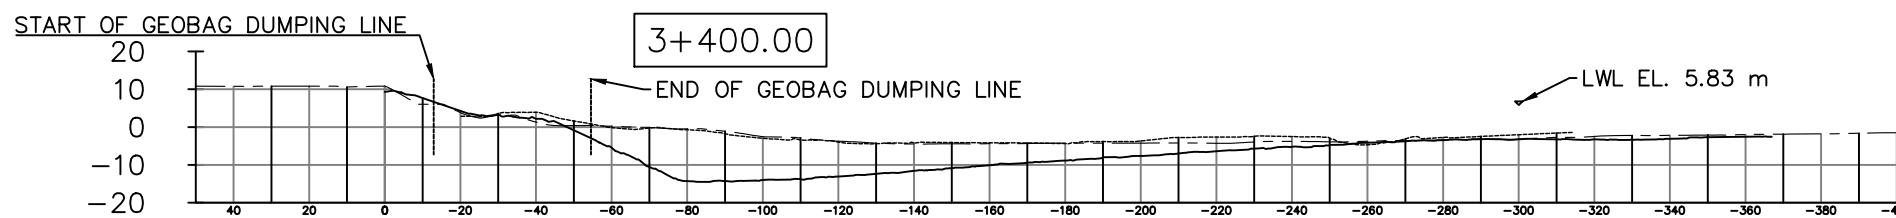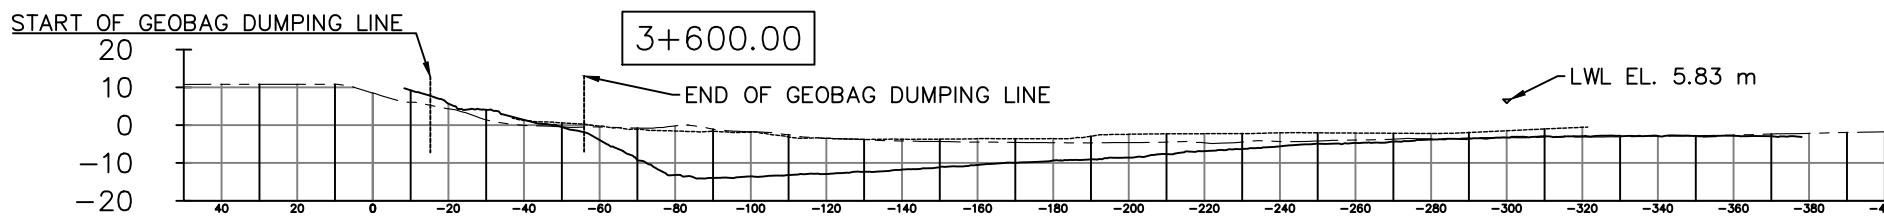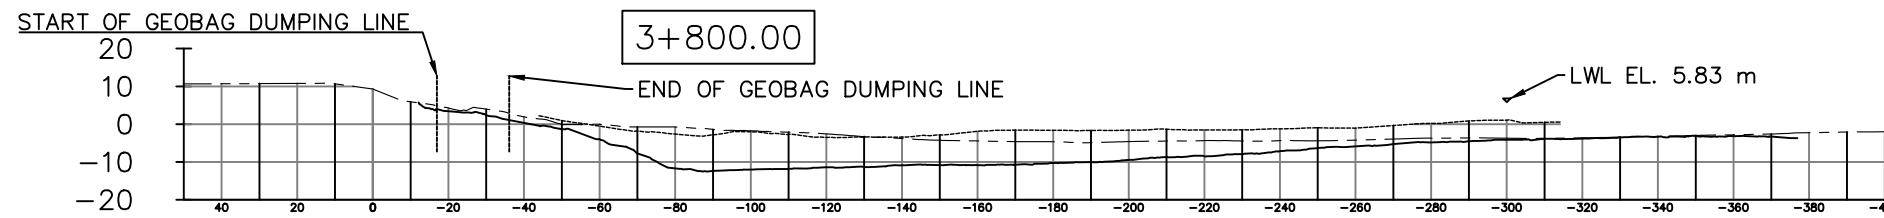

LEGENDS:

PRE-CONSTRUCTION SURVEY	-----
MAY AS-BUILT SURVEY	-----
JULY AS-BUILT SURVEY	-----

This drawing is confidential and shall only be used for the purposes of this project.				THE SIGNING OF THIS TITLE BLOCK CONFIRMS THE DESIGN AND DRAFTING OF THIS PROJECT HAVE BEEN PREPARED AND CHECKED				SCALES:	CLIENT:	CONSULTANT	FLOOD AND RIVERBANK EROSION RISK MANAGEMENT INVESTMENT PROGRAM			
				DESIGNED	MYA	CHECKED	GV							
				DRAWN	MYA	CHECKED	GV							
				APPROVED	KO	DATE								
0	MYA	28.07.2016	FIRST DRAFT	KO				SHEET NO.:	009	BANGLADESH WATER DEVELOPMENT BOARD	nhc northwest hydraulic consultants Mott MacDonald	DRAWING NAME: SECTION KM 3+800 TO KM 2+800		
No.	BY	DATE	DESCRIPTION	APPD						STATUS:	AS BUILT_JULY 2016	DRAWING NO.:	FRERMIP-ISPMC-CHA-01	REVISION: 0

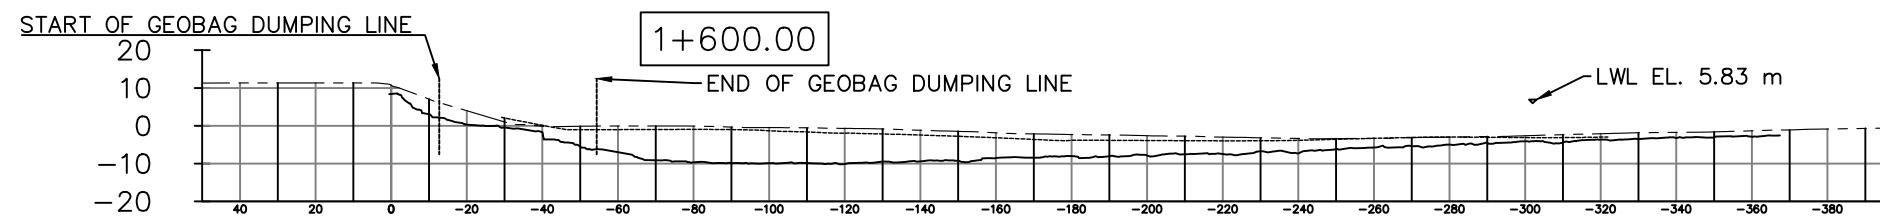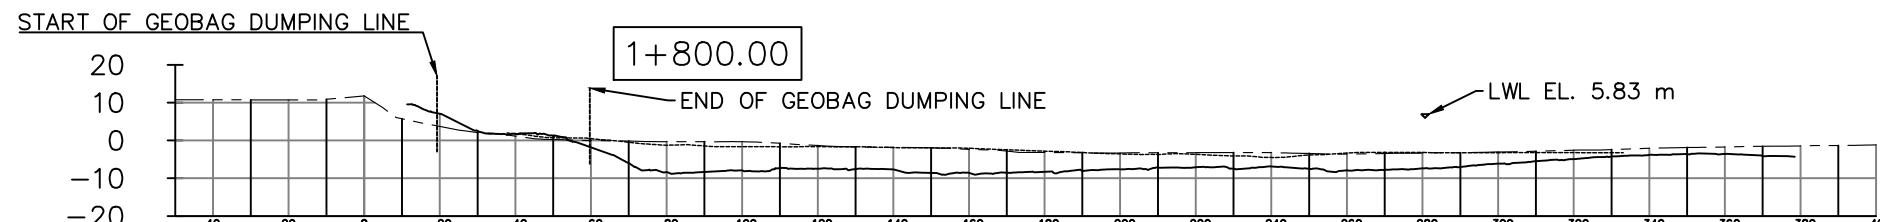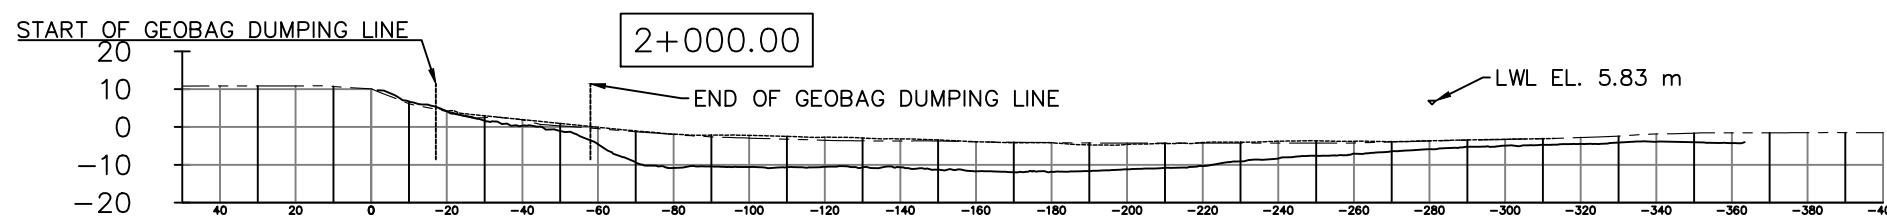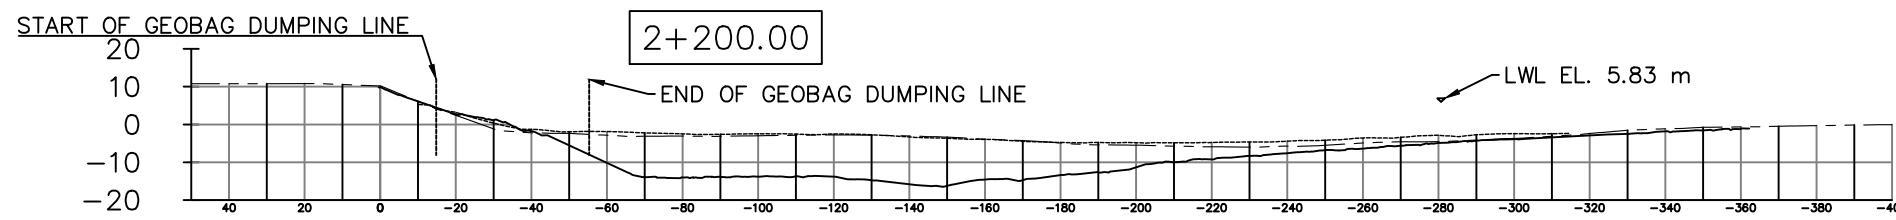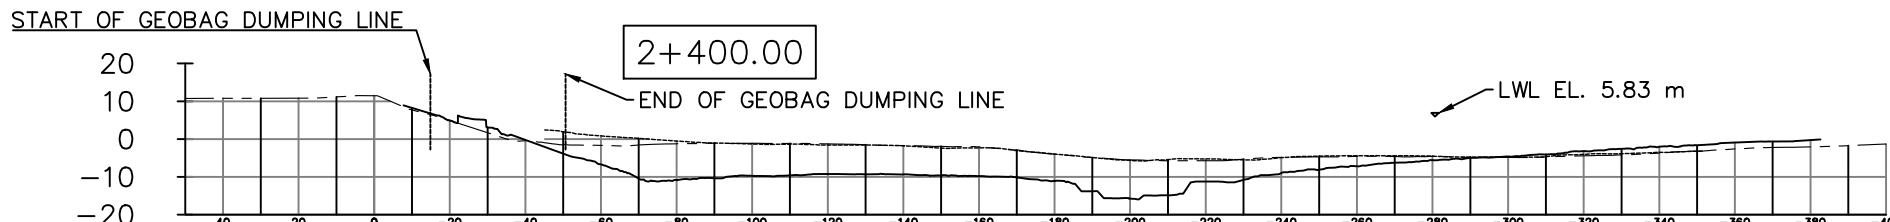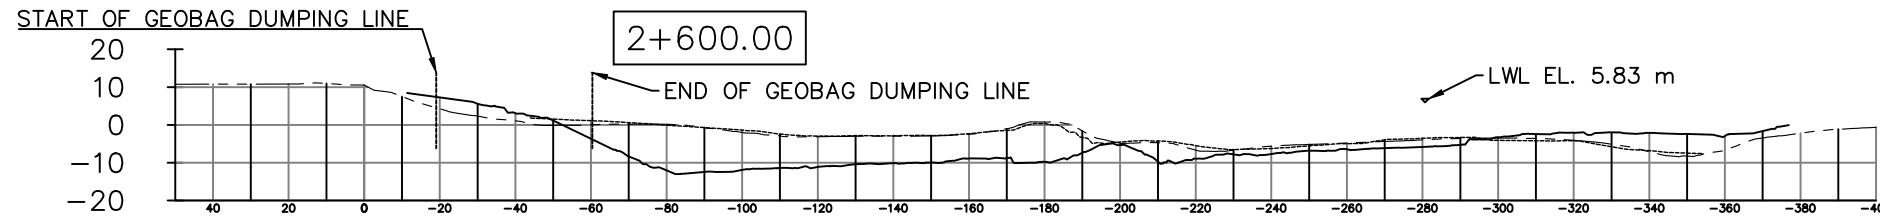


LEGENDS:

PRE-CONSTRUCTION SURVEY -----

MAY AS-BUILT SURVEY -----

JULY AS-BUILT SURVEY -----

This drawing is confidential and shall only be used for the purposes of this project.				THE SIGNING OF THIS TITLE BLOCK CONFIRMS THE DESIGN AND DRAFTING OF THIS PROJECT HAVE BEEN PREPARED AND CHECKED				SCALES:	CLIENT:  AS SHOWN IN THE DRAWING  BANGLADESH WATER DEVELOPMENT BOARD	CONSULTANT:   northwest hydraulic consultants  Mott MacDonald	FLOOD AND RIVERBANK EROSION RISK MANAGEMENT INVESTMENT PROGRAM			
				DESIGNED	MYA	CHECKED	GV							
				DRAWN	MYA	CHECKED	GV							
				APPROVED	KO	DATE								
0	MYA	28.07.2016	FIRST DRAFT	KO				SHEET NO.: 011		DRAWING NAME:	SECTION KM 2+600 TO KM 1+600			
No.	BY	DATE	DESCRIPTION	APPD						DRAWING NO.:	FRERMIP-ISPMC-CHA-01			
										REVISION:	0			

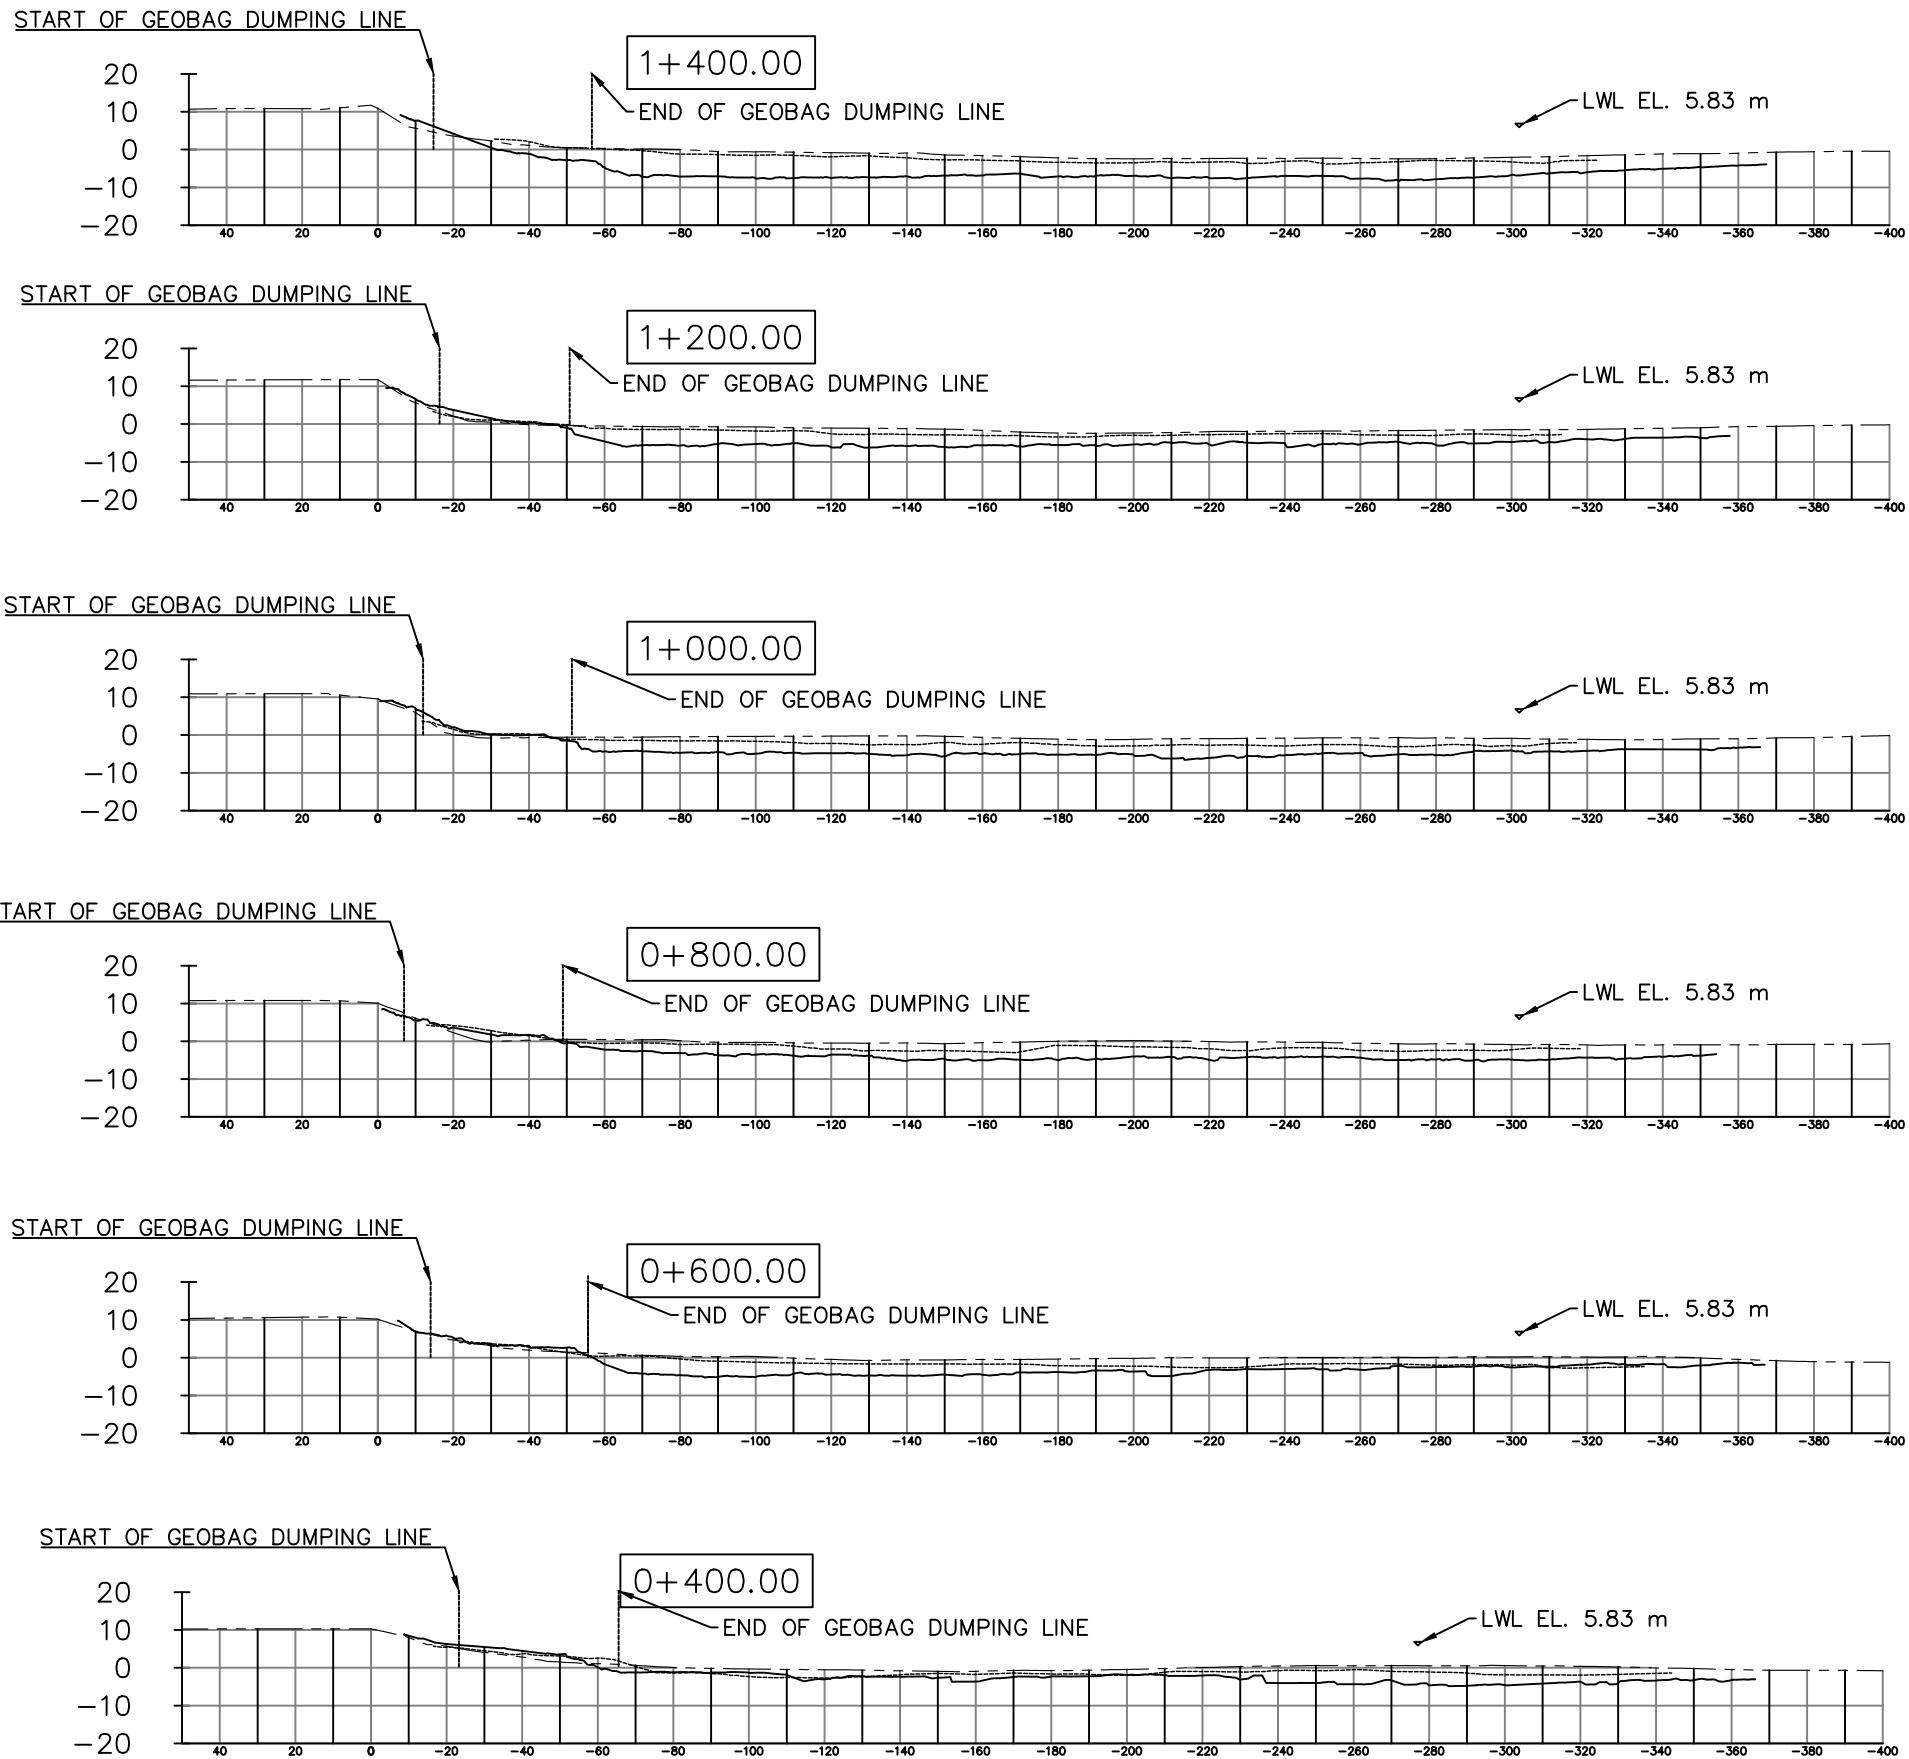






**LEGENDS:**

PRE-CONSTRUCTION SURVEY -----

MAY AS-BUILT SURVEY -----

JULY AS-BUILT SURVEY -----

This drawing is confidential and shall only be used for the purposes of this project.				THE SIGNING OF THIS TITLE BLOCK CONFIRMS THE DESIGN AND DRAFTING OF THIS PROJECT HAVE BEEN PREPARED AND CHECKED				SCALES:	CLIENT: 	CONSULTANT: <b>nhc</b> northwest hydraulic consultants 	FLOOD AND RIVERBANK EROSION RISK MANAGEMENT INVESTMENT PROGRAM			
DESIGNED	MYA	CHECKED	GV	DRAWN	MYA	CHECKED	GV	DRAWING NAME: SECTION KM 1+400 TO KM 0+400						
APPROVED	KO	DATE		SHEET NO.:	011		STATUS:	AS BUILT_JULY 2016		DRAWING NO.:	FRERMIP-ISPMC-CHA-01			REVISION: 0
0	MYA	28.07.2016	FIRST DRAFT	KO			No.	BY	DATE	DESCRIPTION	APPD			

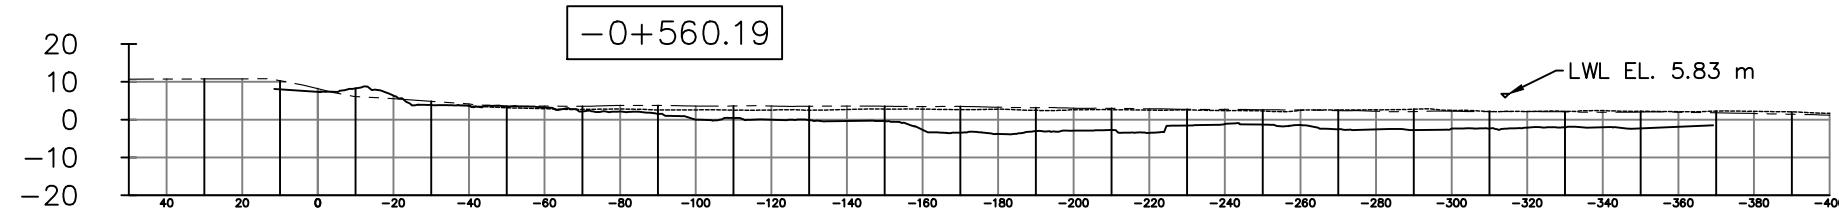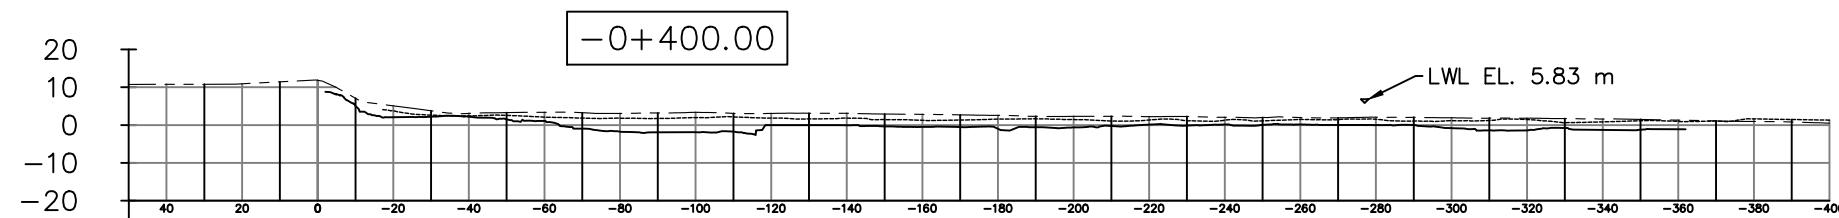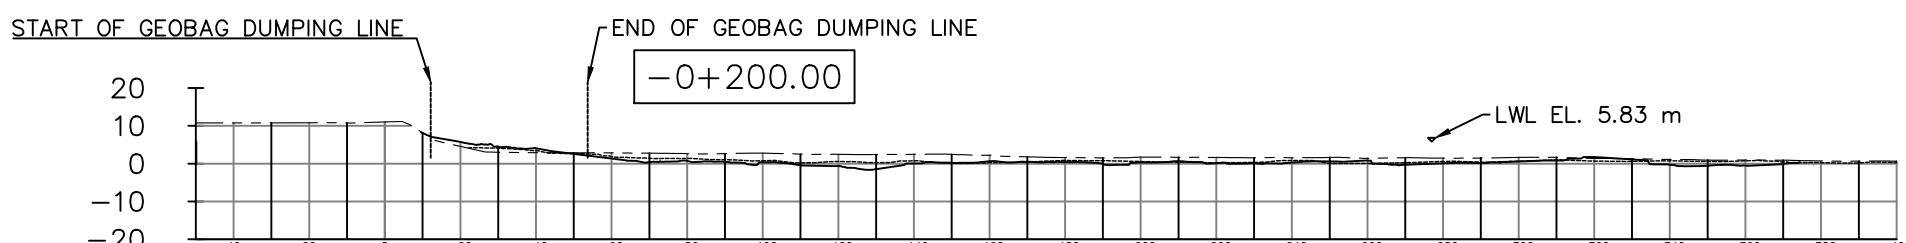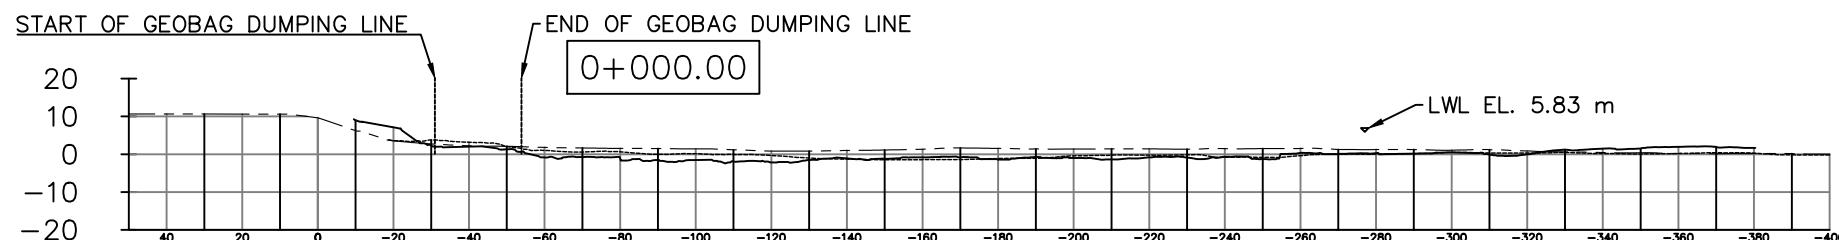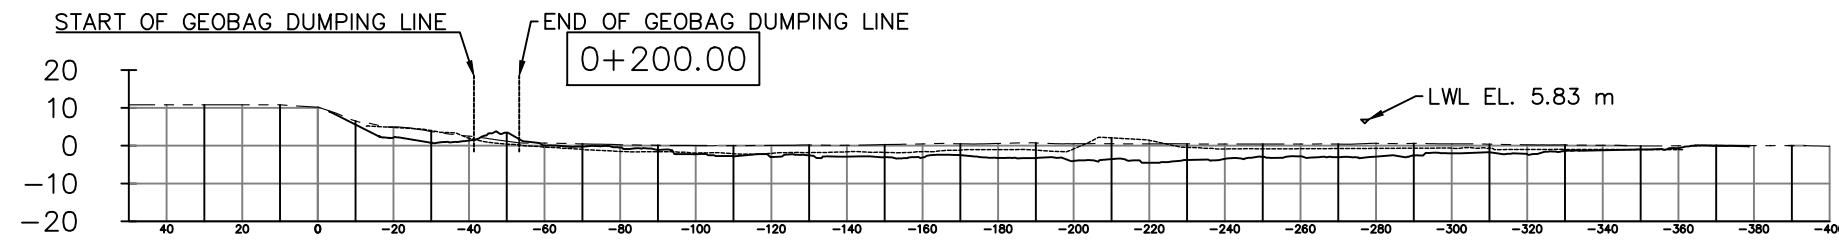

LEGENDS:

PRE-CONSTRUCTION SURVEY -----

MAY AS-BUILT SURVEY -----

JULY AS-BUILT SURVEY -----

This drawing is confidential and shall only be used for the purposes of this project.				THE SIGNING OF THIS TITLE BLOCK CONFIRMS THE DESIGN AND DRAFTING OF THIS PROJECT HAVE BEEN PREPARED AND CHECKED				SCALES:  AS SHOWN IN THE DRAWING	CLIENT:    BANGLADESH WATER DEVELOPMENT BOARD	CONSULTANT   northwest hydraulic consultants 	FLOOD AND RIVERBANK EROSION RISK MANAGEMENT INVESTMENT PROGRAM				
				DESIGNED	MYA	CHECKED	GV				DRAWING NAME:				
				DRAWN	MYA	CHECKED	GV				SECTION KM 0+200 TO KM -0+560.19				
				APPROVED	KO	DATE					STATUS:	AS BUILT_JULY 2016		DRAWING NO:	FRERMIP-ISPMC-CHA-01
0	MYA	28.07.2016	FIRST DRAFT	KO	SHEET NO: 012										
No.	BY	DATE	DESCRIPTION	APPD											